C.S. # 1109

See notes in file

F.B. 48-4

1109 C.S. 170 FB# 43 Pgs. 4 & 5

Timber Survey for Webster Aug 17, 1929

Began at a ¾" pipe on W. of Sec 6

T 11 S R 6 W

2.62 +4°		0°20'	North	
2.32		0°25' R		
4.65 -7°		0°37'	"	
3.42 +8°		1°04' R	N 1°0' W	
3.70 +5°		0°40' R	North	
3.38 +13½°		0°37' L	N 1° E	
1.20 +12½°	160	1°17' R	N 30° W	
3.820 -7° +7°		2°½ R		
3.18 +20°		0°50' L	N 2½° E	
1.4 +3° +8°		0°22' R	N 1° W	
2.82 -20°		3°19' R	N 3°30' E	
8.02				

Rough Survey only

Stakes not set on line

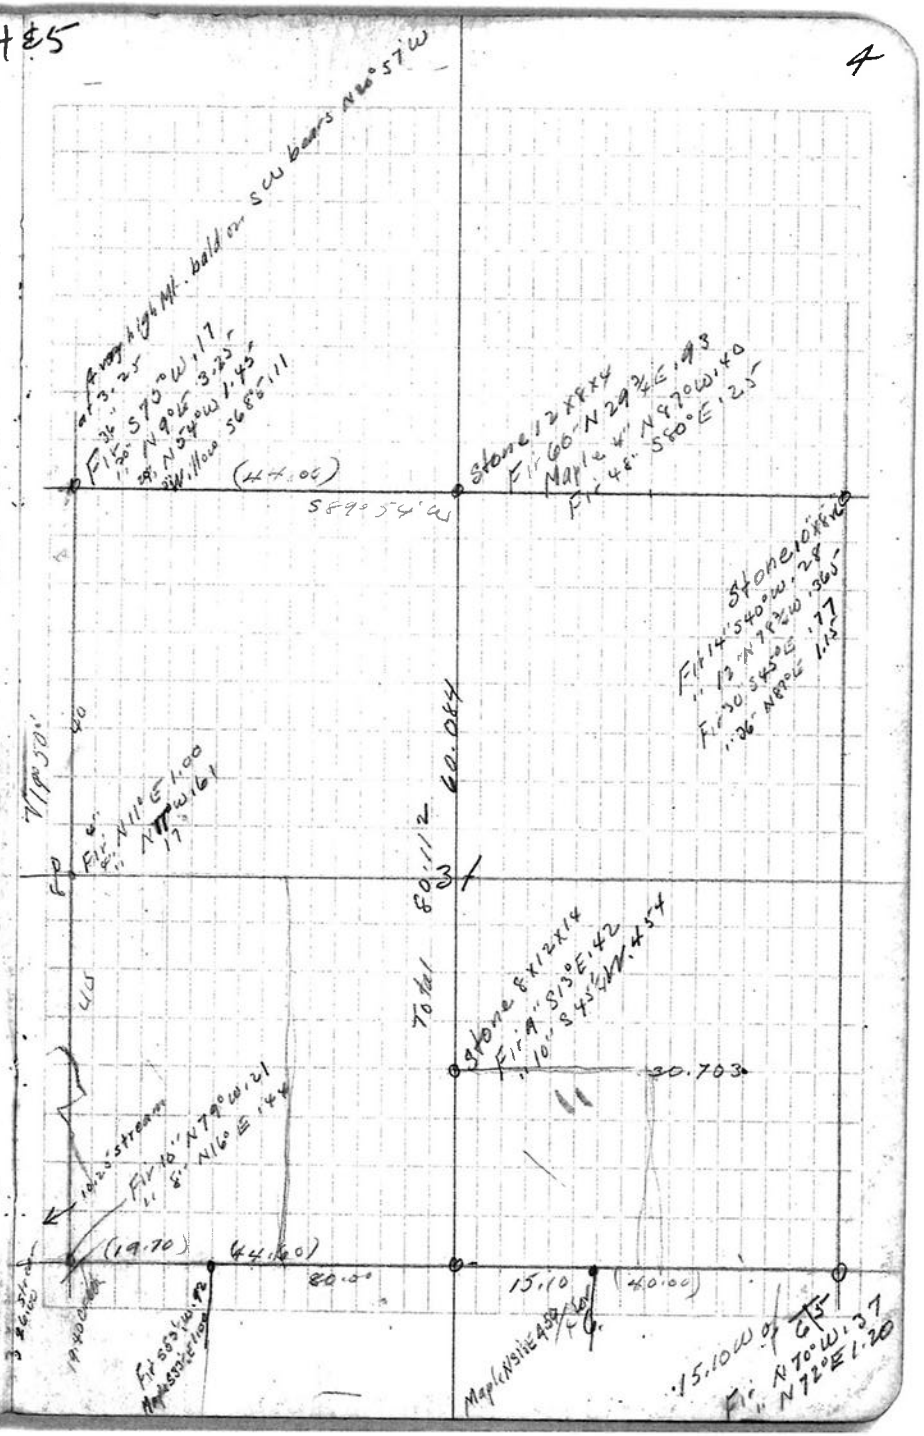

T. 11 S. R 6W

Set 3" stake + small stone

Maple 20" S 33½ E 1.00 Std

Fir 24" S 53½ W .92 Std.

Fir 7" S 55° E .20 to face

" 7" N 16° E .42 " "
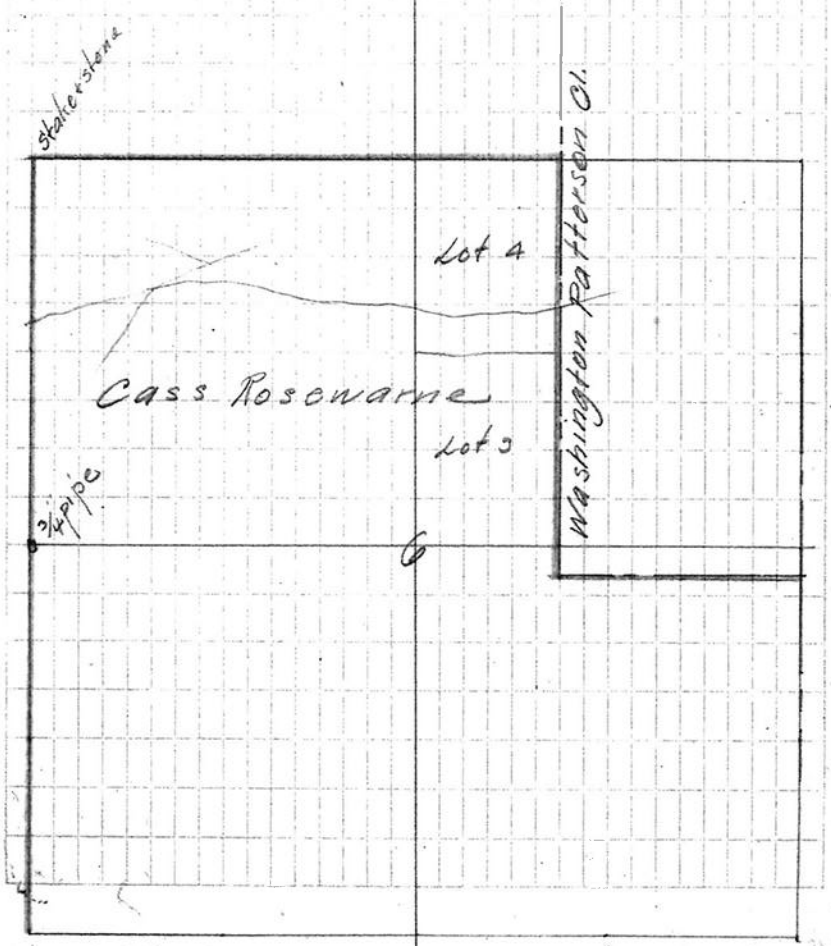
7.57		2°01'			
3.69		1°31'			
.40		128°30'