C.S. # 1113

See notes in file

F.B. 76-4

FB # 576

1113

Survey for V. L. Foote

Oct 1, 1929

Began at A. 90°02' N. int ang from line N.

15.000			.024 N
5.000	West		.032
5.000			.040
4.400			.047
2.732			.051
4.640	36.772		.055
3.228	3.228	Set grub hoe	.083 E
	40.000		.000
	-.083		.037 N
	39.917		.063 N
3.563		N 0°19 E	
-.008			
3.555			

hit .093 W of cor.

8.063

11°04'

1.340

= 1.314 S

.057 E

to iron bolt

Corrected 0.006 N
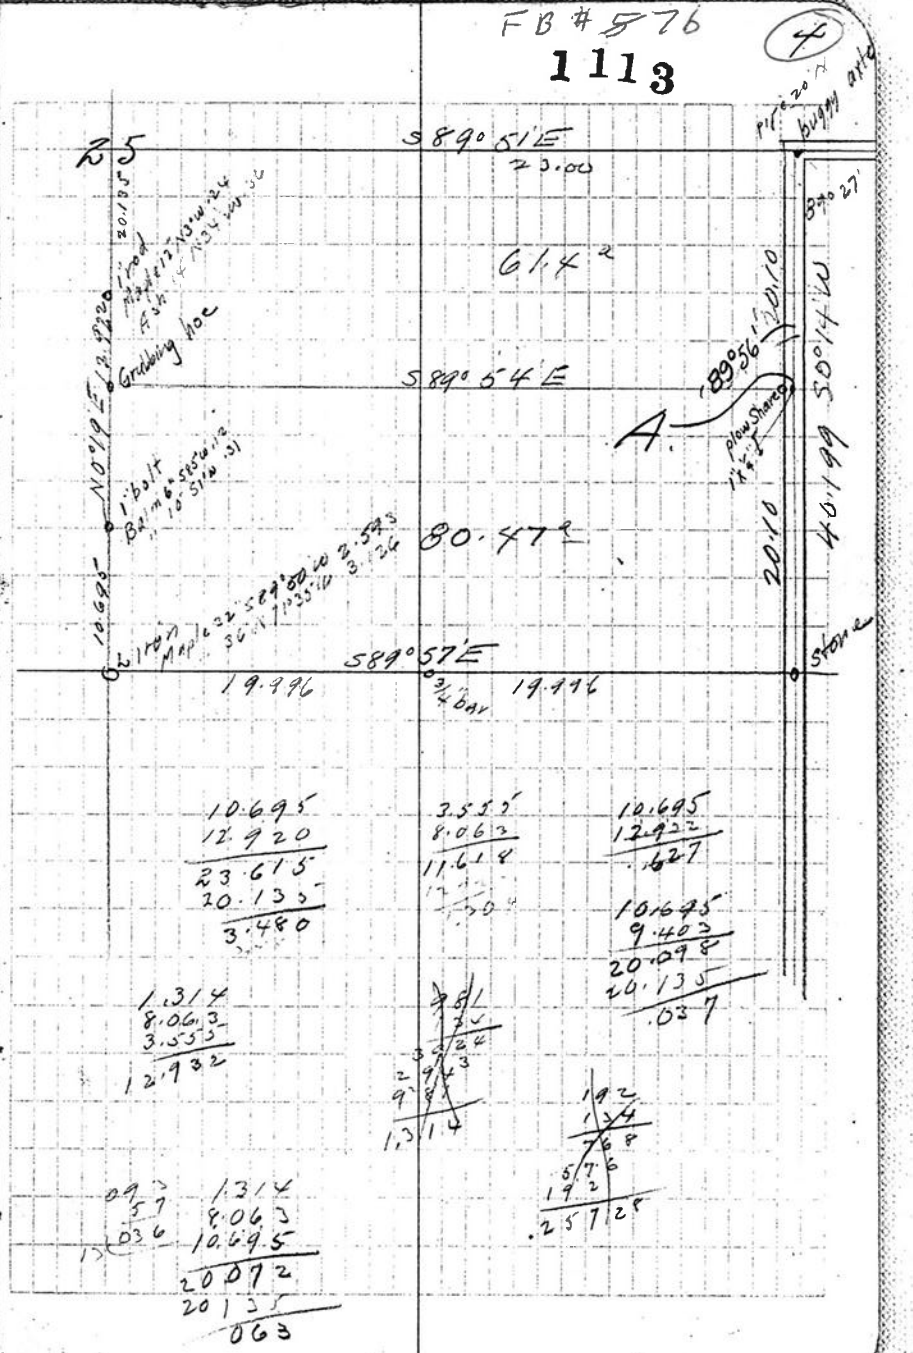
39.911