C.S. # 1115

Hardcopy 14-5 #3

also see notes in file

F. B. 76-5

FB # 76

1115

5

Survey for Ed. Bryan

Began at N.E Cor of Belchard.

7.424

South

15.340

△

2.860

△

.974

△

3.520

5.125

2.687

2.149

△

3.160

Fence

40.219

-.010

40.209

Hit-on-W side pipe

SE Cor of Q

90°03' L int angle

6.104

△

3.010

△

1.65

10.764

+.40 wpt. of Slough

+.25 ± Muddy

Creek .60 R

40.219

3 | 37.079

3.150

Measured from cor

+1.00 ± Muddy Cr "

N bank "

.20 R = R.B " "

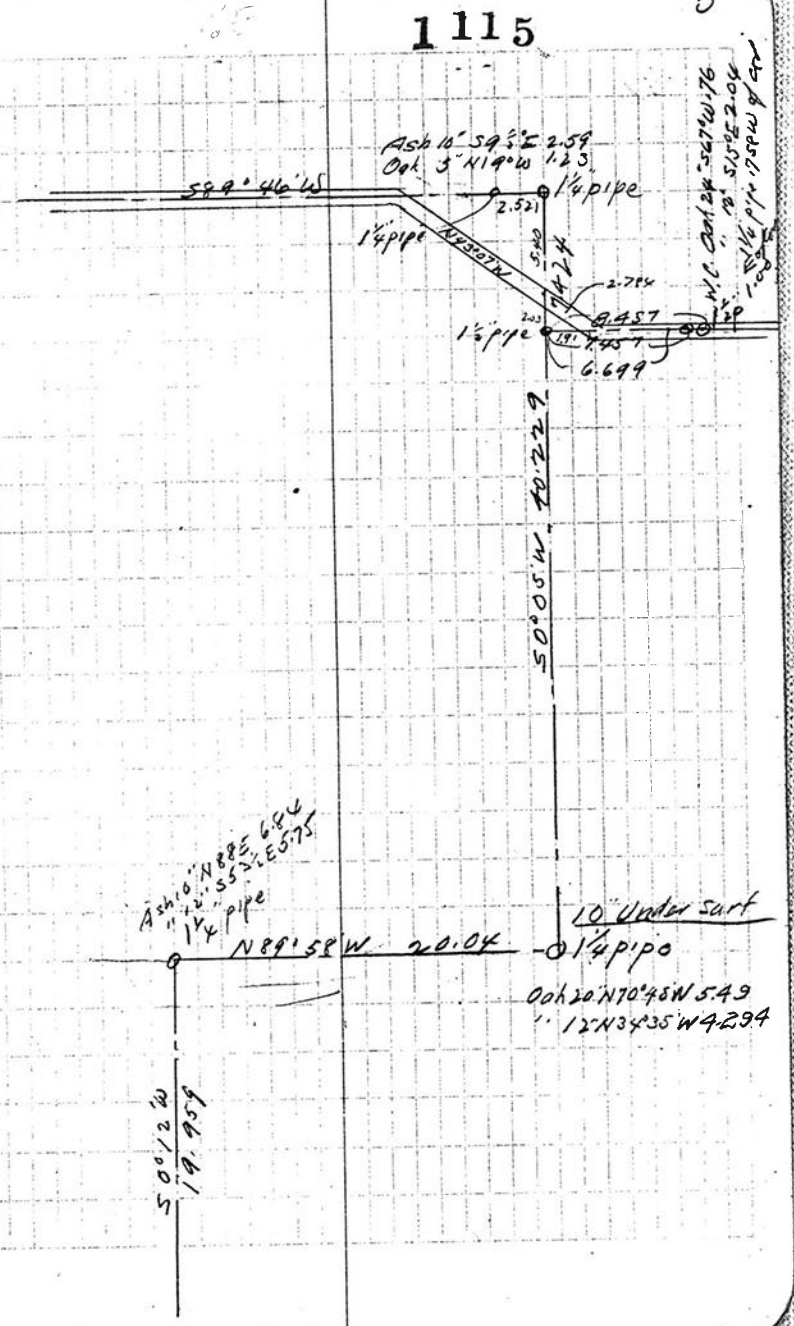

10:17.64

P. 740 Δ
5.000
1.544

20.048

pt. on W bank of Cr.

89°50'L

9.550
.675
Δ

Stake on N bank
+.60 ℄ creek