C.S. # 1116

Hardcopy 14-5 #6

also see notes in file

F. B. 76-8

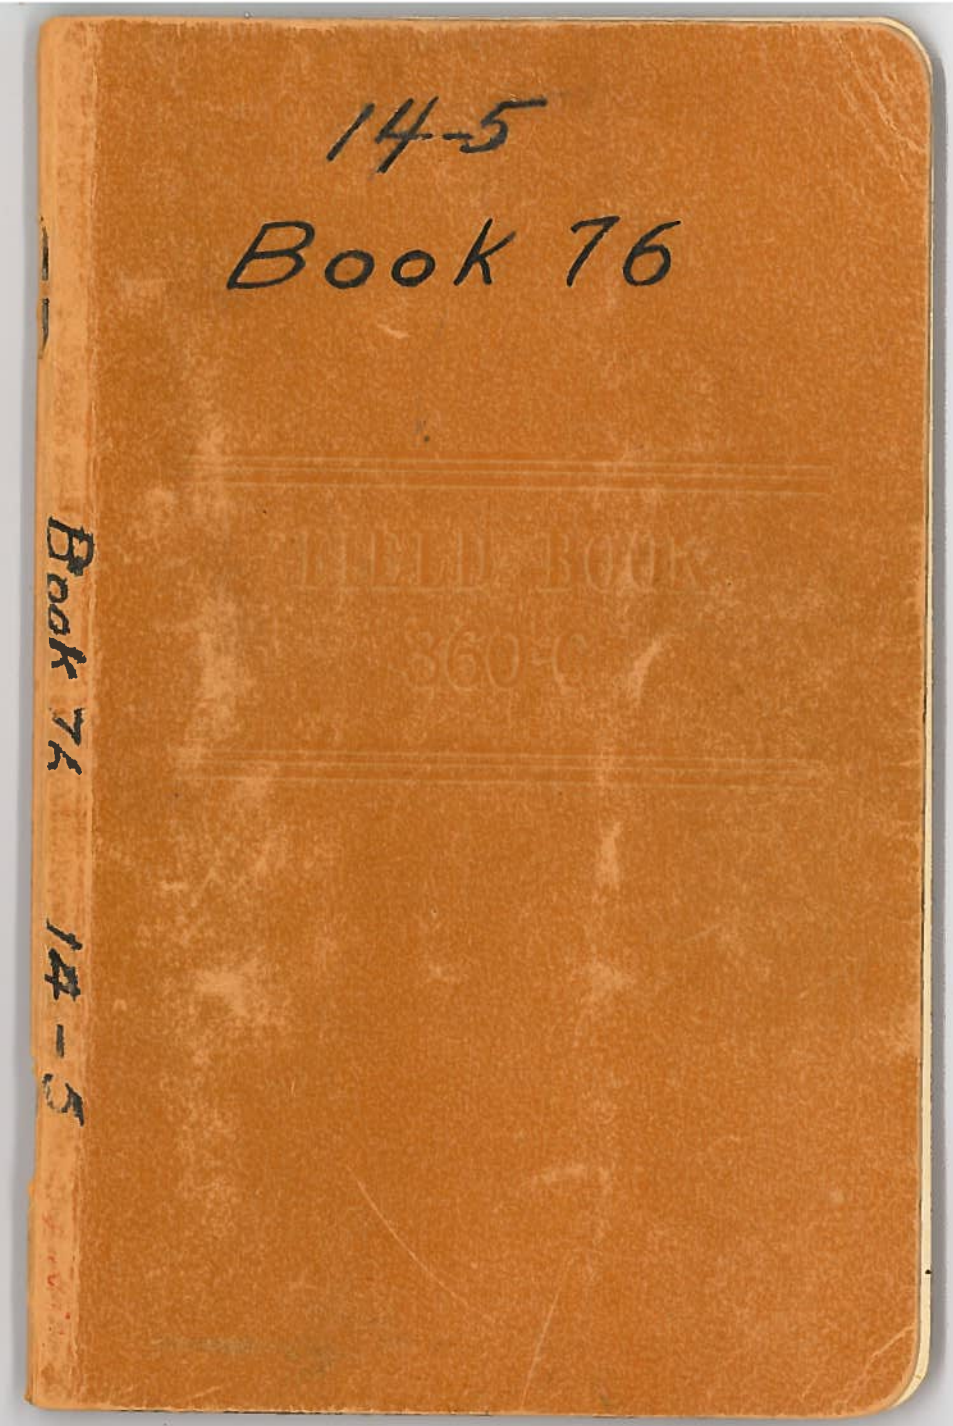
14-5
Book 76
FIELD BOOK
360-C
Book 76 14-5

1116

Began at N.E. Cor of Church Lot Bellfountain B.S. on point (Iron rod) W.

5°59½

+6°40'
R 4.27 2.411 N88°55'E

91°03'R

19°20'
3.163 3.112 S1°15'W 50°28'W

on fence line
N of Co. Road .303 W to ∠ Cor post

Set on S.E. Cor Ch. (Orrin Belknap)

2.136 R.136 S89°56'E

90°0'R

1.645 (2.195)
.550

S0°04'W

90°0'L

+4°40'
5.000 4.983 S89°56'E
+7'
3.205 3.181
.016 016
10.316

4.746 4.746
-2°
5.000 4.995 (4.673) S89°56'E
+4°29'
4.946 4.932

+2½° 5.000	4.995		
4.8 +6° 22	4.796		
4.875	4.875		
.030	.030	14.696	
E		91°05'R	Cemetery line
-5° 1.417	1.411		S1°09'W
△		N.W. cor orig. Cemetery	
+6° 1.625	1.616	From NW cor of "	
△			
+4° 1.574	1.570	E. side of ½ ac	

Back to E

-3½° 3.920	3.913		
-8° 5.000	4.951		
5 0 -6° 5	5.037	13.901	
△			
-4½° 5.000	4.985		
5.000	5.000		
5.000	5.000		
5.000	5.000		
5.000	5.000		
1.044	1.044	26.029	
		89°31'R	
1.3.270	13.270		

N. W. Cor Noble Cl.

10.316
14.673
14.696
39.685
13.901
53 586
26.029
79.615

lot 4"X4" Oak Stake in place
" to N.W. of ½ ac Set ½" pipe

3.485
1.616
5.101

90°0'R -3° 5.055 Line fence Cor

16.228	16.228		N		
&					
5.000	5.000				
5.000 +2'	4.993				
5.000 +10'	4.924	19.909			
4.000 +16'	3.845				
1.160 +8'	1.147				
		36.137			

Stone 6'x8'x24" 004 W of line
90°02' line W

36.137	36.137
16.228	13.270
15.909	49.407