C.S. # 1117

See notes in file

F.B. 70-3

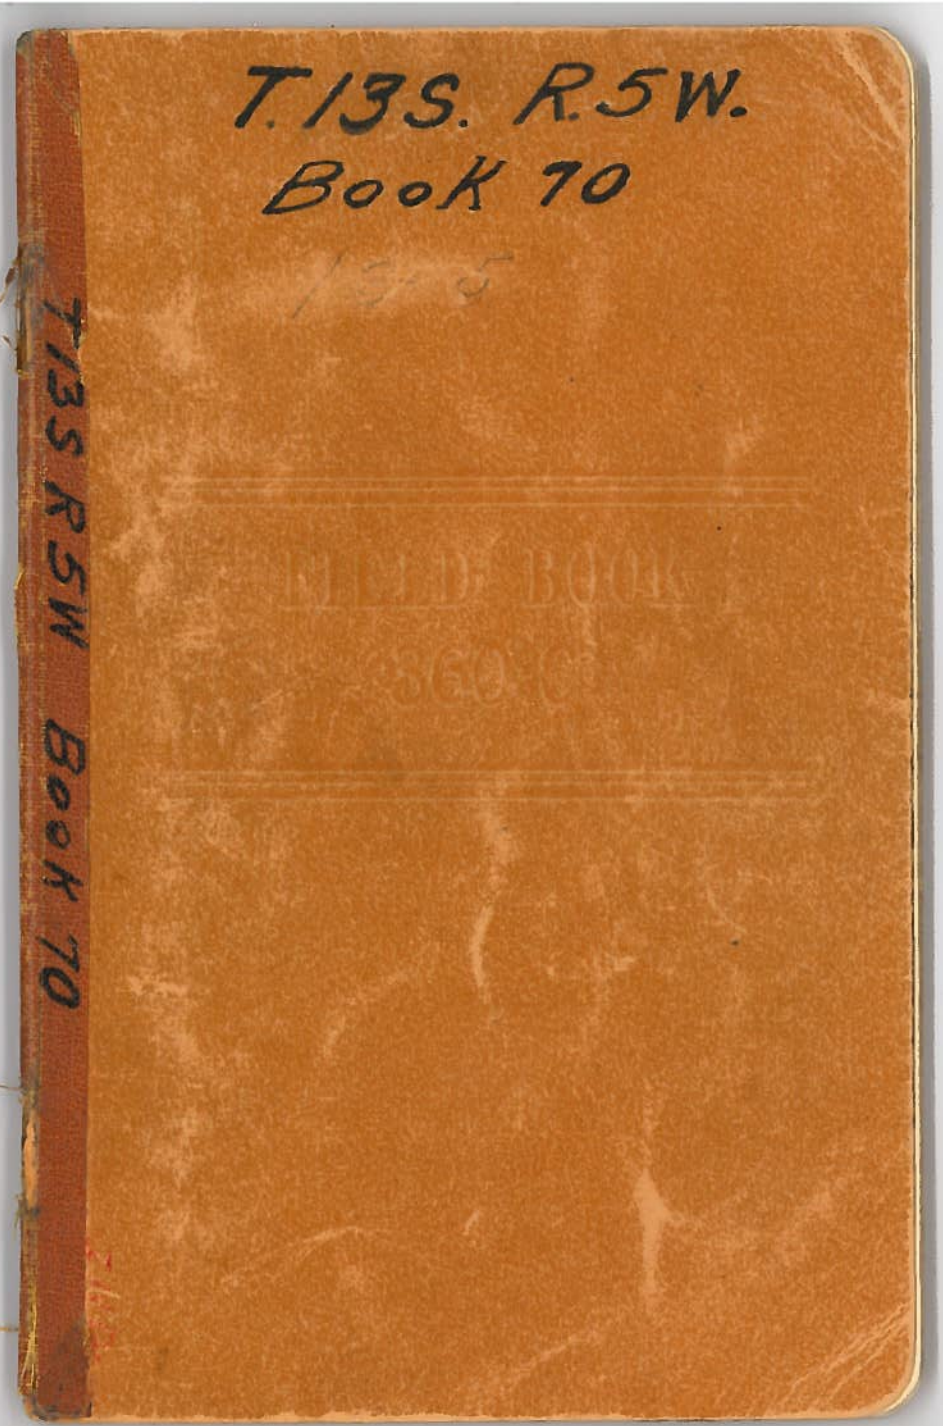
T. 13S. R. 5W.
Book 70
FIELD BOOK
T13S R5W Book 70

Survey for Bates & Pearden

Began at A.

6970
5.000 -6°30'
5.000 -4°30'
5.000 4°10'
5.000 -7°20'
5.000
10.016
4.947
6.000
4.945
3.370

East .005 .008 .012 .015

Set ½" pipe
+ .0235 .384 W

18.262
464
17.798

N.T. 338 N of cor
303
.035

1.640'
19.675'
= 19.019 N
7°10' R
Set ½" pipe

~~Ash 16" S 88° E .430.72~~
53
Ash 16" N20°E 87

18.182
66 / 1200
66
540
528
120
66
540

Corr. 0.025

18.182
17.798
0.384

9.6667
19.675
+83335
676669
580002
870003
9.6667
190192

1117

Beg. at pipe on S. of Muddy cr. — S 17.00 to S.W. cor 0.52 — E to E line lot 8 — S to SE cor said lot — W 1200' N to pt due W. of beg — E to E cr — along E or to pt N of beg — S to beg.

El. Herbert Cl.

Stake

John Pearden Cl.

Oak 24" N 24° E 7.0'
Ash 8" N 16° W 6.4'

A

N 0°24' E 37.96'
N 10°12' W 11.91'
.303
54.92 to gum 861
55.384
N 89°49' W 17.19
Lloyd Cl.
13.547
5256
S 89°50' E = 39.052
1¼ pipe in fnc
.12 S 9°50' E
gum bbl.
1¼ pipe
.12 S 89°50' E 20.0
N 84°29' E 30 from W
1¼ pipe in fnc
N 84°29' E
33.361
1¼ pipe by cor post
S 86°25' E 28.42
N 9°50' W 35.64
1¼ pipe
7" Iron W. 15" N. 46° E. 6.62 dug
15" S. 57¾° E. .827
"Stone 24" N 57° E .30
30' 531 E .838 to tree
11 S 75° 40' W .889 cm.

5.256
5.492
60.176

.19675
.83241
19675
177075
39350
98375
39350
4.976

89.49
75.10
14.39

"82.50"
2 small stones

Stone 2'E 2'S 12"
Ash 10" N 48° W 10" E

oak 20 S 76 W 270
" 18 N 75½ W

20
24
S. 89°56' W. 79.90
34.00

Field

Muddy

11.53

Set on point on π line

which is

2.067 from pt. 18.182 W. of rifle pbl to 1" pipe set for N.W. cor Prop
.873 West to pt on π line S.

100° 04' L

34918

to ⊕ cor post

78° 14' L intersecting to pt W

S 86° 45' E .873 ¾ rod

hit 17.35 ¾ pipe

180
100 04
79 56

rod is 7.590 E of 1½ pipe
at angle point on Hughes
S. line

2.067
18.182
.464
20.713

18.448
7.590
20858