C.S. # 1127

See notes in file

F.B. 52-1

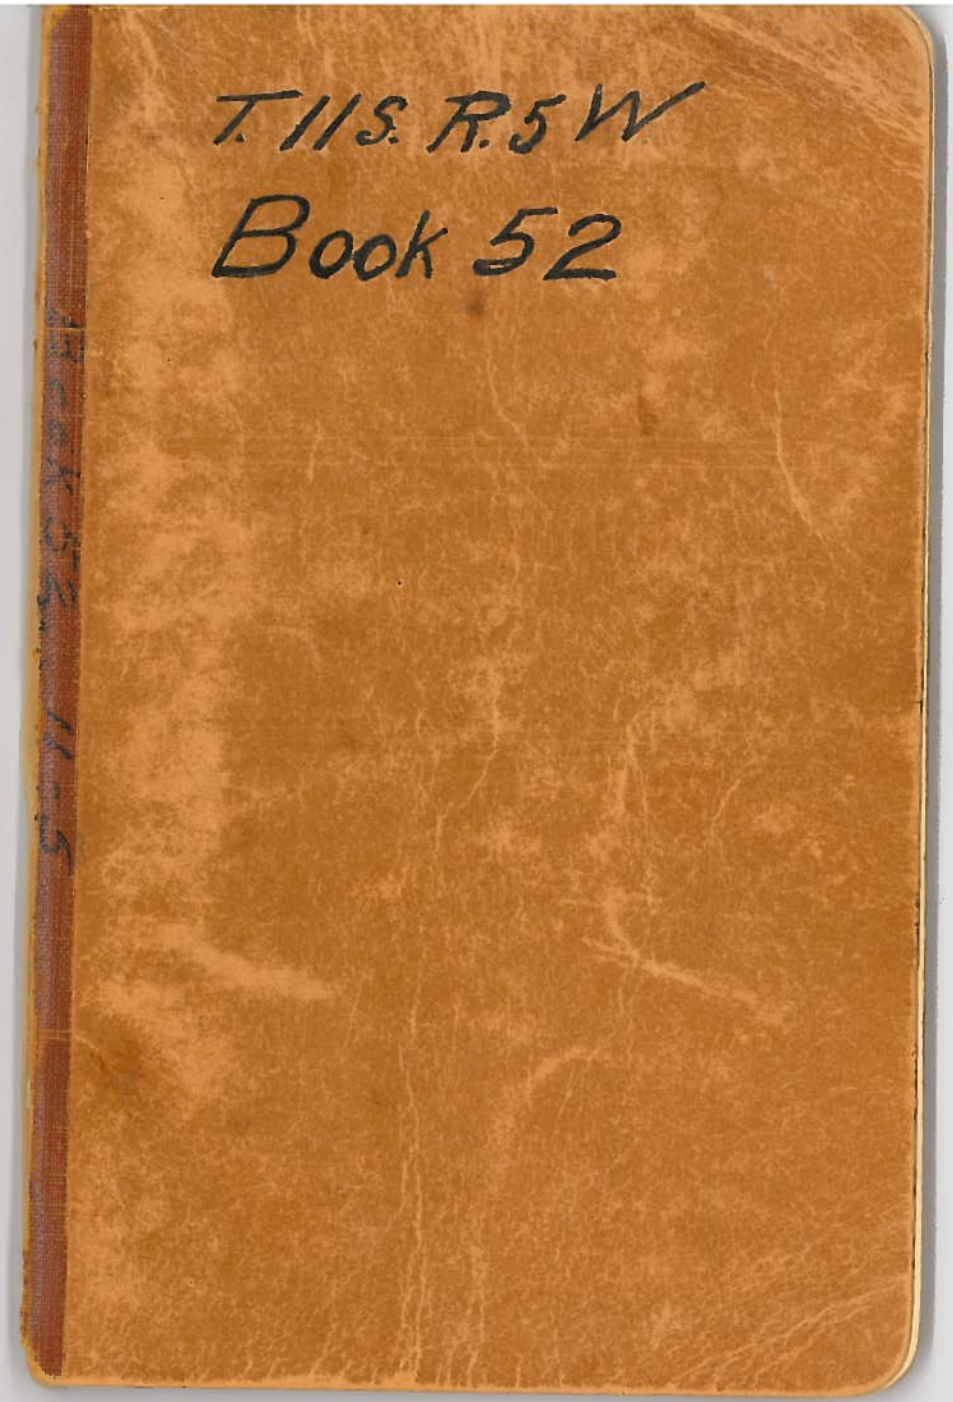
T. 11 S. R. 5 W
Book 52

C5 123 Sec 33 - 11 - 5
Sec 4 - 12 - 5

Survey for Ernest Wyatt.

Began at a conc. post on N.R.W of R.R. .424 N of N Rail

17.968 NE

Set .366 S.E of cor

96°05'L Correct 0°04'N = 96°02'L

21.760 +041 for dist on true line

hit .387 S of ¾ pipe 0°21'R on Bl. line to top N Bldg

89°47'L

true = 89°51'L

17.878 cor to cor

.487 to RR N rail

90°10'L down RR .010 N of S Rail

19.908

+046

19.954 True dist betw cors.

1127
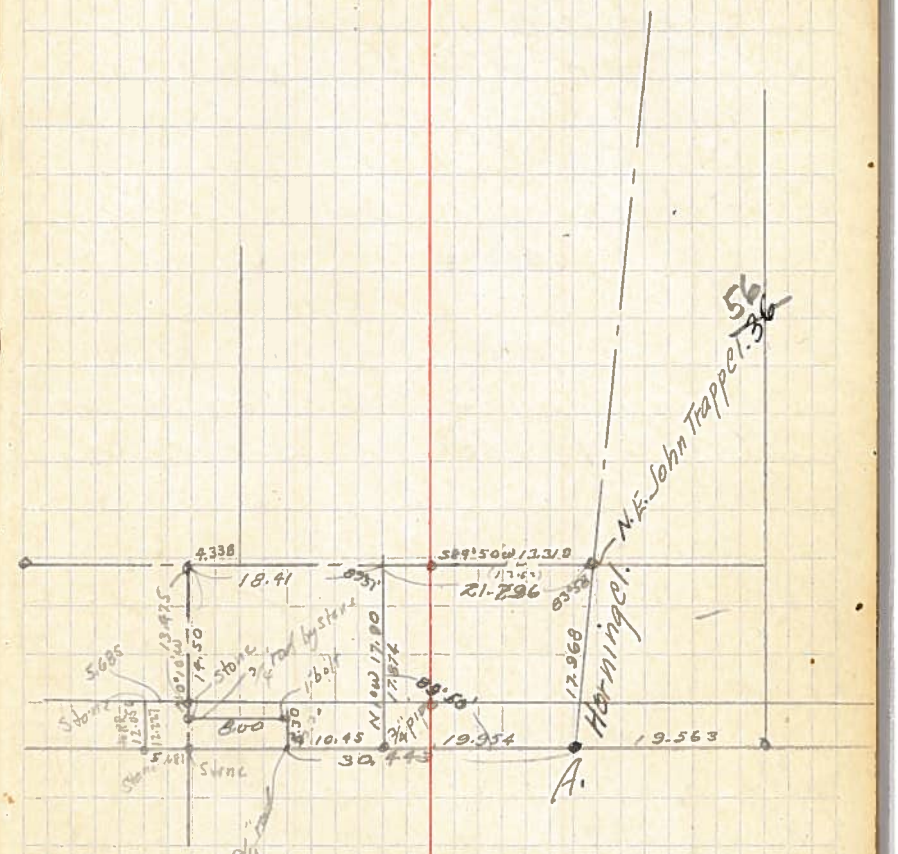
1