C.S. # 1130

See notes in file

F.B. 52-8

FB #52 Pgs 8, 11-13

C.S. 259 T11-5W

	61°32'L	+15° 1522 =	1.468 =	1.291W .690N	
				Begg at pt. .690N 1.291W	1406 8
0°0'	Begg .690				1.336
4.983	4.983		North		1.663
+5° 1.417	1.411		N 1°30 E		1.7587
+4½° 4.970	4955		N 2° E		2.083 2.076
+4½° 4.982	4.967		N 0°30 E		2.599 +10
+3½° 4.610	4.600		N 0°30 E		2.712
		0°16 R			2.698
+8°20' 2.953	2.921		North		
		0°0'		.013E	2.8911 2.875
+14° 3.934	3.817		N 0°20 W		3.148 3.123
9°30 0.967	.765	"	"		3.211 3.186
-10°30 4.984	4.778				3.526 3.499
-9° 3.510	3.468	"	"		3.754 3.722
-22° 2.077	1.926	38.791+69			3.880
		1°45 L	40.686	-.30 Creek	3848
+13°30' 1.240	1.205	39.996+690			3996
B.M. = Near E Sec 8		0°36 L		.037W	3963
+3° 1.760	1.747				
		2°0 L		.018W	4095
0°0' 2.696	2.696				
		0°18 R		.094W	4364
+5°30' 2.398	2.386			.012E	4.507
+1½° 1.800	1.730	0°06 R		.009E	4.611
+9½° 4.504	4.442				
		0°05 L		.007E	4692
+12° 3.010	2.944	0°0'	"	.004W	5.087
+23°30' 1.902	1.747	1.692			

Over to Page 11

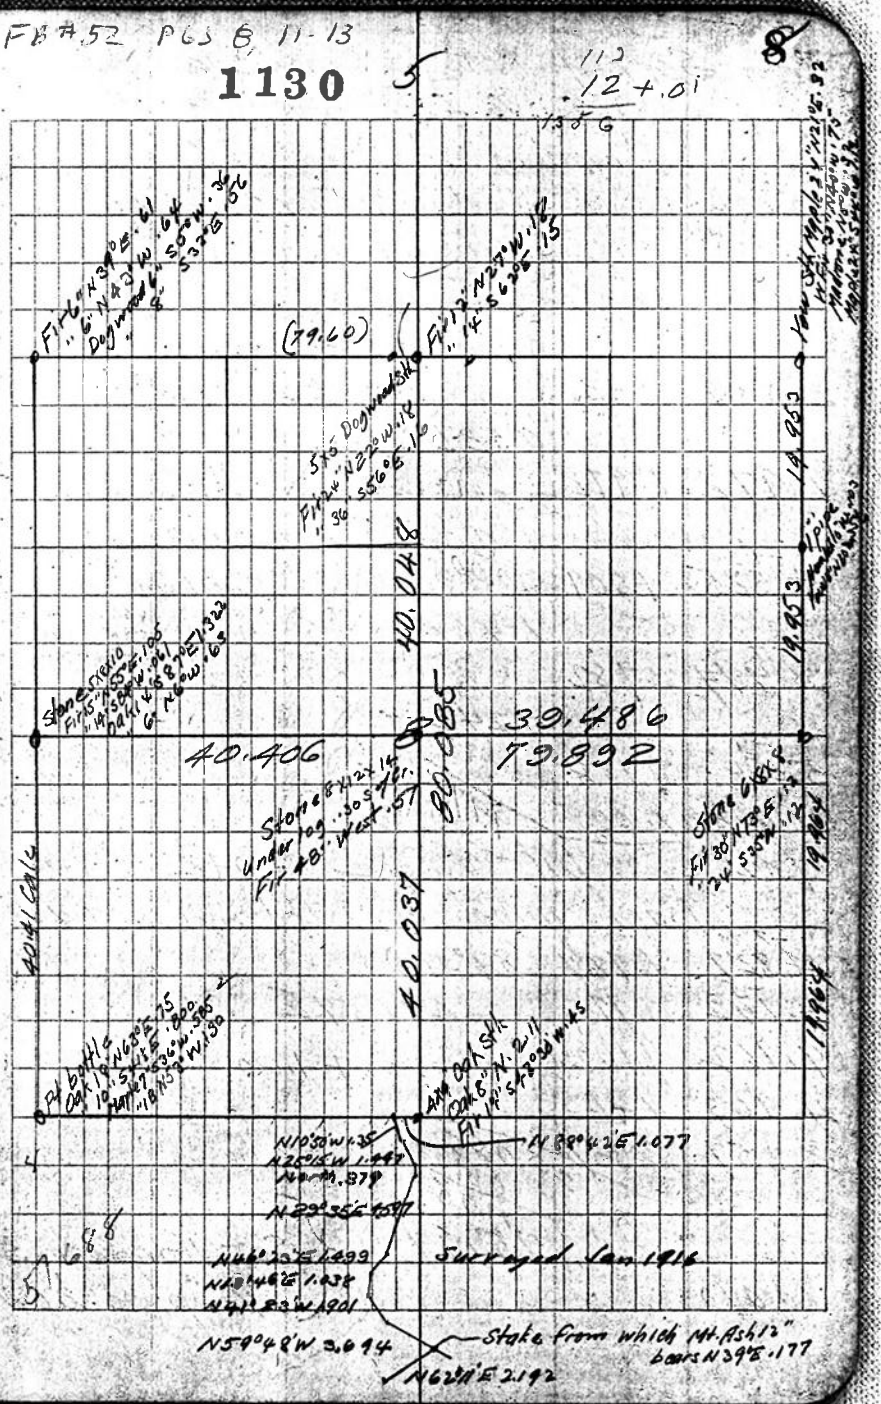

Continued from Pg 8

	17.692				
		0°22'L			
+15°35' 3.327	3.205	20.897			
		0°57'L		.020W	5.527
+4½° 3.360	3.350				
		0°0'		.055W	5.597
+7⅜ 5.040	5.002	"			5.922
+1°40'10" 2.059	1.996				
		0°0'			6.052
+3½° 4.137	4.129				
		0°08'R			6.321
-5° 1.744	1.737	0°08'R		.004E	6.430
-12°45' 1.748	1.706	17.920	R. North	.004E	6.537
-4½° 2.345	.300 2.338	82°38'		.2305	
		88°33'R			
-17°40' 4.630	.112 4.412	5°55'R		4.410E	Long trees.
		18.33½	East		Yuma Fix 24 "N22°W18
	Set 5"x5" Dogwood Stake				" 36" S36°E16
Sun -9°20'	B.	90°R = 0°0'	Az.		
2.550	2.517				7625 7755
-10°32' 2.598	2.554			-1.075	8295 8405
		0°25'R		+.30 Creek	.877
+5-½° 3.055	3.040				
		0°19'L		.0225	.992 1.0045
+9°30' 4.380	4.318				
		1°10'L		.024N	1.210 1.222 5
+11°15' 2.855	2.800	15.229			
				.057N	1.393 1.405 5

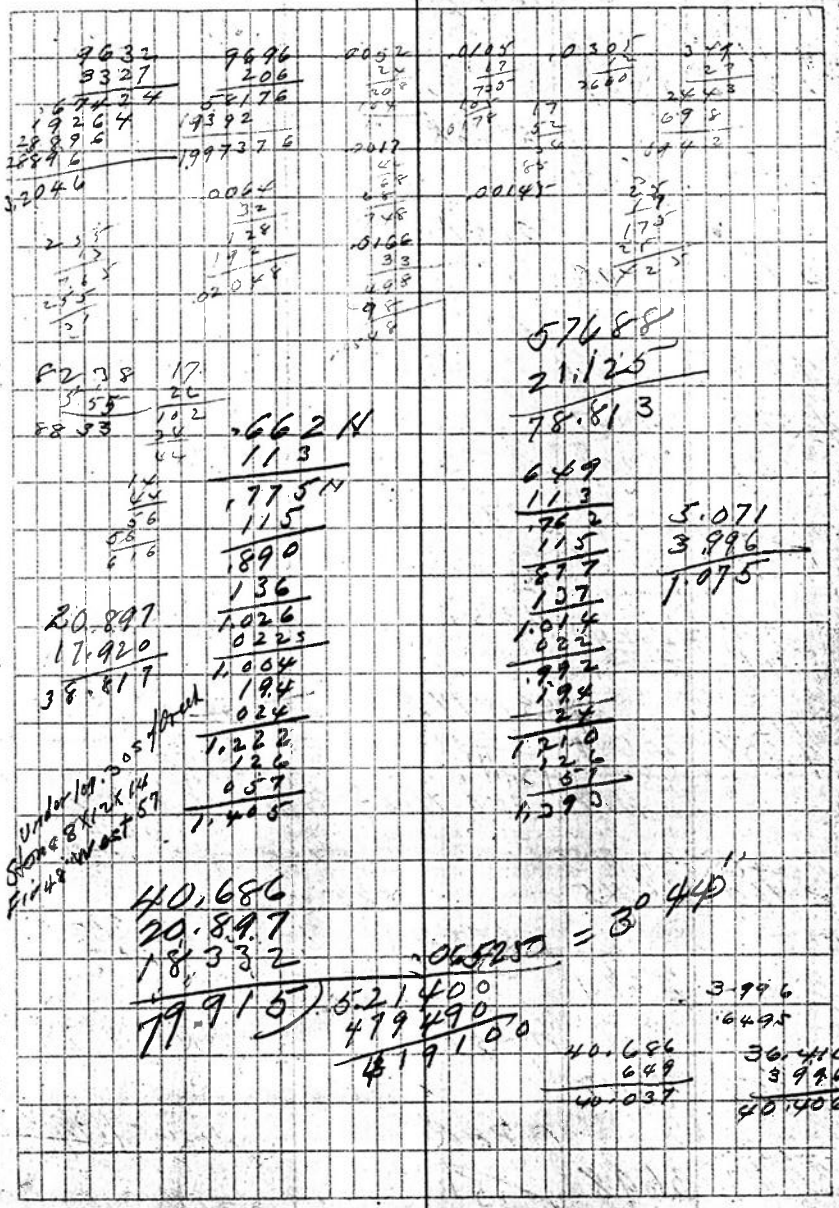

	15.229				
+15°30'		0°03'L			
4.971	4.789			.005N	1.613 1.624
1.228	1.209				
		5°46'R		.001N	1.668 1.679
−6°	.996				
1.007	+.001				
		0°04'R		.104S	1.609 1.620 S
−8°45'					
4.140	4.092				
		0°6'		.005S	1.788 1.799 S
−13°					1.821 1.832 S
+13°	.724	0°0'			
−15°					2.016 2.028 S
4.600	4.347	0°0'			
+31°55'					
2.027	1.721				2.093 2.106 S
		0°21'L			
+27°40'		37.9'L			
4.592	4.067				2.301 2.314
		4°56'R		.025N	
+21°15'	2.240				
2.413	2.249				2709 2.422
		30°17'R		.193S	
+15°35'	3.999			2.3355	
4.808	4.634				
	43.411	hit .050 N of Stone 1/40			.649 V
		Back to Stake			.662 S
+6°			589°W		
2.760	2.745				526 V
		2°57'R			539 S
+8°20'	2.770				
2.804	2.774				
		0°35'R		.143N	545 V 558 S
+7°10'					
4.050	4.018		589°W		
		0°22'R		.041N	406 V 419 S
+10°40'					
3.763	3.698			.024N	
	13.251				

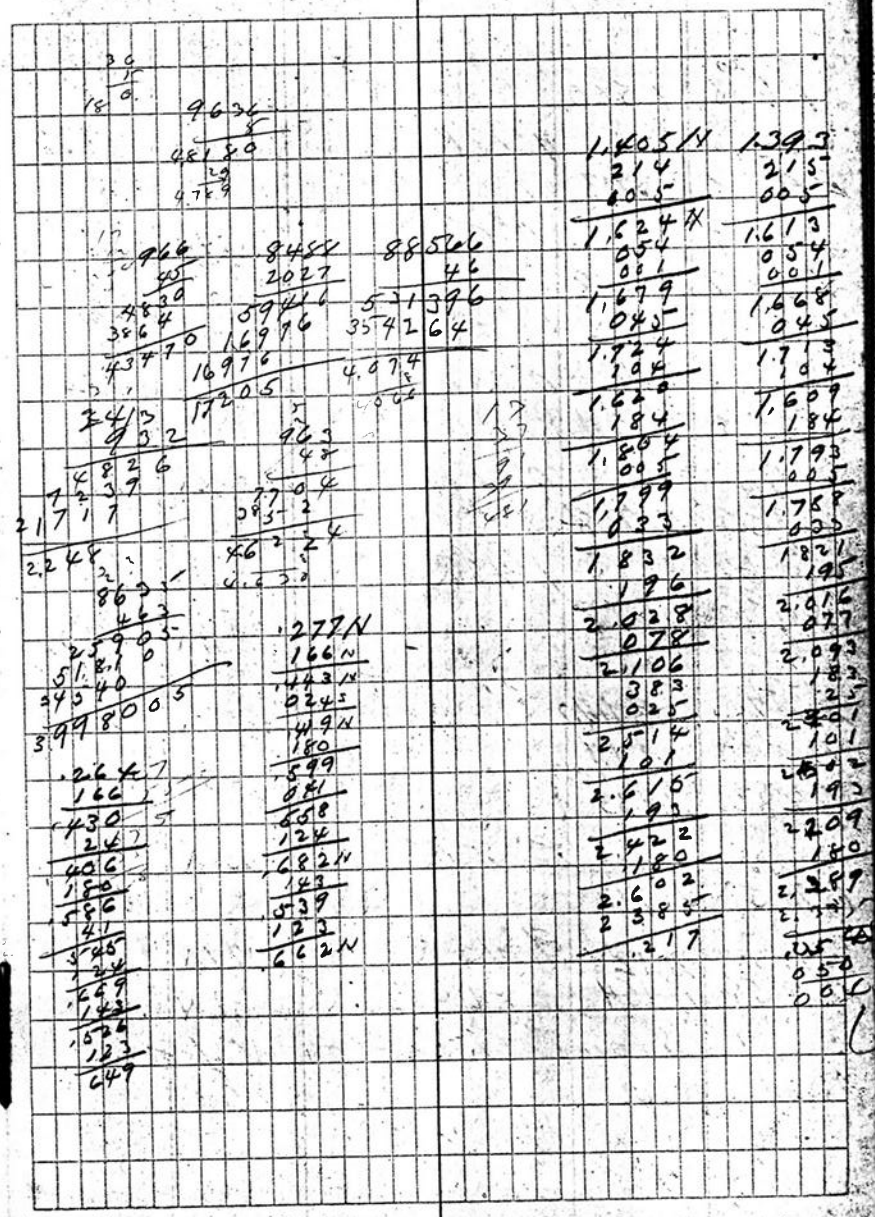

	13.231				.264 V
+15°20'		0°0'			.277 S
1.638	1.580				
		1°18'R	+.50	small Cr.	.193 V
+11°					.206 S
2.428	2.383				
		0°0'		.054N	.140 V
+9°					.153 S
1.527	1.508	"			.072
.743	.711				.085 V
+15°10'					.040 S
		0°35'R			.055 S
+71°					
2.653	2.604				
+14°10'		0°30'R		.026N	.051 V
3.185	3.088				.048 N
-5½°		1°45'R		.027N	.163 V
1.686	1.678				.160 N
				.051N	.188 V
		"	+1.30	Creek	.184 N
-7°20'					
2.472	2.470	"	N88°W	.075N	.224 V
+17°40'					.220 N
1.550	1.477	"	N88°W	.045N	.247 V
+2°20'					.242 N
1.832	1.833				
		5°38'R		.056N	.273 V
-16°00'					.268 N
1.785	1.715				
		9°45'R		.079N	.271 V
-16°50'					.266 N
2.256	2.128			.366N	
	2.154				
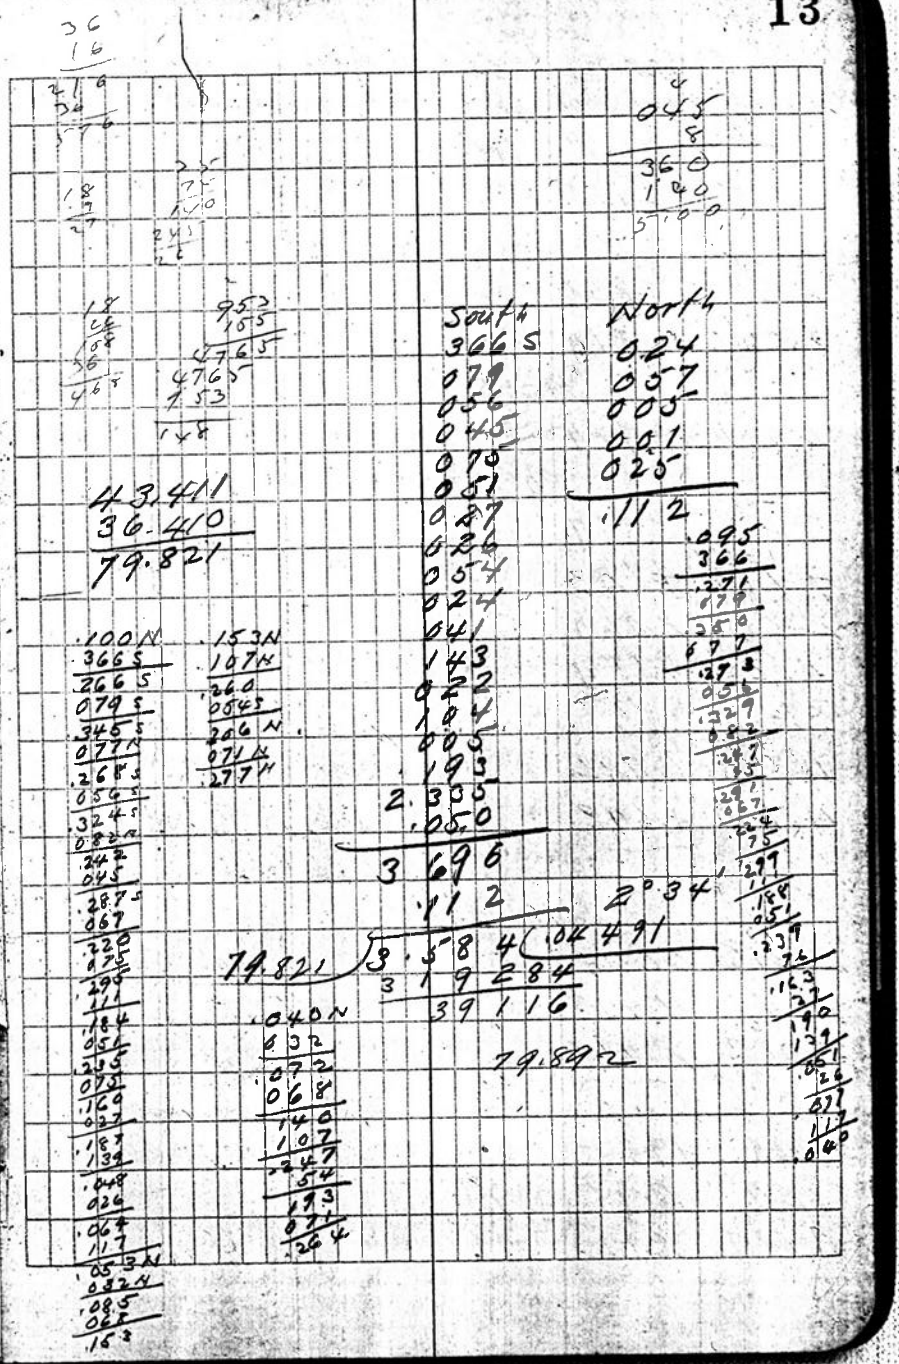
Stone 36.410 4 cor on W of 8