C.S. # 1140

Hardcopy 12-6 # 28

also see notes in file

F. B.

Cl. 58-12-6

C.S. #130.

For Henry Vosberg 1-14-48

1140

LINE DATE PARTY

PROJECT

KILHAM FORM P-172 1-9071

Δ_8	Int ∠ Lt	92°07	N to W on Mary's Peak	top of lookout	
	126± S of Creek ℄		running SE×E	—	215.08	215.08.
℄ 7					
			-4°31′	175.33	174.78
Δ_6			-3°43′	410.00	399.16.
Δ_5			+0°20′	268.35′	268.34.
set Axle	∠ Lt	89°54′	W to S on 8.71 offset W.		
	1.40 acres .71 offset W on ℄				
fd 1"P	NE cor 40 ac				
			+1°10′	362.26	362.18.
Δ_4	∠ Lt	0°42′	(N) set ¾"p 30"long over stone Pt. cor.		
	Int ∠ Rt 89°39′	- 0.89′	—	283.20	283.20.
Δ_3	—				
	Int ∠ Rt 89°39′	- 0.69′ (N) and 1.34 E on ℄ set 1"P of 10 ac	—	147.83	147.83.
Δ_2	—				
	Int ∠ Rt 89°39′	- 0.58′ (N) W. on ℄ 262.83 set Axle	+2°23′	159.02	158.88.
Δ_1	—				
			-3°32	400.00	399.29.
fd ¾"P	—				
bent ℄ (Straightened it)			+3°11′	233.07	232.71.
1" rod	— Easterly				
Pt. SW cor Evergreen School property near					

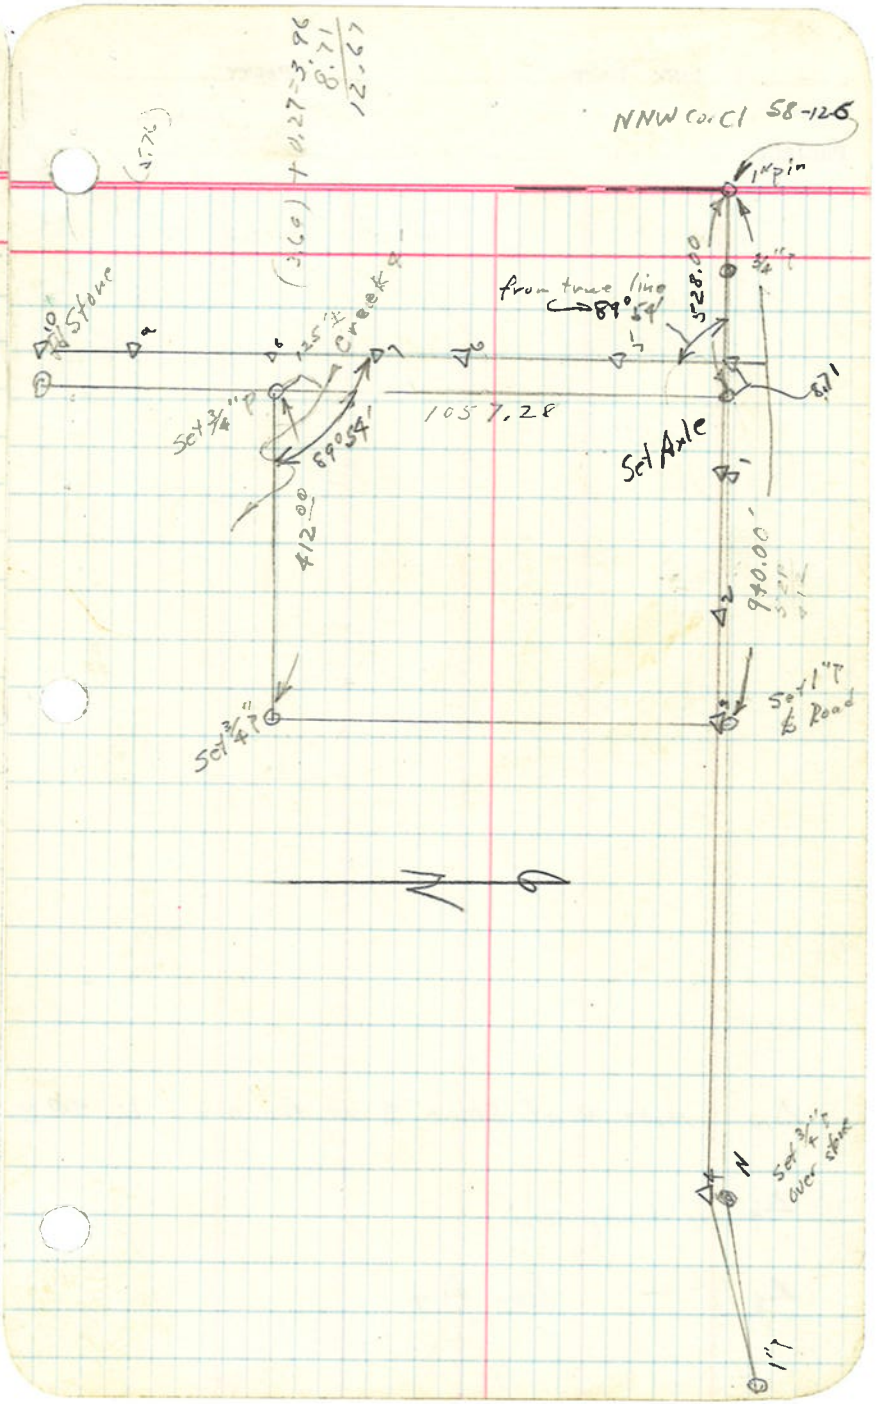

LINE DATE PARTY

PROJECT

KILHAM FORM 2-172 1-9071

Δ_{10} 14,89 W of Stone 2 at the cor Li 90 ac

Δ_9 top of ridge E-W

Δ_8 – from Δ_7