1142

1142

COUNTY SURVEY NO. ~~147~~ 1142

10 - 6

15, 16, 21 & 22

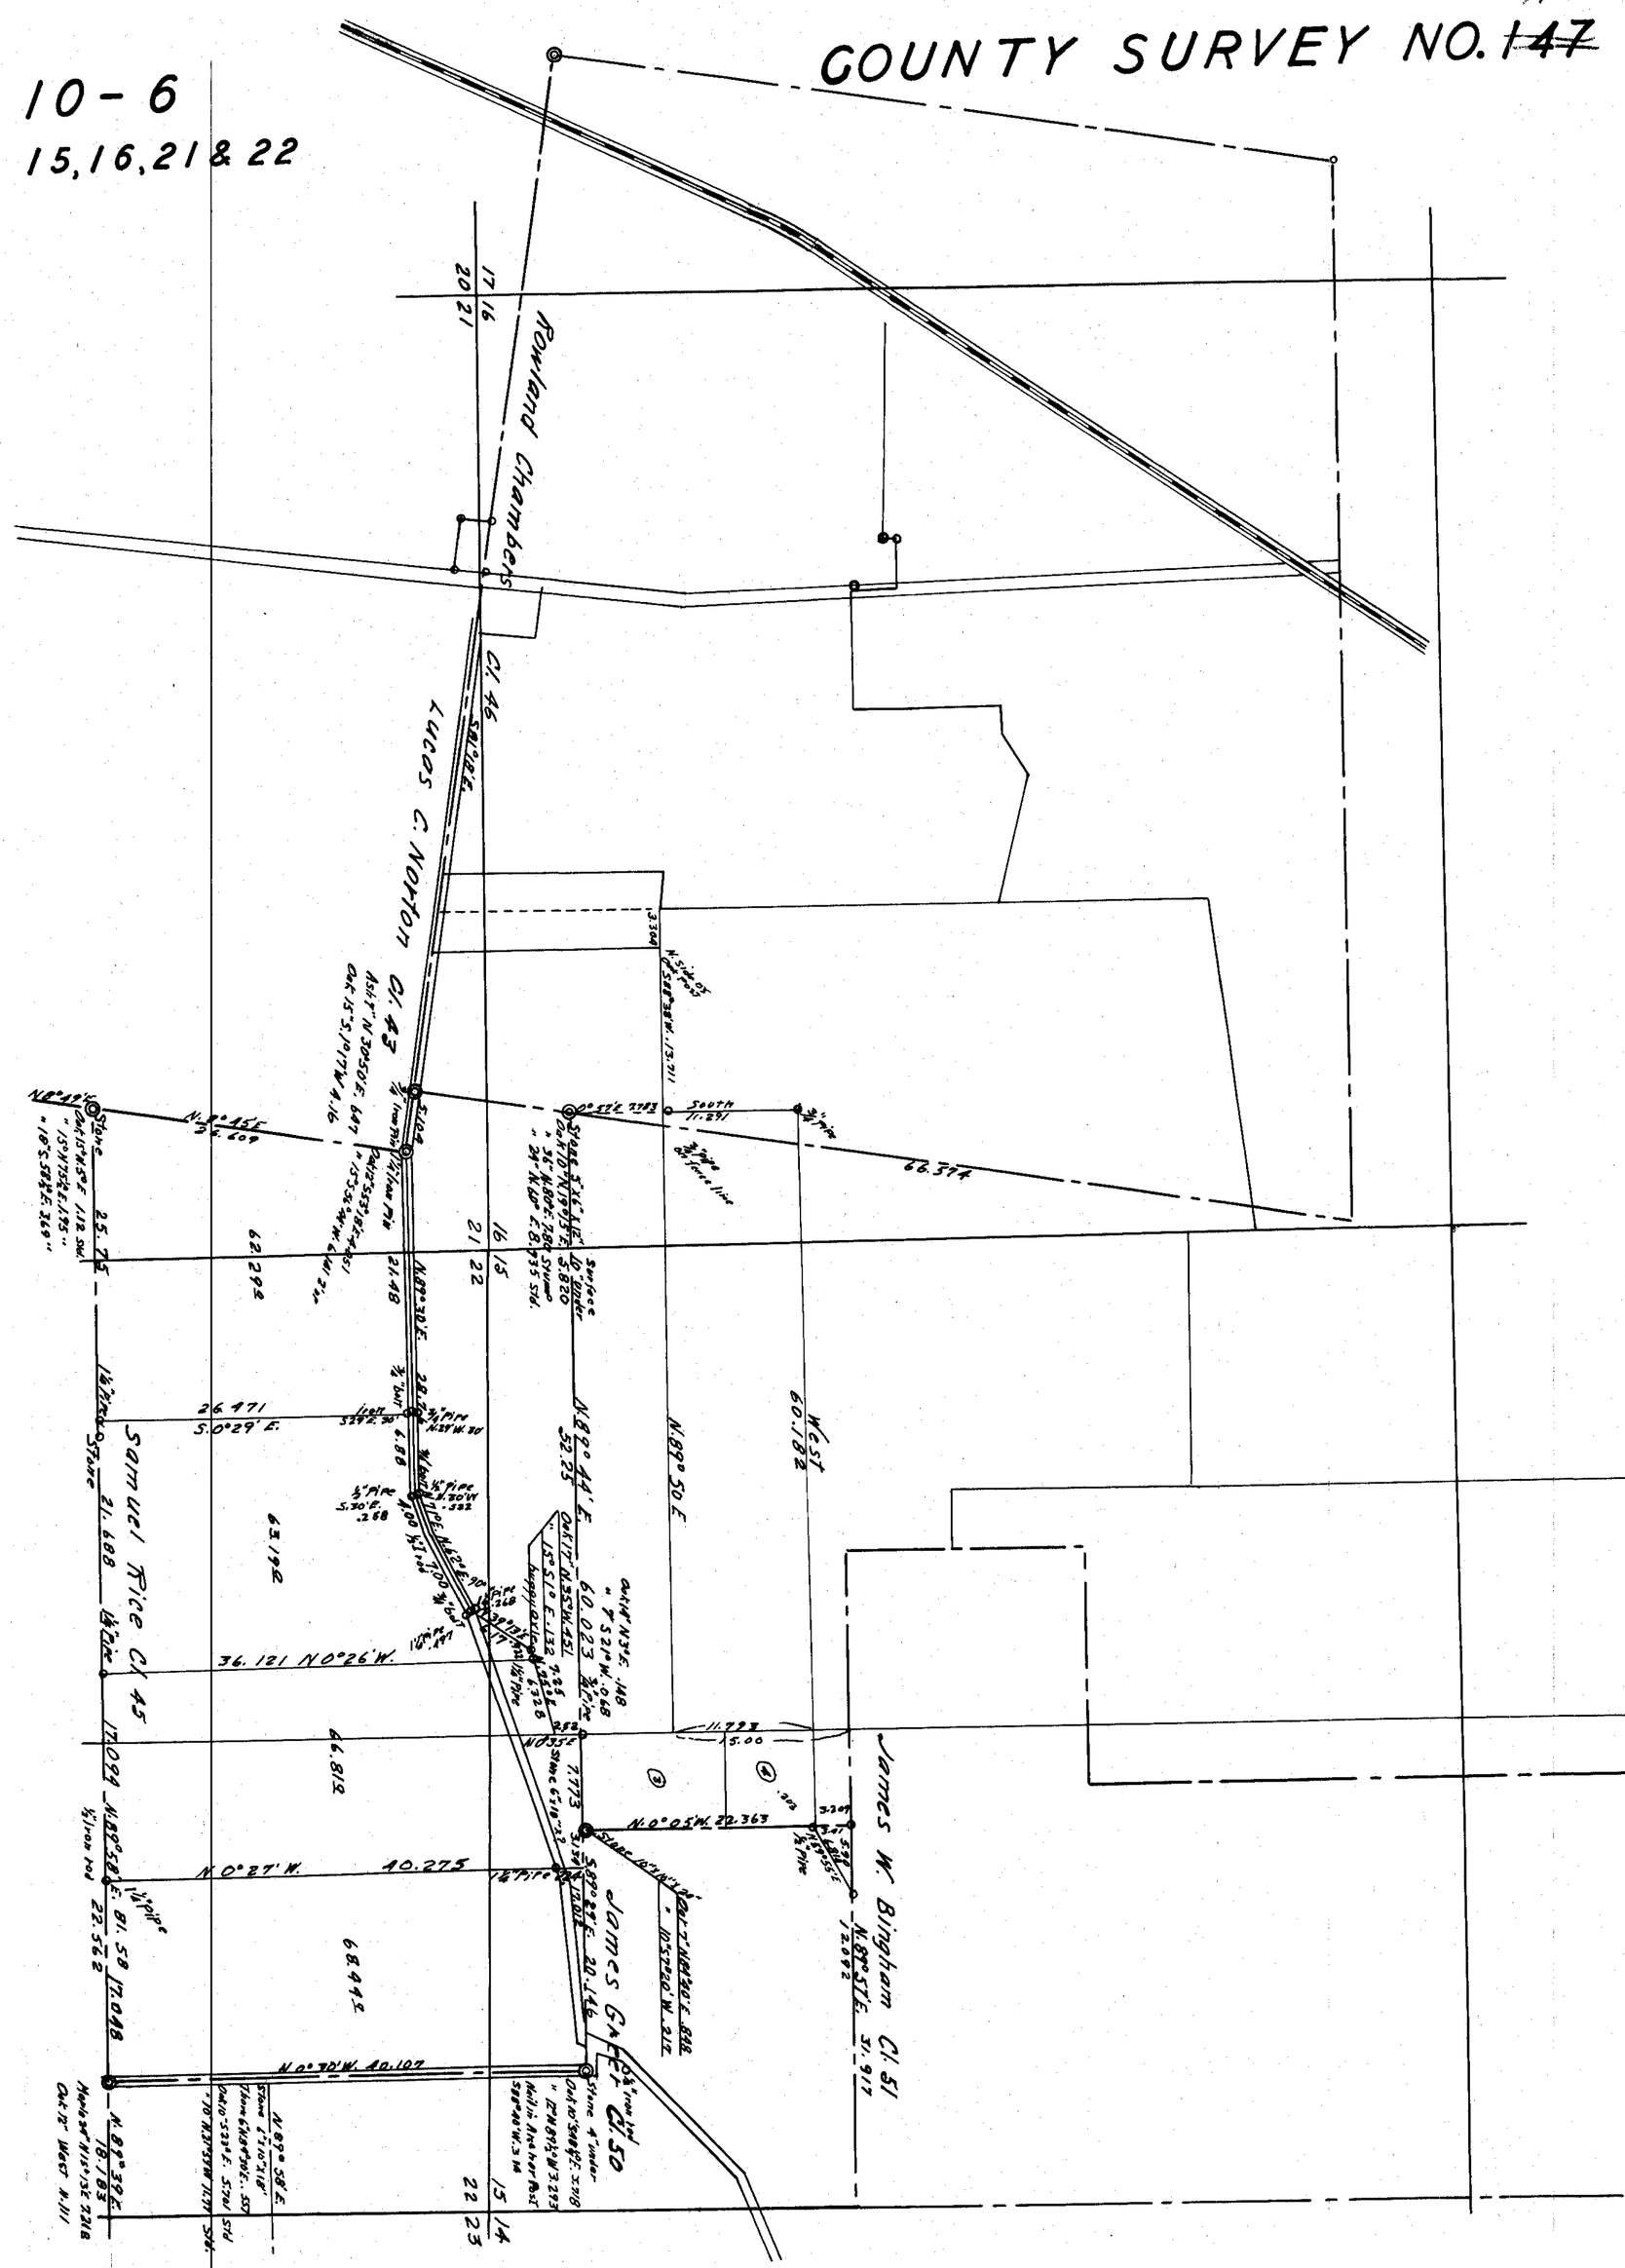
Rowland Chambers
Cl. 46
Lucas C. Norton Cl. 43
Cl. 50
James W. Bingham Cl. 51
James Gaff
Samuel Rice Cl. 45
N.89° 50 E.
N.89° 44' E. 52.25
N.0° 27' W. 40.275
N.0° 30' E. 28.2
N.0° 30' W. 40.107
N.89° 58' E. 18.783
S.0° 29' E.
S.89° 44' W. 22.562
S.89° 32' E. 20.146
S.89° 32' E. 3.820
S.89° 32' E. 11.291
66.374
N.89° 32' E. 21.49
N.89° 32' E. 20.146
N.89° 57' E. 31.917
N.89° 57' E. 20.92
S.0° 26' W. 36.121
N.0° 26' W. 36.121
25.75
16.25
21.688
17.094
17.048
62.294
63.192
68.442
5292.30
5.0° 30' E. .268
11.723
15.00
3.20
3.53
7.773
3.39
1.25
1.00
.50
.48
.55
.57
.58
1.00
1.01
32 **1142** FB#38 Pgs. 32–36

C.S. #147 Continued

T10 S. R6W

Beg. at S.E. cor. of Roland Chandler D.L.C. Thence

	S81°18'E.		5,104	
	Set Nail			
	Thence N 89°30'E	+1°25'	8.000	
		+1°	8.000	
1		+2°30'	6.078	-.756 Set June 8, 1931
			+.168	X .194 at This ⊙
	Set 3/4" bolt			
	Iron S. 30' 3/4" pipe		N0°29'W. 30.'	
				offset .248
			6292 = 28.36	
2	Set 3/4" bolt			
	1/2" pipe North .522		.780	
	1/2" pipe South .258			
	N. 71° E.		4.000	
3	1/2" pipe iron rod 11" W. of cult.			
	N. 62° E.	+1°40'	2.754	
4			4.247 = 7.000	
5				

For Chas. E. Rice

1142

7.997
7.999
6.672
22.068

22.236
22.068
.168

455
194
.261

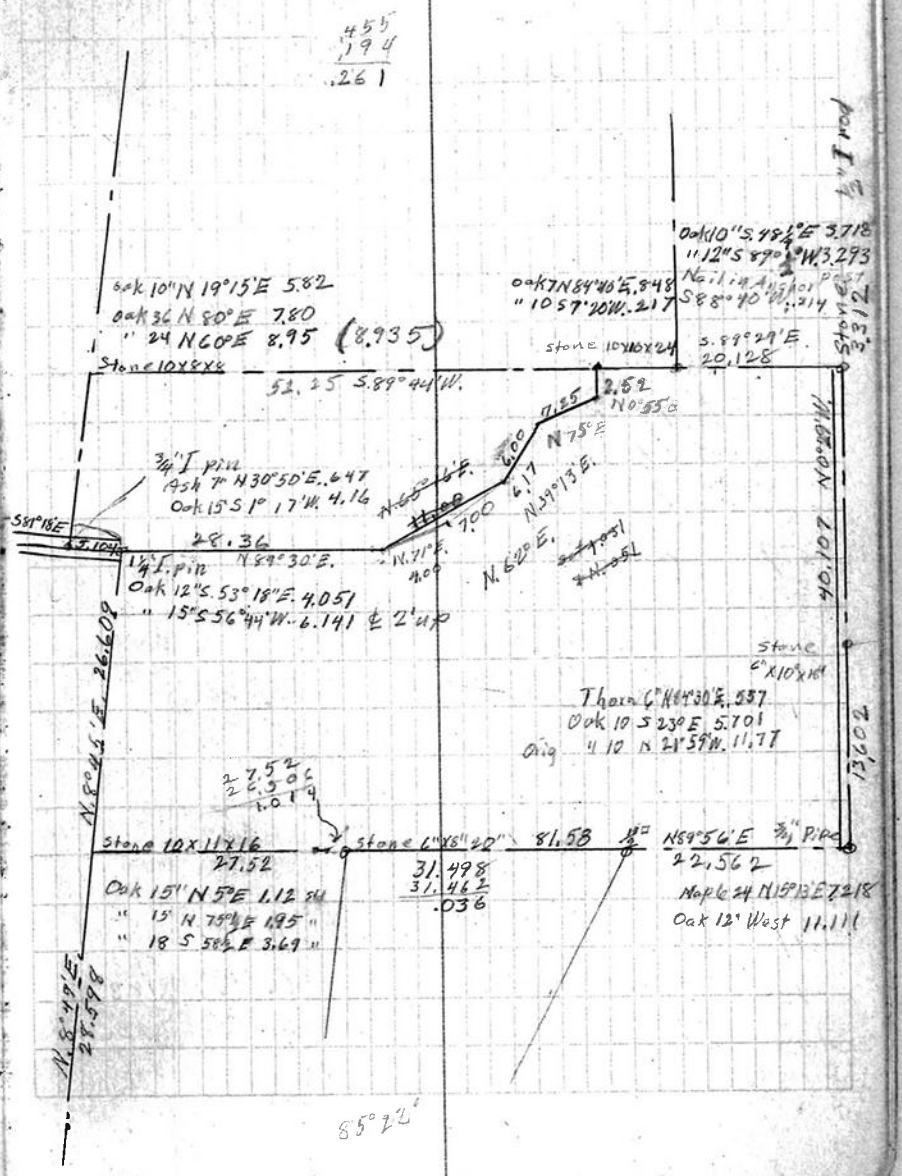

33

					Set 8" bolt 1½" pipe N. 15° W. 7.268 South S 15° E. .497
6	N. 34° E.	+2°30'	6.006		leaves Road
	S. 70°25' E. .580 to Axle	S 73°17' E.	.450		to set fence cor.
		N 75°2	.591		
Set	buggy axle	S 4° W.	.348		
Oak	17" N 35° W. .451		chs.		
"	15 S. 1° E. .132		"		
	N 75° E.	−0°50'	7.842		−.113 to set .347 S.
7					offset .024 W.
		S. 4° W.	.348		S.E. cor. of Deed.
	to Stone 6"x10"x ?	Already set			
	North	+3°30'	2.300		= 2,295
8	correction 55' E. (N. 0°55' E. 2.520)		−.122		
			E. .016		
Set	3/4" pipe				
Oak	14" N. 3° E. .148				
"	7" S. 21° W. .068				
			7.782		offset .122 S.
9	S 89°06' E.		+.007		Most W. S.W.
	Striking S. of Stone		.037		of Gfr. cor. Cl.
	S 89°25½' E. correction N. 2½'				
	S. 89°28' E.		6.850		
10	At 3.1				
11		+1°	4.601		
12	∠ R. 19°43'	+1°	6.117		offset .183 S.
	∠ L 5°13'	+2°40'	2.600		offset .236 N.

Stone 4" under.

offset .236

offset .024 E., .016, .040

offsets .037 S., .183 S., .220 S., .236 N., .016 N.

7.789 − 7.773 = .016

3.154 + .007 = 3.161

7.841 + .250 = 7.591

7.841 + .383 = 7.458 + .113 = 7.345 (7.35 − .005)

.347 + 2.295 = 2.642 + .122 = 2.520

6.850 + .007 = 6.843 + 4.600 = 11.443 + 6.113 + 2.520 = 20.146

34

Back to △ 8

West
correction 16'
(S. 89° 44' W.

14		S. 60023)	2.434	
15		+14°30'	4.754	
16		+ 2°	5.315	
			7.791	
		+ 1°	4,095	
17				
		+3°10'	3,869	
18				
		— 4°	4367	
19				
		−9°41'	7.191	−10°30'46"
		— 4°	4,320	
20				
		−4°05'	7.732	
21				offset
	∠∠ 28°43'		.767	.369 S.
	Set stone 5"x6"x12"		Surface 10	

From buggy axle near △ 6

22	N. 75° E.		.922	6.324
	Set 1¼" pipe			
23	S 0° 29' E.		4.144	S. of road fence
24		+1°40'	5.980	Near buildings
25			5,997	At fence
26			3.641	cr.
27		+1° 20'	6.805	to hill
28		+5°55'	3,394	on ridge
29	∠ R. 07'	+1°40'	6,053	offset .012 W.
			+.149	
			E.012	

offsets.

.037 S.
.122 N.
.085 N
.369 S.
.2845.

.085 S.
.037 S.
.122 S

.946
97437) 92200.0
87693
45070
38974
6092.2

6.325
1.922
7.247

2.04
6
.012.24

11.541 W. of Miller's cor.

7.789
2.434
4.602
5.312
7.791
4.094
3.863
.4356
7.088
4.309
7.712
.673
60.023
52.250
7.773

4.144
5.977
5.997
3.641
6.803
3.376
6.033
35.971
149
36.120

35

Set line No. 756

	Back to △ 1	Set ahead	.170		
	Which is S. 0°29' E. of cor.		.194		
	S. 0°29' E.	−4°30'	3.603	of fence	
30			5.288	foot of hill	
31					
32		+12°30'	1.968	Top "	
33			3.588		
34		−3°	5.956	Swamp	
35		+2°20'	5.841		
	S. 84°10' E.		1.063	to Stone N.E. of Woodside Place	
	Set 1¼" pipe	Set	+.109	= 26.477	
	N. 89°38' E.				
36			3.977		
37		+1°20'	7.764		
		+5°	7.771		
			.245		
38					
39		+6°30'	1.215	= 20.932	
		+9°15'	7.649		
		+6°	1.180		
40		−2°10'	2.863		
41			−.001	=	
	Striking N. of Iron		.106		
		−5°45'	3.410		
42		−10°	2.154	= 5.514	
43	Set 1¼" pipe	Sets	.106		

9763
1968
78104
58578
8786 7
9763
1.921 3584

.10221 .99476
1.063 1.063
30663 298428
61326 596856
10221 99476
1.086492 3 1.057 1788
1.014 162
26.5) 1.043
265
1650
1590
600

5.511
3.390 2.154
95481 2.121.00
1969 62
151380
95481
528990
492405
36585

.194
3.592
5.288
1.921
3.588
5.948
5.837
.109
26.477

3.977
7.762
21.013 7.741
20.934 1.245
.079 1.207
20.932
7.550
1.170
2.861
32.518 32.513
1.056 .001
31.462 32.512
20.932
11.580

.001
3.393
2.121
5.515
11.580 .001
5.514 5.514
17.094

	N. 0° 29' W.						
44			−6°	5.877			
45			−5°10'	4.806	by	40.277 .0050 .020	
46			+2°10'	7.502			
47			−4°15'	6.075			
48			+10°20'	3.950			
49			−3°	5.873			
50	Set 1½" pipe		−13°17'	4.104			
51				2.205			
⊙ on	Stone 6x6x8	in root of Alder					
				+.035 to line			
3.134	S 89°28' E. of Cl. corner.						

.106
5.845
4.786
7.497
6.058
3.886
5.865
3.994
2.205
.035
40.277