C.S. # 1147

Hardcopy 10-3 # 5

also see notes in file

F. B. 40-43

1147 ~~043~~ CS 277 F/B 40 PG 43-44

Beg. at ¾" pipe 4.25 chs. N.3°30'E. offset S. .314
of the S.E. cor. of Sarah Adkins D.L.C. #45
T. 10 S R 3 W. 1147
Offset S. 3°30'W. .314, Backsight at
S.W. cor. of Demas Beach Cl.
Thence S. 89° 29' W.

1			4.070	set Nail
	Set 1" pipe	N. 3°30 E. .314		
			12.888	
2			.024	
	Back to Δ 1			
S.	N. 3°30' E.			
3			7.380	from 1" pipe
4			7.168	
5			+.212	
	Set	S. 3°30' W. .239		
ATT	N. 89°30' E.	Strike N. of Pipe .028		
	S. 89° 35" W.		8.000	
			4307	To 20' S. of ¾" Pipe
6	To ℄ Co. road		+.379	
7	S. 4° 21' W.		7.031	
8			+.737	
9			7.764	
	On division line		5.867	
		-1°26	6.935	

12.630
12.307
.323

4.382
.306
4.076

.379
.66 .25
.19
.320
4.062
5.80
5.97

7.031
7.264
2|14.295
7.397 5
7.031
.366

.737
.366
.371

12.912
12.686
2|25.598
12.799

5.866
6.933
12.799

16.978
4.070
12.908

14.76
7.38
.168
.212

4.070
12.888
16.958
.024
16.982

8037
6.740
14.777
14.76
.017

12.888
.024
12.912

7.380
7.168
.212
14.760

8.000
4.307
.379
12.686
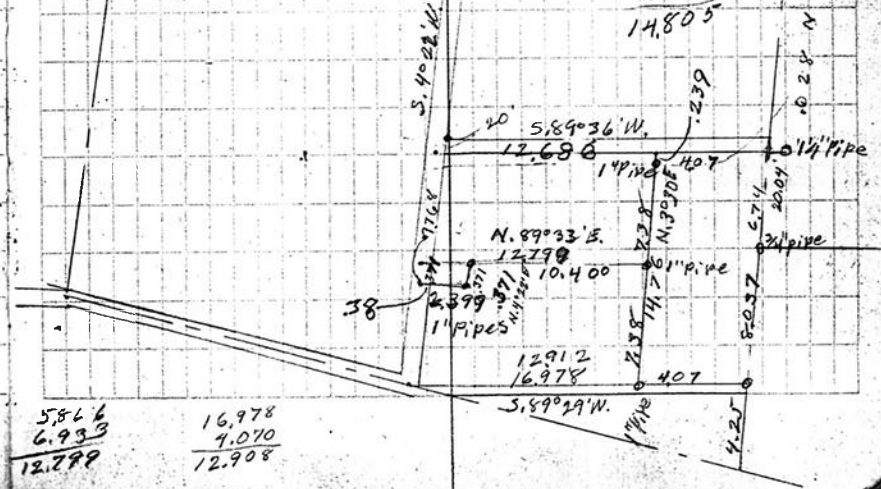
7.031
7.764
14.805