C.S. # 1148

Avery and Beach
Block 18

F.B. 84-85

85

FB #84

1148

Surveyed for Sam Graf
Jan. 22, 1931
for Schuyler July 6, 1933

86

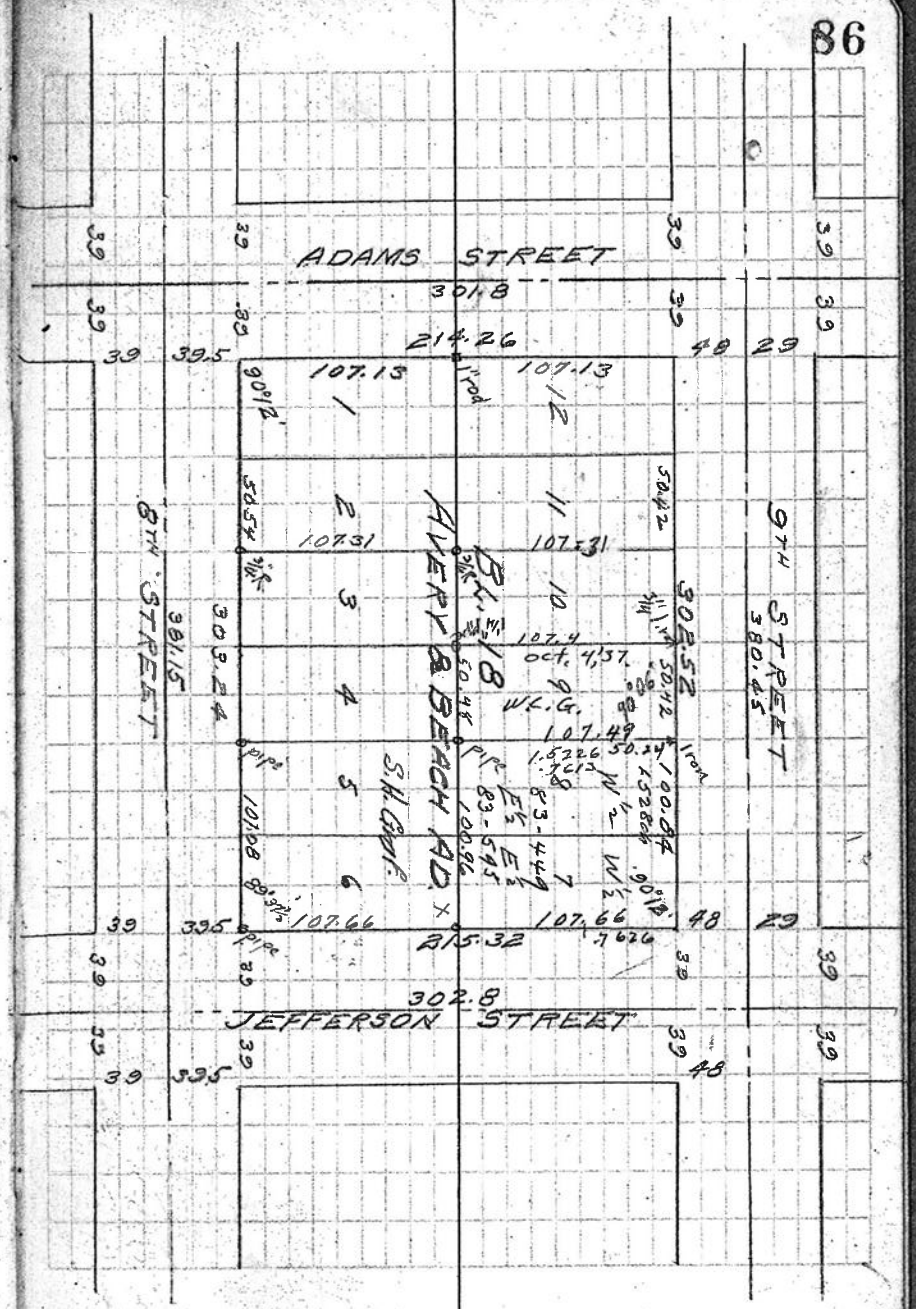
ADAMS STREET
301.8
214.26
JEFFERSON STREET
302.8
8TH STREET
9TH STREET
381.15
380.45
AVERY & BEACH AD.
S.H. Carr
1 rod
1 rod
1 pipe
1 pipe
1 pipe
1 pipe
1 iron
1 iron
1 iron