C.S. # 1153

Hardcopy 12-5 # 12

also see notes in file

F. B. 59-15

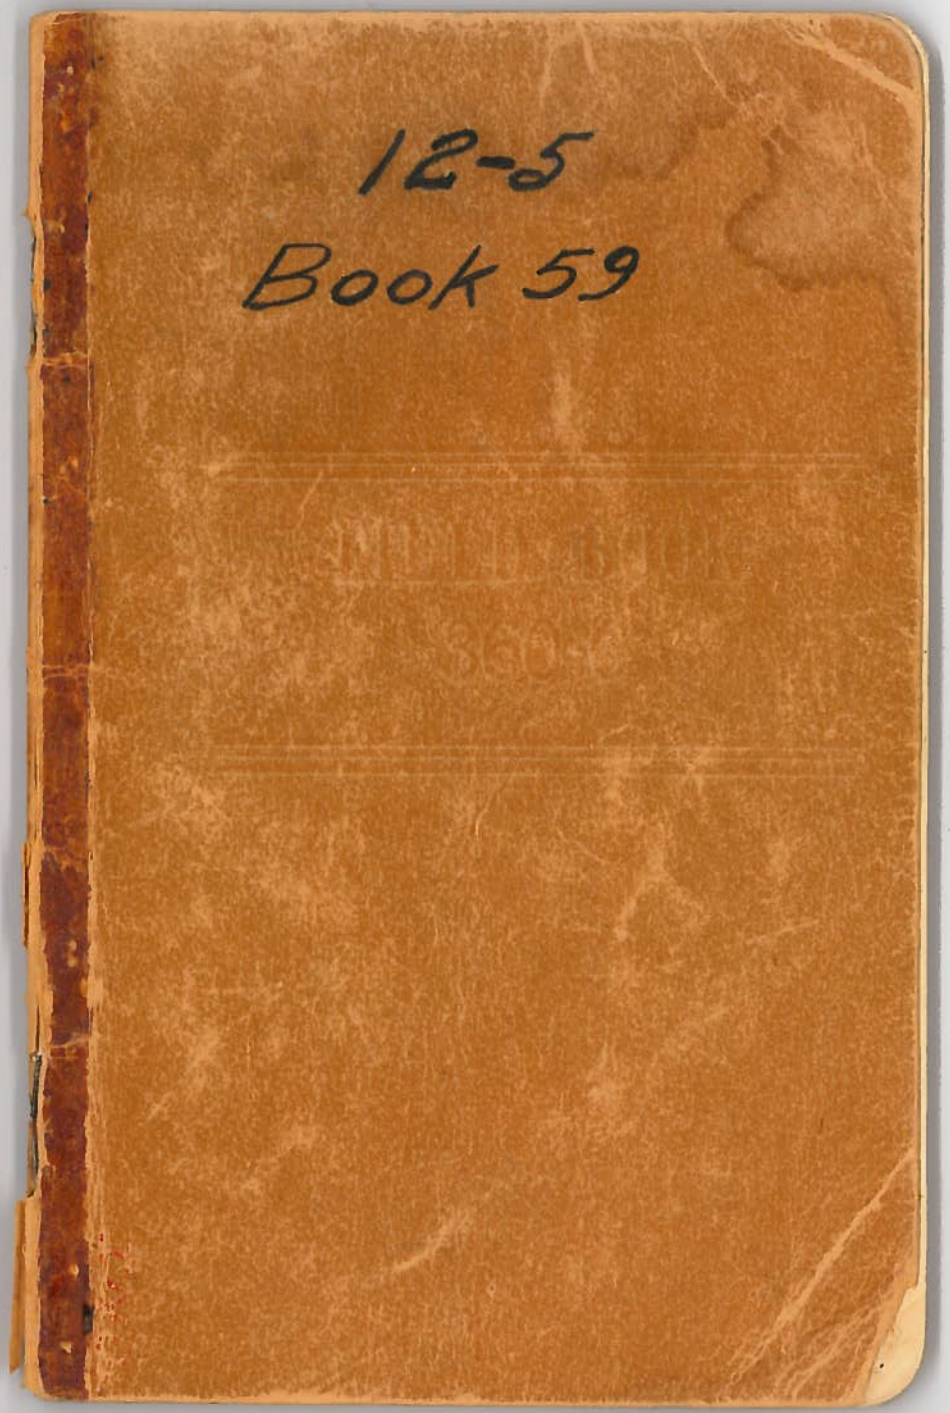
12-5
Book 59

1153

Cl. 166

Beginning at point on S. line of H.W. R.W. 1770.8' E of N.W. Cor. Ja.: Brandt Cl. # 45 = 6.6 E of P.C. on H.W. R.W. Sight on R.W. West = N89°53'W = 2.667 Set 1¼" pipe

thence 176.0 South

Set 1¼" pipe by corner post 89°37' R int. ang

332.5 = 5.038 N89°37E

Set 1¼" pipe 99°02' R int ang

48.3 = .732 N8°39E

Set 1¼ rod △ on cr. bank +25' ± Creek

400.0
196.7
253.0
849.7

89 37
99 02
188 39

39.672 = 2618.4
12.836 = 847.2
1771.2

2 3/4. 3
543.0
1771.3

Chas Johnson Cl. 40

℄ Hwy 11.1 N. of Cl. Cor.

Highway Bearing S89°53'E

39.672
Cl. Line N89°29'E

223.1 Ft. to Cl. Cor.

Bridge 6.5 S.W. 1.3 N. of Cl. Cor.

1¼" Pipe

5.006 | 5.491 | 1.463 | 8.876 | 12.836

10.04 | 10.047 | 10.026 | 10.116 | 10.163 | 10.17

5.006 | 5.491 | 1.463 | 8.876 | 12.786