C.S. # 1154

See notes in file

F.B.

FB#59

C. S. 166 Cont. of Stalley Road #586

Beg at 1" pipe 4.29 Chs. S. 0°02' W. of S.W. cor. of J. C. Avery Cl. 41 T. 12-5

	thence S. 0° 05' W.	11.345	
	Set ⊙ which is	2.404 chs.	N. 89° 40' E.
	of ¾" pipe which we set at ⊙	8.78 chs.	
	N 89° 40' E. of ½" pipe at Bailey's NW. cor.		
	Thence		
3	N. 89° 40' E.	1.953	
4		2.385	
	Set a ¾" Pipe set N. .010		6.742
	N 89° 40' E.		
5	Set a ¾" Pipe	.6875	.967 E line
			= 13.617 + .913
			Set ¾" rod 20° N. 4 20' W.
6	N. 16° 29' E. +	1.426	- .017 = 1.409
			Set ½" Pipe N. 59° W. .312
7	N 45° 30' E	3.273	at .916 set ½" Pipe N 67° 51' E 1.770
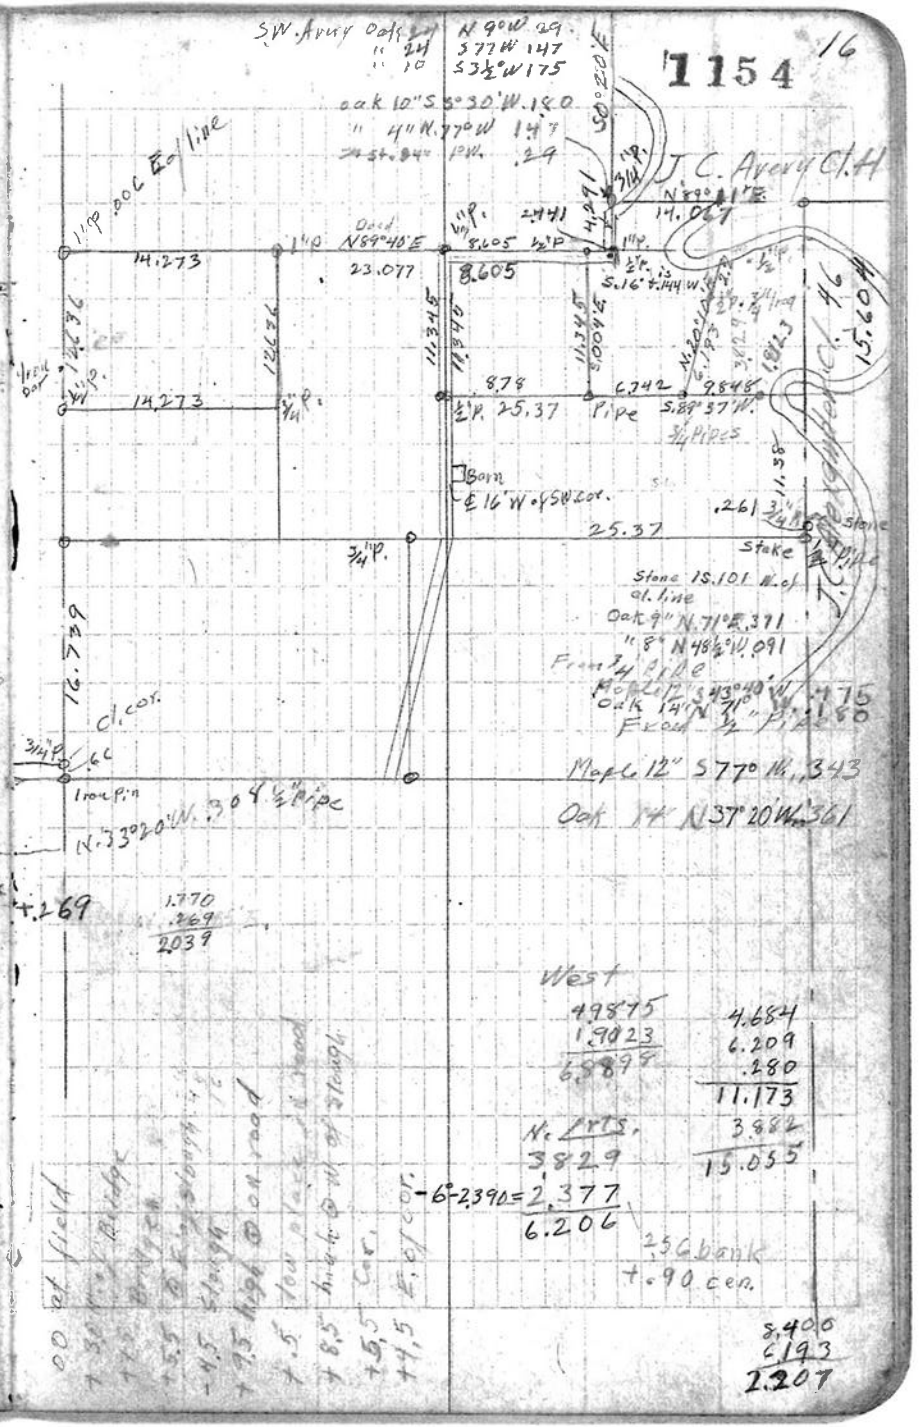
From △5	S 6° 53' W. (E. line S. 27 E.)	4.718	offset .565 W.
9	S 30° 15' E	7.185	offset 3.614 E.
	S. 0° 11' E.	.280	To ½" pipe
	Back To △ 5	.005	4 E.
10	N. 14° 41½' E	4.013	offset 1.018 E. = 3.882
	N 8° 41' E.		to cl. cor.