C.S. # 1156

Hardcopy 12-5 #6

also see notes in file

F. B. 60-2

C.S. 212

Survey for
Mrs. Grant

6864
453
396
570
528
296

Where highway intersects
Marys River S. of Corvallis

FB #60

1156

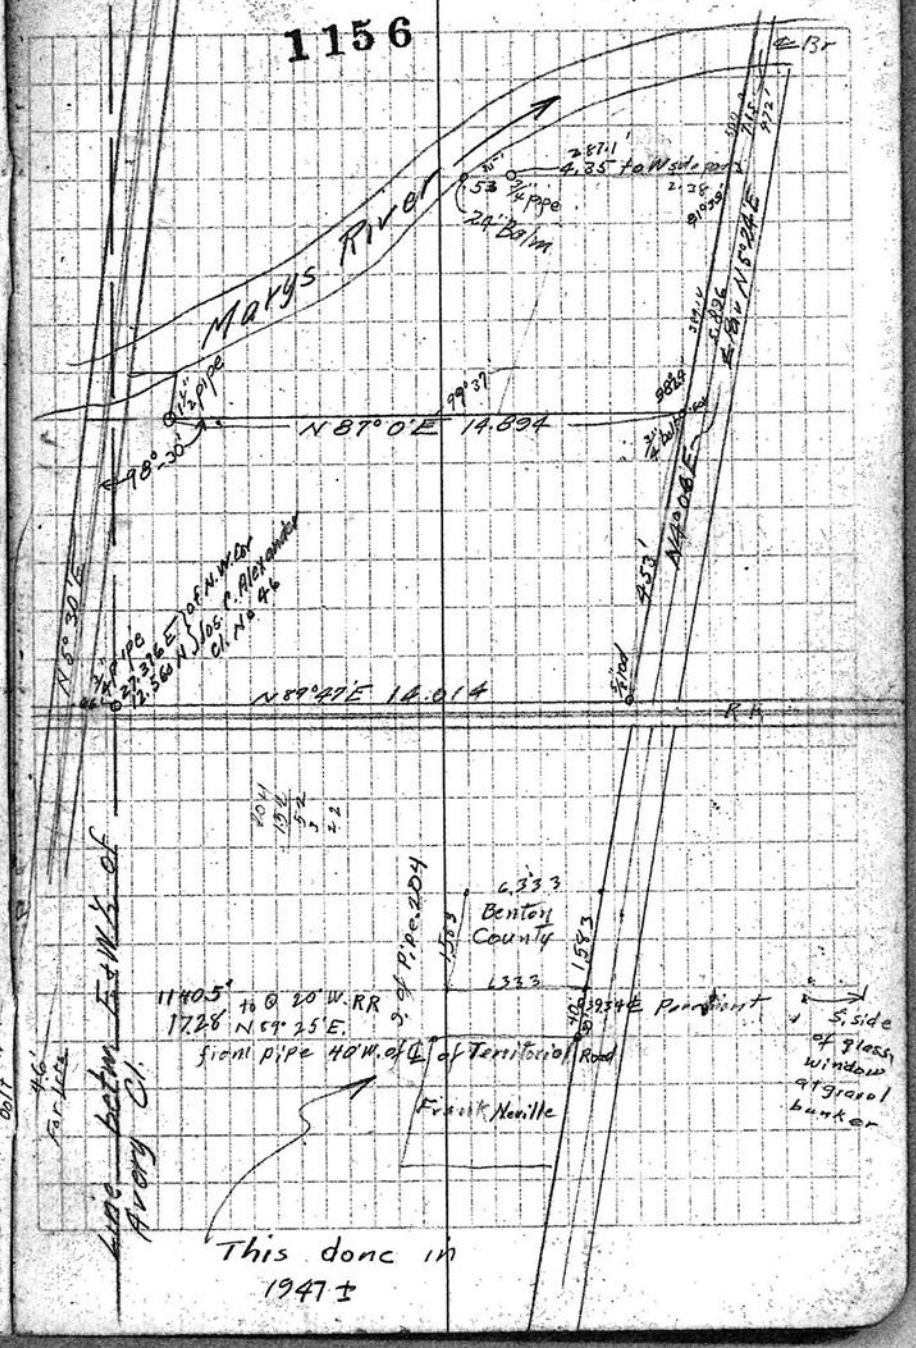

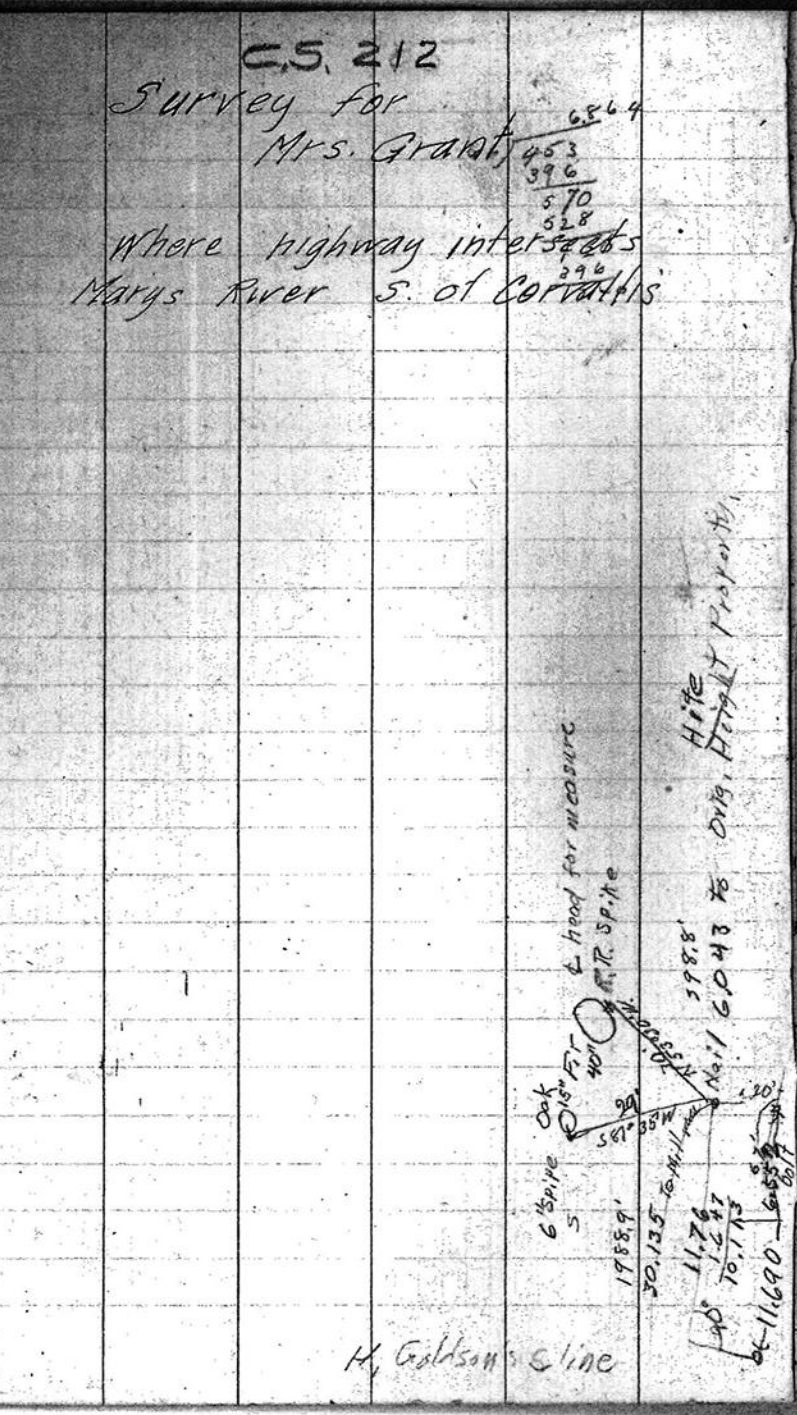

H. Goldson's line