C.S. # 1161

County Addition
Block 12

F.B. 84-95

FB#84

95

Library Lots June 3, 1931.

W.C. Galloway

1161
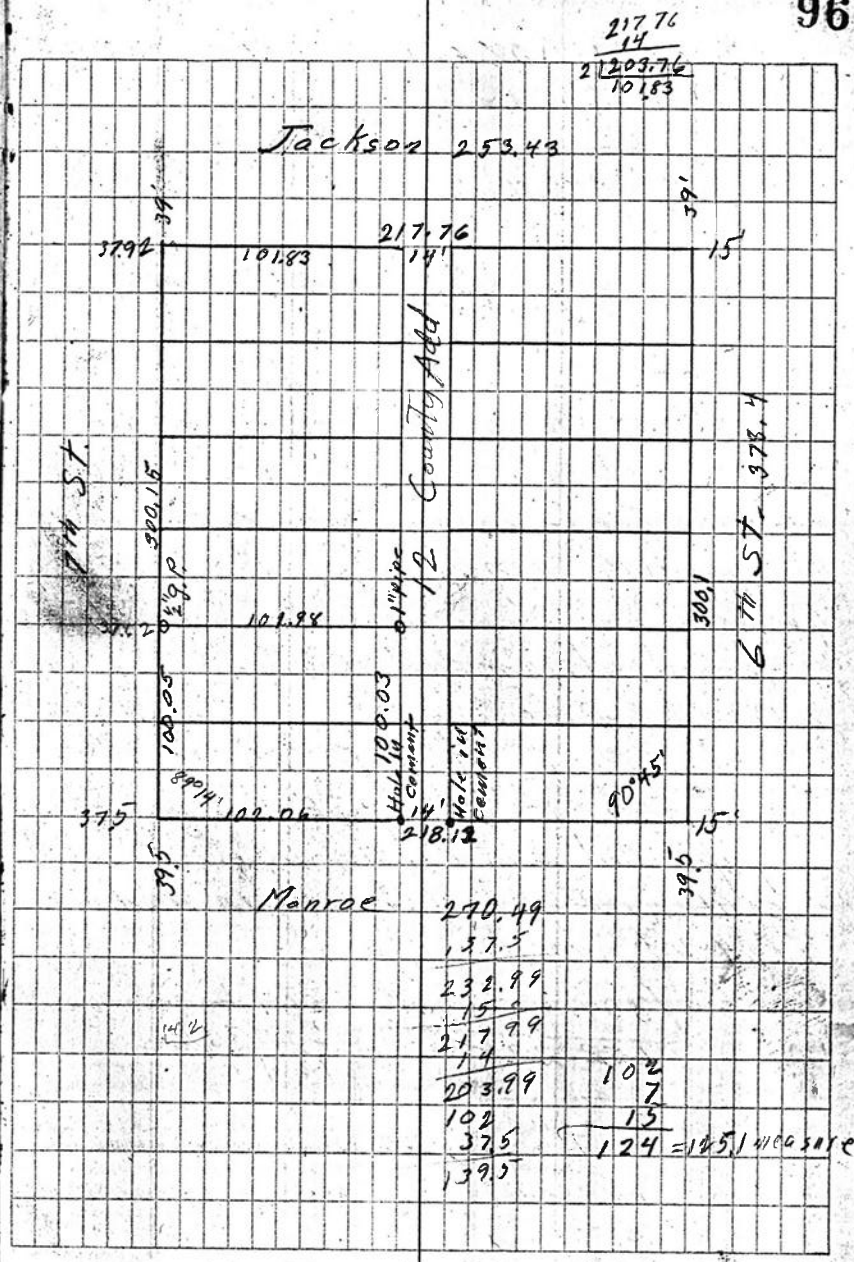
96