C.S. # 1162

Hardcopy 14-8 #9

also see notes in file

F. B. 79-3

F/B #79, Pg. 3-13

3

C.S. 282

Began at a Plow standard the S.W. corner of Sec 24

| | | | | | |
|---|---|---|---|---|---|
| 3.036 | 3.024 | | E | | .121 S |
| .808 +29°40' | .722 | | N89°30E | | .150 |
| 1.356 +2°50' | 1.337 | | | | .203 |
| 1.410 +5° | 1.404 | 1162 | | | .259 |
| 1.941 | 1.941 | | | | .337 |
| 1.381 +7° | 1.370 | | | | .394 |
| 1.905 | 1.905 | | | | .468 |
| 3.007 -7°50' | 2.977 | | | | .587 |
| | | 0°58'L | | | |
| 3.075 -9°20' | 3.036 | | | | |
| | | 0°0' | | .053N | .761 |
| .958 -7°20' | .950 | | | | |
| | | 18.666 | | | |
| | | 1°04'R | | | |
| 1.414 -5° | 1.409 | 20.075 | | | .799 |
| | | 2°53'R | +.414E | .027S | .879 |
| 2.450 -3°40' | 2.445 | Set ¾" pipe Cedar 10" E 1.6 | | | .8255 |
| | | 0°48'L | | .122S | .805 |
| 2.455 +2°20' | 2.453 | | | | |
| | | 0°57'L | | .034N | .937 |
| 1.005 | 1.005 | | | | |
| | | 0°0' | | .017N | .994 |
| 2.416 | 2.416 | | | | |
| 1.984 -3° | 1.981 | | | | 1.090 |
| | | 30.375 | | | 1.169 |

Aug 1931

For Mulholland

4

Stone 12"x10"x6" Oak 11" N65°W 2.17 Fir 52" N35°E 4.42

4" Stake 4 W Fir 48" N5°W .17 Maple 20" S52°E .48

1½" Shaft Ash 15" N15°E .82 Oak 11" N65°W 6.28 Ash 13" S4°W 3.51 Ash 15" N8°W .56

40.32

Fir 20" N60°W 3.00 30" S5°E 9.2 Maple 12" S5°W 7.25 18" N71°E 2.95

Walter Kenneth E. Barker

¾" brass tack

20.25

1"x36" pipe

40.65

24

A.E. VonHorn

Andrew Anderson

Fir 16" N60°E 1.0 1P N35°W .1

N11°18'E 20.25

40.58

20.25

John M. Straw

40.61

20.305

Pipe

S87°46E

20.408

Stake

60.38

S88°29'E

N0°42'E 20.36

Arthur Mulholland

Plow Std

Maple 14" N45°E .58 Maple 20" S7°E 1.41

¾" pipe Cedar 10" E 1.16

20.489

S89°39'W 78.80

40.978 (S87°39'E)

(81.129)

S89°35'E 40.15

Dogwood 8" N45°W .24 Cedar 36" S29°E .75

Fir 36" N36°W 1.08 Maple 16" N70°E .24

5

| | | | | | |
|---|---|---|---|---|---|
| | 30.375 | | | | |
| 3.875 | 3.875 | | | | |
| 5.265 | 5.265 | 39.515 | +.0223 +1.557 | 41.077 | 1.324 |
| | | | | .094 | |
| | | 0°49'R | | 40.978 | 1.535 |
| | | | | | O.K. |
| 3.930 +20" | 3.927 | | | | |
| | | 0°38'L | | .045 S | 1.559 |
| 4.047 | 4.047 | | | | |
| | | 0°34'L | | .044 N | 1.632 |
| 2.240 +4½° | 2.233 | | | | |
| | | 0°06'R | | .018 N | 1.666 |
| 1.896 +1°20' | 1.885 | | | | |
| | | 1°04'R | | 0035 | 1.677 |
| 1.640 | 1.640 | | | | |
| | | 0°28'L | | .031 S | 1.658 |
| 1.143 | 1.143 | | | | |
| | | 0°13'L | | .009 N | 1.675 |
| 1.240 +11' | 1.218 | | | | |
| | | 0°12'L | | .005 N | 1.686 |
| 4.726 +30" | 4.720 | | Check from here | | |
| | | 0°0 | | .181 N | 1.901 |
| 3.055 +5' | 3.043 | | | | |
| | | 1°38'L | | | 1.923 |
| 2.074 +4½ | 2.068 | | | .059 N | |
| | | 1°05'L | | | 1.997 |
| 1.905 +17'55" | 1.893 | | | | |
| | | 6°25'R | | .034 N | 2.044 |

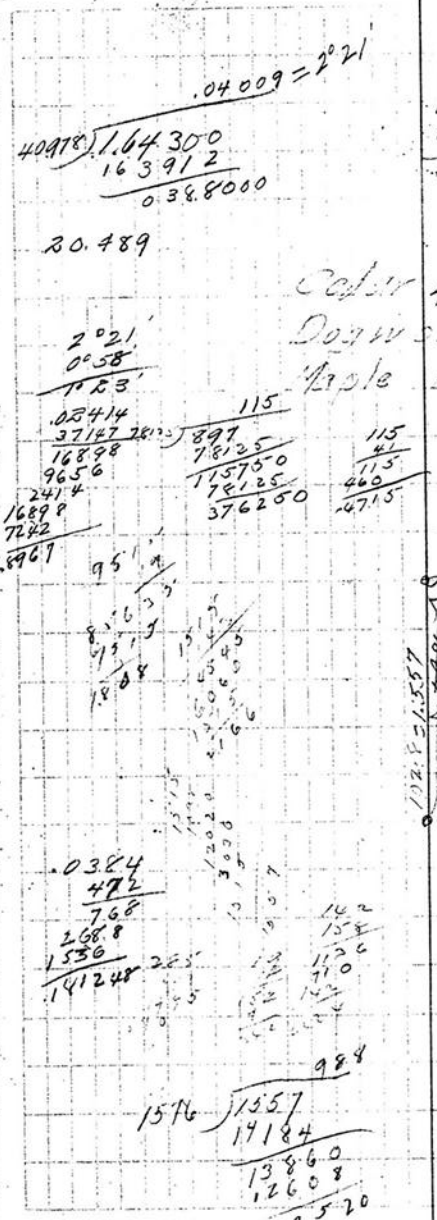


6

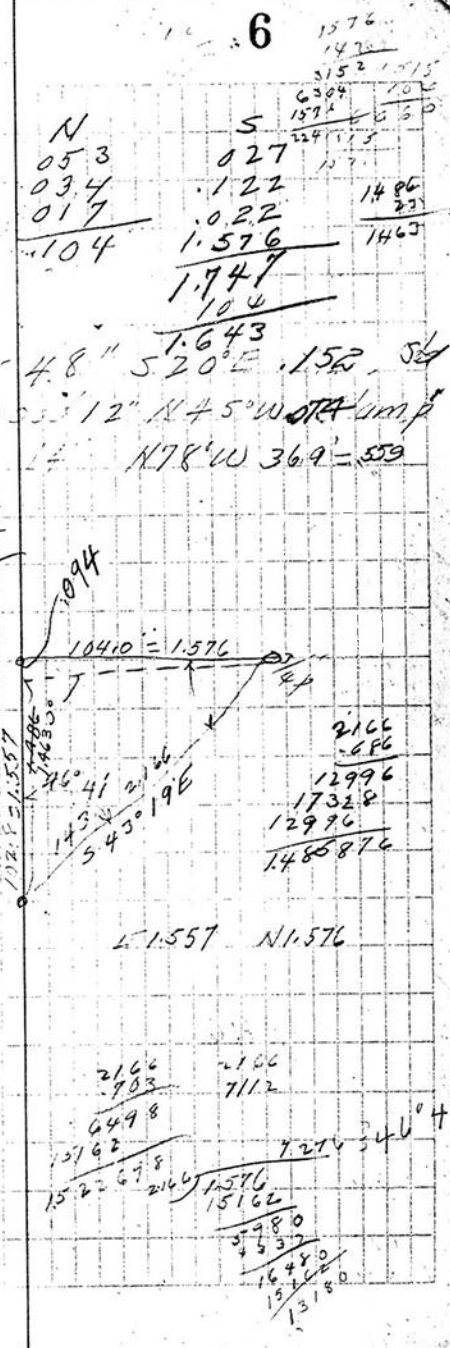

7

| | | | | | |
|---|---|---|---|---|---|
| 00 | 67.252 | 0°0' | | | |
| 18.193 | 2.193 | | | | R.060 |
| +7°35' | | | | | |
| 73.871 | 3.837 | 0° 0' | | | R.088 |
| +18°20' | | | | | |
| 7.844 | .802 | 0° 0' | | | R.094 |
| +6°55' | | | | | |
| 71.756 | 1.744 | 0° 0' | | | R.107 |
| +16°25' | | | | | |
| 73.578 | 3.431 | 0° 0' | | | R.132 |
| | | 79.259 | | | |
| | | 2°26'R | | | |
| + | | | | | |
| +3° | | 80.477 | | | |
| 71.216 | 1214 | 69°42'R | | .051 S | R.090 |
| +11° | .484E | | | | |
| 1.420 | +395 | | | 1.308 S | |
| | | 78°26'R | | | |
| .817 | .164E | | S11°E | .800 S | |
| | .817 | | | | |
| | | Set ½ pipe | | | |
| | | 90°0'R | | | |
| -9°20' | | | | | |
| 1.294 | 1.276 | " | N0°30'E | | .030 |
| -2°0' | | | | | |
| 1.497 | 1.407 | " | | | .063 |
| -24.60' | | | | | |
| 3.095 | 2.816 | " | | | .129 |
| -5° | | | | | |
| 5.570 | 5.548 | | | | |
| | | 0°10'L | | -1.20 creek | .259 |
| +4° | | | | | |
| 1.903 | 1.898 | | | | |
| | | 0°06'R | | .006W | .310 |
| +9°20' | | | | | |
| 4.253 | 4.196 | | | | |
| | | 17.141 | | .007E | .401 |

8

| | | |
|---|---|---|
| S | N | |
| .045 | 1.576 | 78.125 |
| -.022 | .044 | 2.996 |
| .023 | .018 | 81.129 |
| .003 | .009 | 40.978 |
| .031 | .005 | 40.151 |
| .051 | .059 | |
| 1.308 | .034 | |
| .800 | 1.745 | |
| 2.216 | 1.926 | |

1.576 N
.017
1.593
.034
1.559
.029
.044
1.632
.016
.018
1.666
.014
.003
1.677
.012
1.689
.038
1.658
.008
.009
1.675
.006
.005
1.686
.034
.181
1.901
.022
1.923
.012
.059
1.977
1.013
2.044

2.216
1.926
0.290
40.151
.281057
89430
803
91280

.025
.007
.022

Set dogwood stake 3" x 3/4" Pl
Fir 36" S50°E .24 Std
" 36" N80°E .59 "
16" Chain S58°W .68 "
Fir 18" N43°W .28 "
Fir 28" S20°E .048

2.044
.016
2.060
.028
2.088
.006
2.094
.013
2.107
.025
2.132
.009
2.141
.051
2.090

2.090
.003
2.093
1.308
.785
.001
.786
.500
1.286

.030
.033
.063
.066
.129
.130
.259
.040
.006
.310
.098
-.007
.401

| | | | | | |
|---|---|---|---|---|---|
| | 17.141 | 0°27R | 20.654 | .584 | S |
| +10°05' 3.580 | 3.513 | | | .446 | E |
| | | 6°19R | 3/4 pipe | .456 | |
| -16° +23 | .405 .407 | | | .044E | |
| | | 0°0' | | | |
| -33°40' 2.167 | 1.803 | | | | |
| | | 1°20R | | | |
| -13°18' 2.281 | 2.319 | 1°20R | | | |
| -18°11' | | 0°0' | | .051E | |
| 3.434 | 3.262 | 0.0 | | | |
| | | 1°35L | | | |
| +8°31 2.531 | 2.308 | | | | |
| | | 0°0' | | .064W | |
| +24°15 4.295 | 3.915 | | | | |
| +16°20 1.540 | 1.191 | " | | | |
| | | 0°58L | | | |
| +15° 2.750 | 2.658 | | | | |
| | | 38.416 | | .045W | |
| +12°38 2.145 | 2.086 | 0°45R | | | |
| | | 40.502 | | | |
| | | 40°0 | | .009E | |
| +16° 1.432 | 1.397 | | | | |
| +12°50 1.838 | 1.793 | | | | |
| -3°30' 1.079 | 1.077 | | | | |
| -21°15' 2.304 | 2.288 | | | | |
| -15°20' 2.310 | 2.227 | | | | |
| -19°50' 2.582 | 2.414 | 51.678 | | | |

Sec opposite page

Fir .30" E .09
" .30" N .11

20.654
20.07
.584

| E | W |
|---|---|
| .007 | .006 |
| .027 | .064 |
| .044 | .045 |
| .051 | .007 |
| .009 | |
| .021 | .122 |
| 159 | |

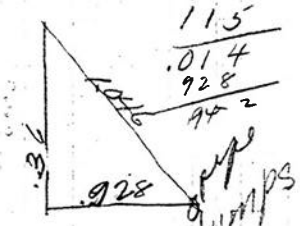


1/4 pipe
1/4 Cor found old stumps
All marks gone
Chittam 5"N W .18
Fir E +/- .52

40.26 Temp adj



51.678

| | | |
|---|---|---|
| .401 | -10°30' | 0°06L |
| .082 | 4.239 | 4.168 |
| .483 | -8°0 | 0°0 .007W |
| .027 | 4.953 | 4.904 |
| .456 | -12°40' | 0°22'R |
| .014 | 3.220 | 3.143 |
| .442 | | |
| .004 | | |
| .446 | -9°20' | 0°0' .021E |
| | 2.666 | 2.628 |
| | -1° 1.463 | 1.453 |
| | -10° 3.868 | 3.810 |
| | 2.125 | 2.125 |
| | +8°E. 3.100 | 3.066 |
| | | 76.995 |
| | +6°20' 3.424 | |
| | | 80.399 |
| | | .120 |
| | | 80.519 |

Fir 30" N62°E .68
" 8" N14°E .323

.0234 = 1°21'

4014.942
80 28
13920
12042
18740

Back to S.W. Cor 24

| | | | | |
|---|---|---|---|---|
| .944 | | | East | |
| | | 90°15½ | 0°15½ | 90°=0 |
| 9.150 | 9.150 | | North | |
| | | 90°35½ | 0°35½ | .040W |
| R.295 | R.295 | | | |
| | | 90°57½ | 0°57½ | .023W |
| 3915 | 3.903 | | | |
| | | 90°45½ | 0°45½ | .065W |
| R.840 | 2840 | " | " | |
| 4467 | 4.467 | | | |
| | | 1°09½ | | .095W |
| 4908 | 4.908 | | | |
| | 12.931 | 4°08½ | | .098E |
| | | 40.528 | | |
| | | -.034 | | |
| | | 40.494 | | .937E |
| | | = 40.503 true | | |

Back to Cor 20 #89 E of SW 24

(825)

| | | | | |
|---|---|---|---|---|
| | | 89°04½ | 1 | |
| -110 | | | | |
| 1345 | 1.322 | 1°03½ | South | |
| -30 | | | | |
| R.030 | R.510 | " | 1°56½ E | |
| R.510 +20° | R.510 | | | |
| 4.860 | 4.567 | | | |
| +26° | | | | |
| 1.099 | .980 | | | |
| 4.983 | 4.983 | 17.697 | | |
| -4½ | | 0°34½ | | |
| 2.616 | 2.608 | 20.305 | | .026W |

040 098
023 937
065 1.035
095 223
.223

40.50 .812
810
200

1°10'
.0205

.019

40.978
+.032
.658
.1082

1°10'
24
42
1.4

Set ¾" pipe. 8.25 S – Cedar 10" E .116

20.305
17.697
2.608

| | | | | | |
|---|---|---|---|---|---|
| | | 0°34 L | ¾ pipe .026 E | | |
| 597 | 597 | | | | |
| | | 91°16 R | Az | | |
| +9°50' 4.084 | 4.023 | | 568° | | |
| +6°30 5.000 | 4.968 | | 567°48' | | |
| -7°20' .676 | .670 | | | | |
| -1°30 2.386 | 2.268 | | | | |
| -8° 2.243 | 2.221 | | | | |
| +0°20 1.620 | 1.613 | 15.762 | | | |
| +4°30' 4.686 | 4.672 | 20.434 | | | |
| -1°00 5.000 | 5.000 | | | | |
| -3° 5.000 | 4.993 | | | | |
| +5°0 3.310 | 3.297 | | | | |
| -3°0 1.030 | 1.030 | | | | |
| -22°55' 1.812 | 1.670 | | | | |
| +6°40 4.898 | 4.864 | 41.284 | | | |
| +13° 2.800 | 2.727 | | | | |
| +8°30' 1.562 | 1.547 | | | | |
| -12°30' 2.582 | 2.520 | | | | |
| -2° 1.877 | 1.877 | | | | |
| +5°40' 1.445 | 1.440 | | | | |
| +7° 1.666 | 1.653 | 0°41'R | | | |
| -3° 3.603 | 3.600 | 0°0' | | .043S | |
| +9½° 1.802 | 1.777 | | | | |
| | | 0°17' L | 60.384 | | |
| +3½° 1.959 | 1.955 | 91°55' L | | .076N | |
| +8°30 .933 | .921 | N0°17'E | | | |



921
0.026
4.75

Times each

20.408
.026
20.434
15.762
4.672

-23°
2.380 2.188
1.465 1.933
.995 .987
1.420 1.308
1.55 1.527
3.64 3626
11.569
2.05
13.619

1724

60.384
20.408
80.792

1.60
1.47

Through
60.804) 967 = 0.55N.

bit bob on top of hill.