C.S. # 1163

Wells and McElroy

Block 1, 2

F.B.

T11S. R5W SEC 34

BLOCKS Nº 1 AND Nº 2
of
Wellsard Mc Elroy Addition To Corvallis
Showing
Supplemental PLAT OF
Part of Block Nº 2

1163

Scale 1" = 80'

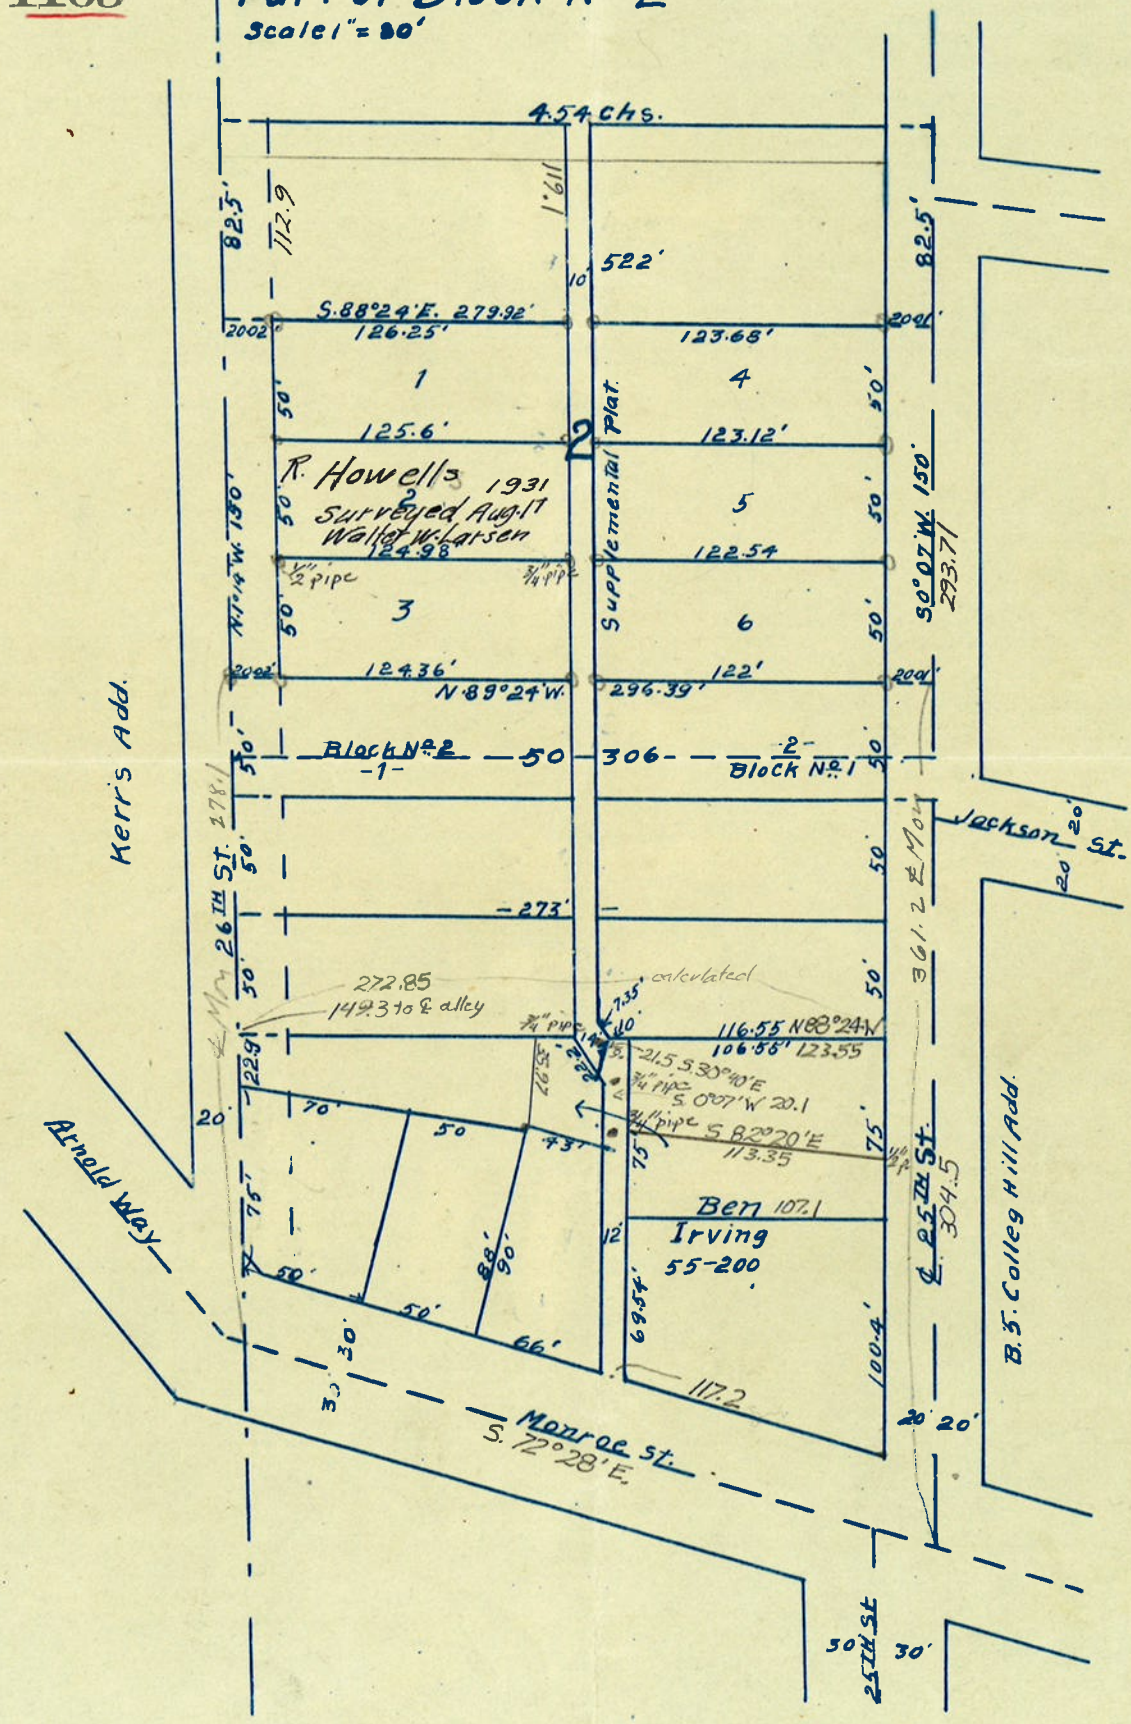

41

1164 F/B 38, Pg. 41-42

C.S. 248 Continued

Emerson Redmour Cl. 40

T. 14 S., R 8 W., W.M.

Beginning at stone the N.E. cor. of E.T. Ellis Cl. #38

Thence	S 0° 55' W. (correction E .48' S 0° 07' W. 26.912)			
1			3.358	.063
2		-1° 20'	5.477	.165
		-35'	8.000	.29 E. 373 bnk.
			7.794	.405 +08 bnk.
3			2.281	
4			+.001	
Recorded			.437	

S.W. Cor. of E. Redmour Cl. 40 striking W. of cor.

Stone 6"x6"x? in place Yew stake on N.

Oak 18" S. 34° 20' E. 1.414 face std.

Fir 20" S. 18° 30' E .651

Oak 14" S. 9° 50' W. .558

Thorne 7" N 83° E .082 E lower blaze.

From cor. .06 bnk. .4 E. of portion 1.90 E. bank.

From △ 4 S. 89° 53' E.

5		-4°	2.644 = 2.638	E. Road +54 fence
				3.00 fence E.09
				3.24 E. road line
6	N 1° 09' W.		5.8615	W. .40 Bnk. E. .29 fence
7	N 38° 42' E		5.4185	W. .20 bnk.
8	N. 51° 52½' E		2.552	
9	S. 89° 42' E correction S. 04' for S. line of Road S. 89° 38' E.		5.633 = 5.622	.011 To 0.225 N. of ¾" Pipe & N. .252 from ¾" Pipe E.

Aug. 24, 1931

For D. L. Loughbottom

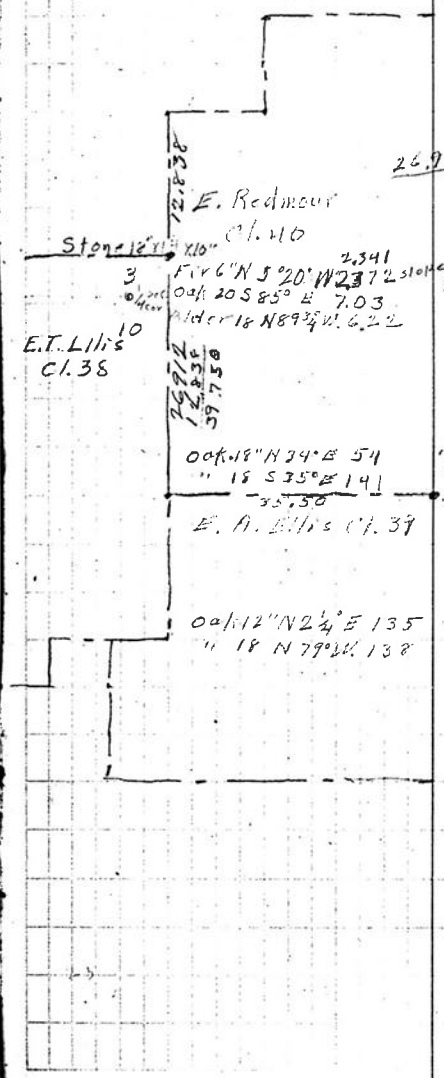

19.149
19.532
.683
039
.650

13.082
6.25
19.832

4000
13.082
26.918
24.627
2.291

3.358
1891
3358
30222
26814
33588

.06349975
.437 1.01389 = 48'

26.91 1.374
26 91
10490
8073
24179
24219

2361 + 7°30'

3.357
5.476
8.000
7.794
24.627
2.281
.001
26.909
13.087
39.996

10.66
495
5330
759
4267

.052 76 70
22.0
.033

.046
.063
.109 E 1
.076
.185 - 2
.110
.295
.110
.405 3
.032
.437
.437
.000 4

233
85 4
1165
1864
.019805 5

3.421 = 38'
19 .65
57
80
76
40
38
20

.2638
.437
2.201

8.498
10.660
19.158

42

Back to Beginning

Thence N 0° 22½' E.
correction W. 22½'
(North 11.602)

	+11°40'	8.3[illegible]	Set W. .051
	2° 10'	2.248	Set W. 1.066
— Left 3°20½'		1.274	.074 W.

7835
2.495
1.272
11.602