C.S. # 1166

Hardcopy 12-5 # 28

also see notes in file

F. B. 61-10

FB #61

9

Sept 16, 1931

C.S. 124

Began at a ¾" pipe on N. line of A.G. Hovey Cl. 43.333 W. of N.E. Cor. = ℄ Rd. S.

18.90 South

456

19.356 +10.000

	△	℄ Road on ℄ Claim 18.86 So. of N line
744.3 = 11.280	744.3	East
	△	+ 0.2 Set ½" pipe on ½ dir. line
(18.225 = 18.947)	722.7	East
	△	pipe by Hopsons Hse
22.227		

Bear	Dist	N	S	E	W	DMD	X
N66°24'E	18.971	7.545		17.384		17.324	13203
S0°06'E	7.469		7.469	.013		34.781	
S89°35'W	17.397		0.126		17.397	17.397	
		7.545	7.595	17.397	17.397		13203

259.78
2.19
261.97
132.00
129.97
6.499
4.00
2.484
2.497

44293
3.7264
25758
8586
30021
12879
1.51957.18

7.467
800
2.667
3722
40017
13338
46683
2.0007
2.484

7.469
0.792
6.677
3.692
13354
60093

7.469
1.600
5.869

2.497
2.484
.013

.022

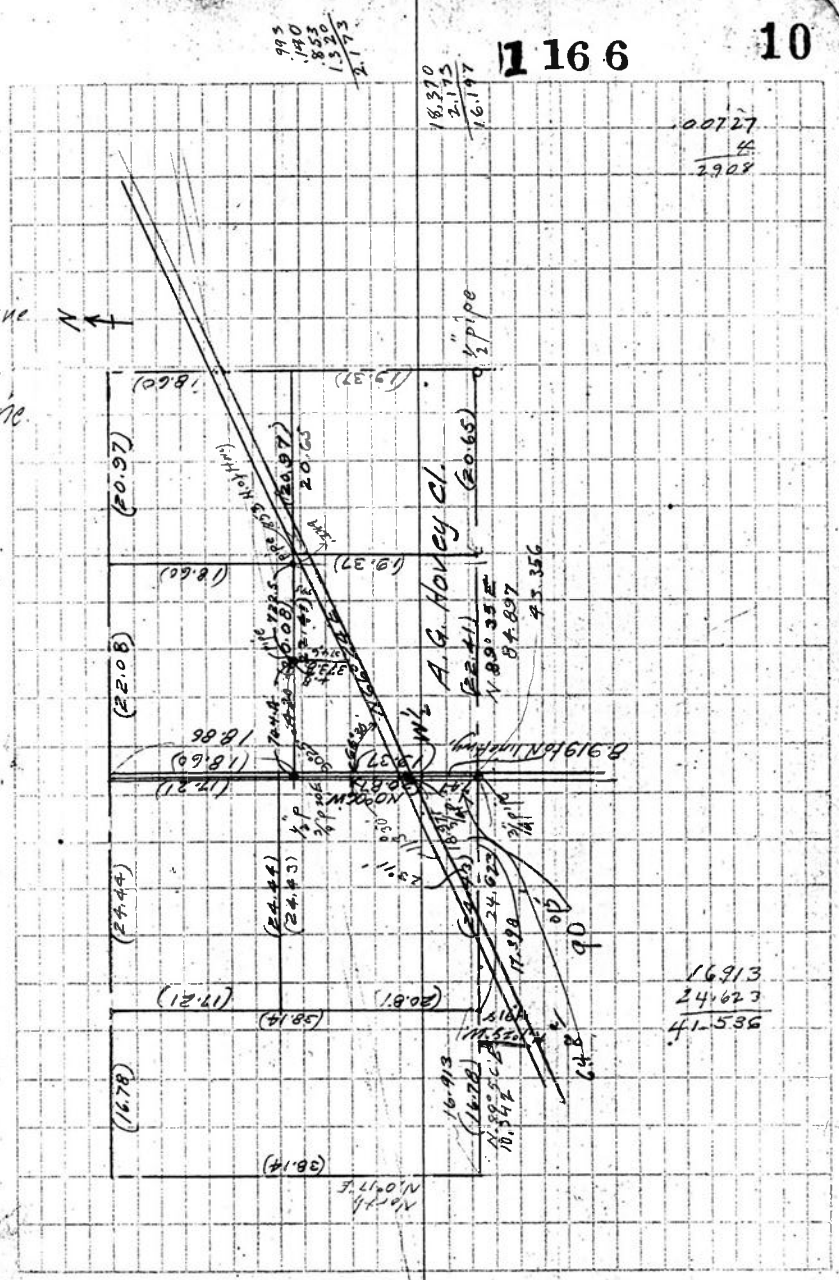
1166
10
A.G. Hovey Cl.
N
½" pipe
Set ½" pipe
Hopsons
Hse
