1168

T. 13 S. R. 5 W., W. M.
BENTON COUNTY — OREGON

1168

Scale:- 1 in. = 10 chs.
Bearings true.

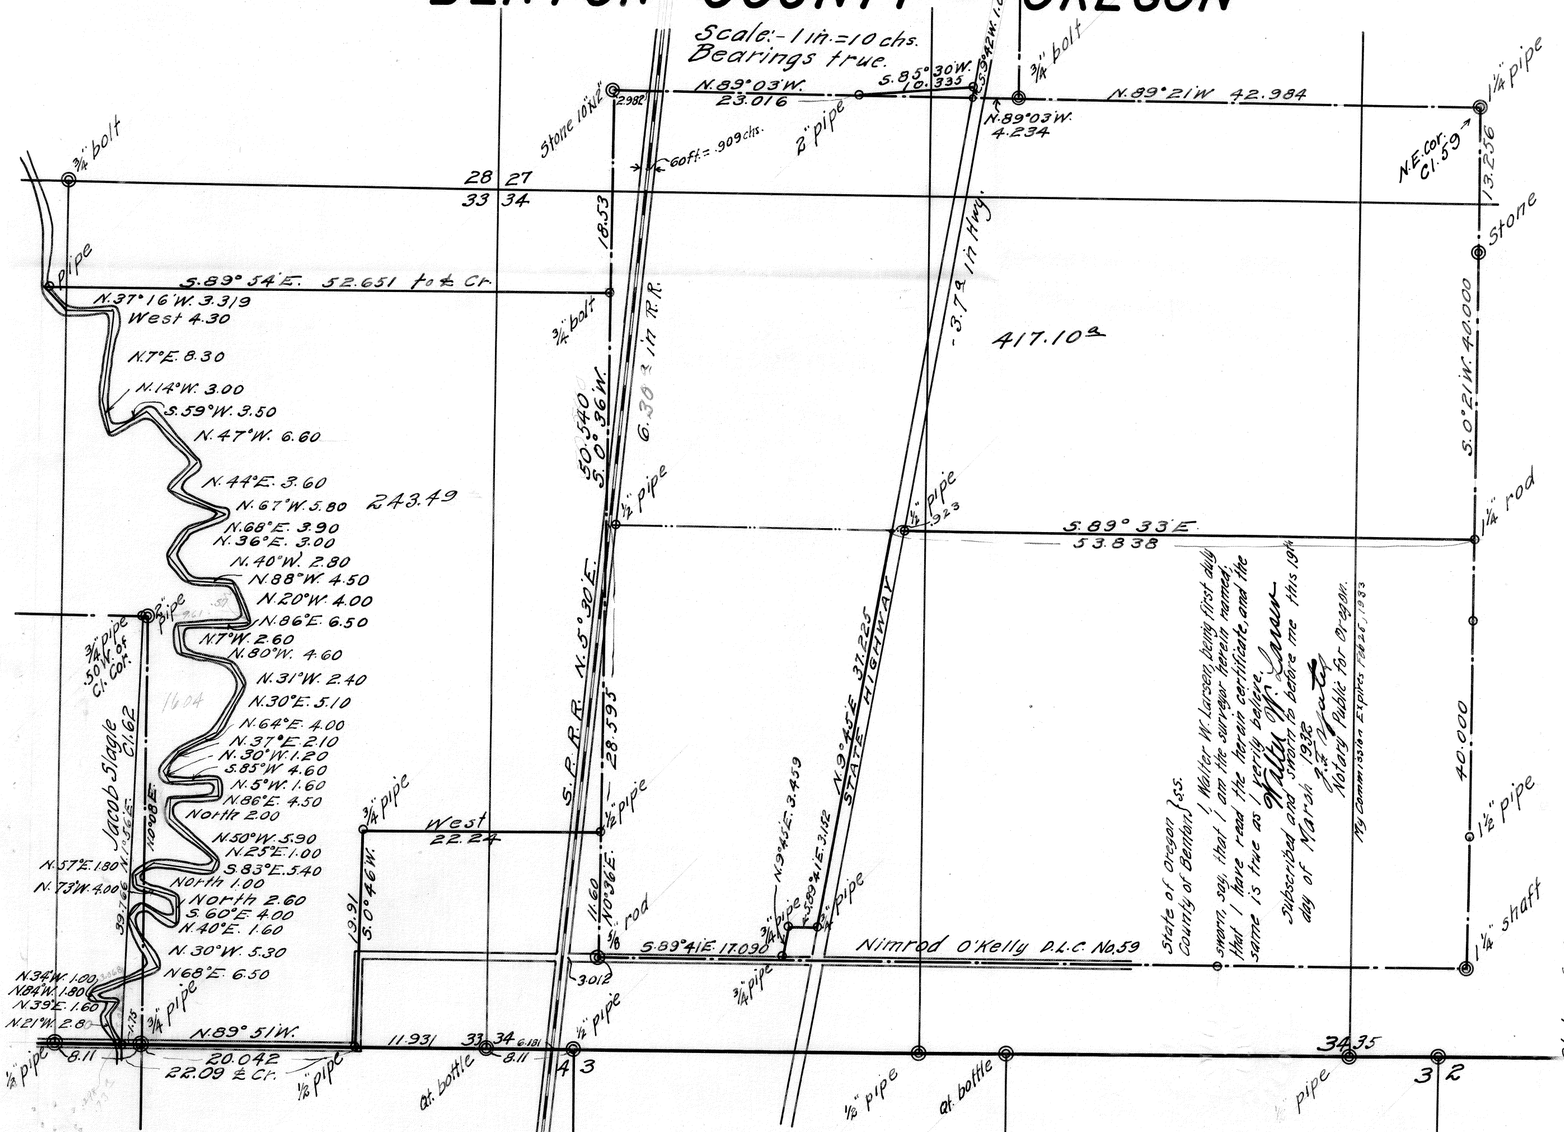

State of Oregon
County of Benton } ss.




That said survey was begun from a definite point (a 1/4 pipe at the N.E. corner of said Cl. No. 59) which can be retraced by any competent surveyor.

Walter W. Larsen

Subscribed and sworn to before me this 19th day of March 1932.

P. F. Bryant
Notary Public for Oregon.
My Commission Expires Feb 26, 1933

FB# 70 Pgs. 8-12

Survey for Grover Avery
+ Bruce Heirs
1931

111.76 ac.
151.76
81 =
70.88

111.76
48.12
160.00
51.76

.52 E of

8

1168 T.13S R.5W.

Ash 24" 53°E 14.05

(80.38)

3/4" pipe
Ash 8" N 12° E 3.25
Oak 12" S 13° W 2.50

1" pipe
Ash 8" N 12° E 3.44
11" S 83° W 2.50

(111.76)
USM

32.12

32

160

32.12

40.00

92.25

33

2 rods = 0.50 chs

C.S.M.

33-28.6

Jacob Slagle Cl. 62

3/4" pipe
1/2" pipe
3/4" pipe S. 30' = 3.03

3/4" pipe 6.1 W of stake
Ash 15" N 72° E 5.82
S 59° E 8.08

SW. 30.90

SW. 3.77

SE. Cor. John Slagle Cl. 62

1/2" pipe 8.1 W of Stake
3/4" pipe S. 20' = 3.03

14.795

8.11

40.23

8.11

20.042

11.931

7 rods = 1.75 chs.

3/4" pipe
US 45, N 20° 2' W 4.07

Wm. G. Rodgers Cl. 07

Line 5.22
1/2" Pipe
N of 0 Stake S. 3.03

3/4" pipe
Ash 8" S 75° E 6.80
Oak 11" N 40° 35' W 1.92

N 0° 05' E 79.562

80.00

8.11

Set on pt 1.74 W of ½ cor — 4

91°47'R

3.493	3.493	Δ + 5 2.27 W to fnc
9.826	9.826	
9.037	9.037	
9.980	9.980	
5.000	37.336	39.766
2.944	2.430	cost under
.382		1" pipe .01 W
		= .50 W of 2" p

92°55' Ck. Cr.

fence is .18 E of 1" pipe

91 47
89 51
1°56

.03143 = 1°48'
39.766) 1.25

Bruce heirs

Sept or Oct 1931

Began at N.W. Cor. Kimrod C. Kelley Cl. 59

40.536 40.335 / 18.53 / 21.805

18.53

40.536 N 61 W

Set .061 N 40.475 W

30°36'W True bear.

R.R. 006 E

Fence 4°53½ to RR (84.51 from RR to fence) = S29°39'E

E rail 15.00 7E of line

40.139 80.675

2.441
15.000
4.799
22.240

Set ¾ pipe .04 N of fence ext and .03 E of fnk E

South

from point 1.248 S of [illegible] on N of sec & Sight on pt .02 W of NW cor (E) int any L 89°38 to ¼ sec cor on S of 33

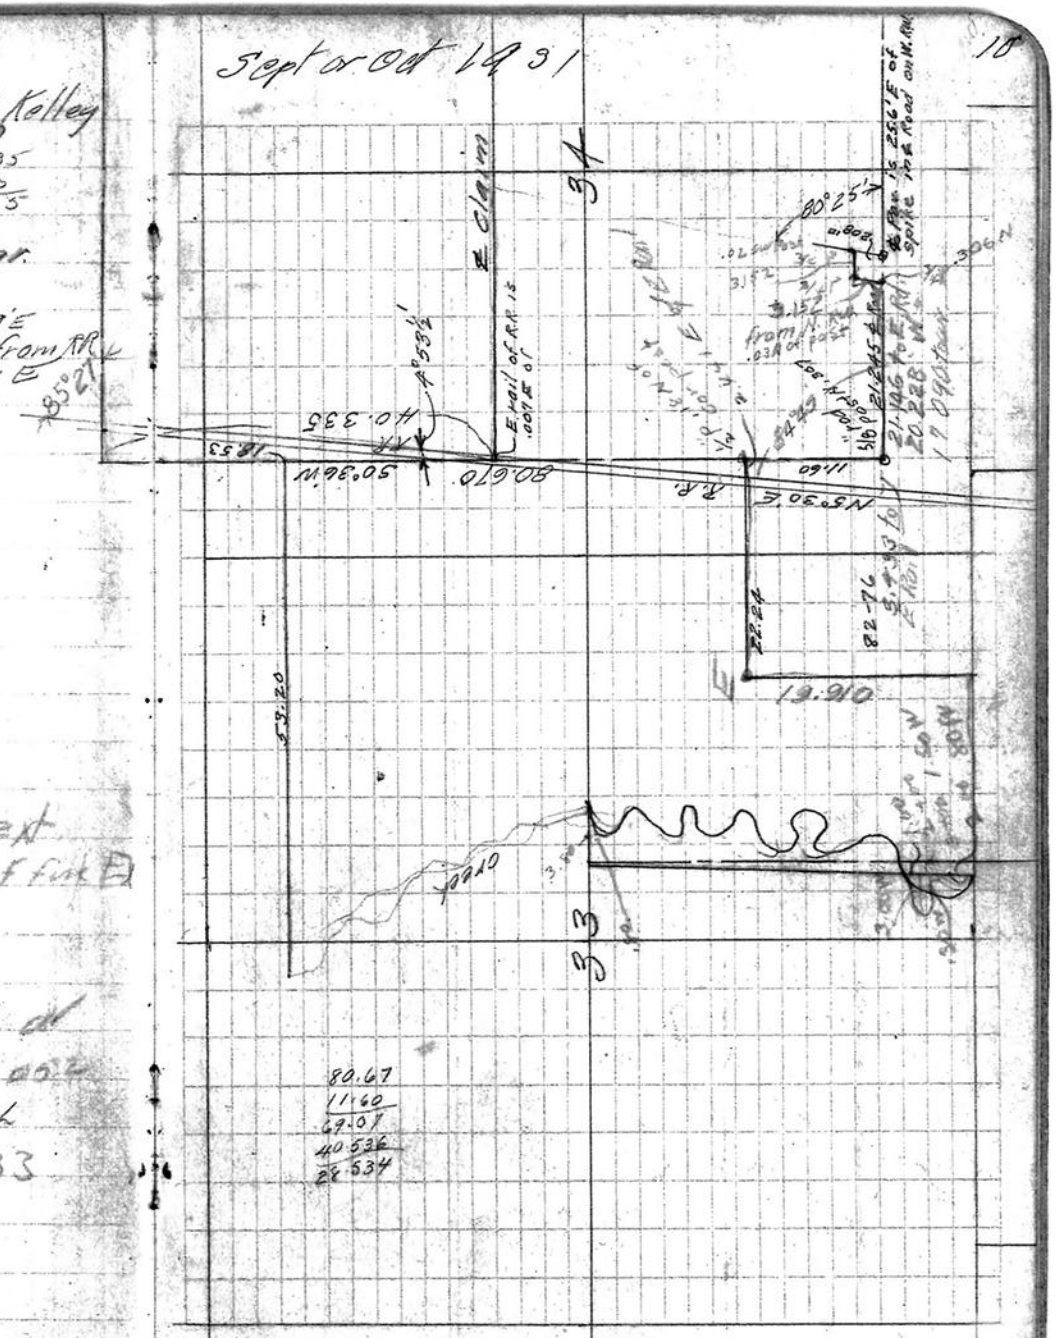
E Claim
E rail of R.R. is .09 E of
4°53½'
40.335
18.53
80.675
S0°36'W
11.60
N 30° E
R.R.
22.24
82.76
19.910
53.20
80°25'
21.805
21.146 to E R/W
20.228
1 Dgd Stone
Set ¾ pipe .04 N of fence ext and .03 E of fnk E
from N. .03 A
.06 N
3.15 E
3.15 E
3.15 E

Meanders of Cr

Began at pipe 150 W of NE Cor Slagle Cl.

3.80	East	
	± Cr	.80 S
1.20		
	± Cr	1.20 S +5.00 ±
		3.40 wide at +3.50
3.33	N23°E	
		± Cr .30 W
2.39	N3½°W	along ±
		± Cr. .40 R
3.14	N41°W	
D		± Cr. .40 E
3.77	N04°15'E	
		± Cr .60 R
2.10	N55½°E	+ 20 ± Cr
		1.20 R ± Cr.
9.40	N45°W	E 2.00 on ±
	Back to D	
3.79	N20°W	
		N75°E 4.00 ±
5.00	N12°W	
		6.00 N84°E ± Cr.
		4.50 N58°E
		5.20 N20°E

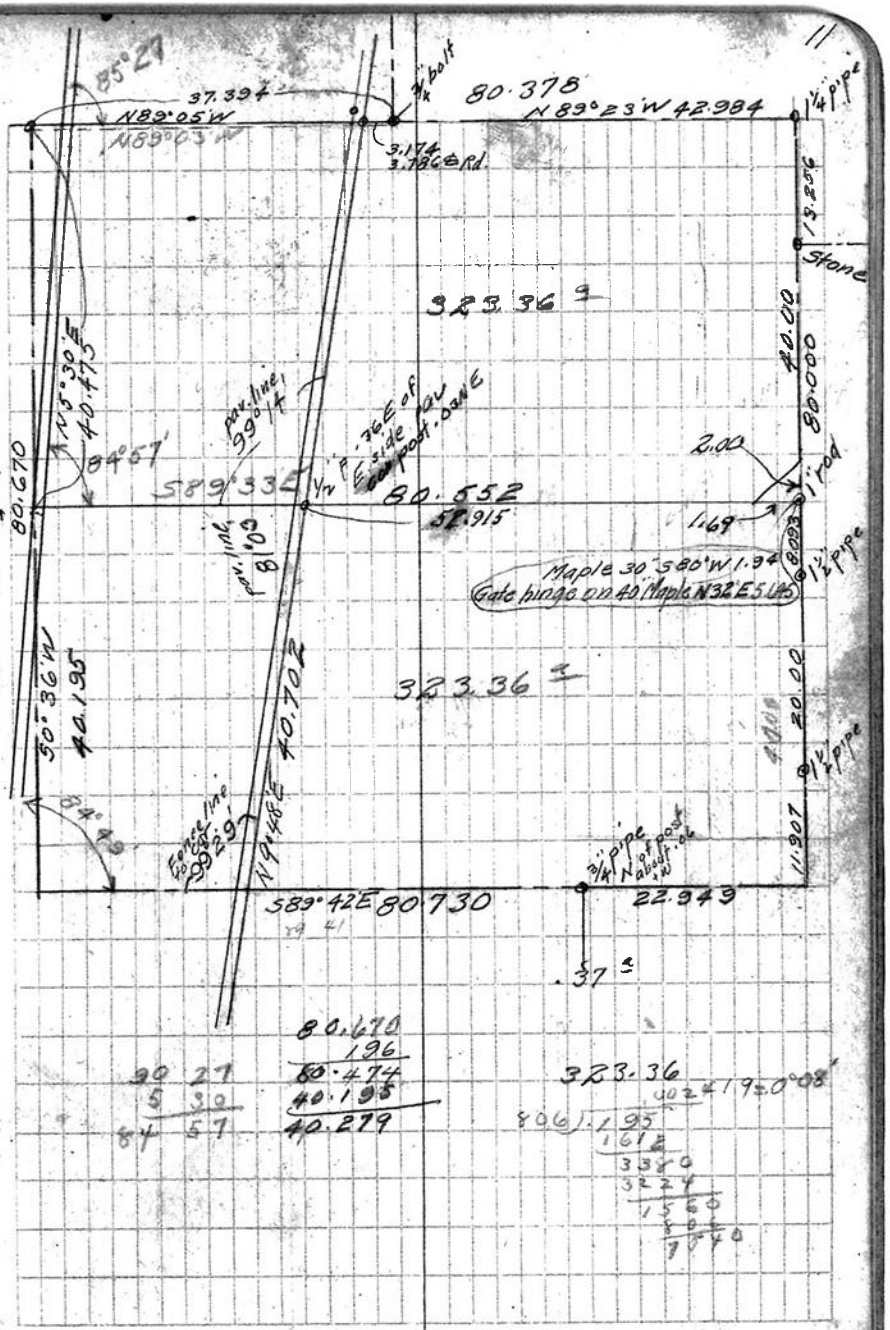

3.88 N38°W

Δ

Ł Cr. 1.50 R

N85°E Ł Cr

3.42 N18½°W

Δ

1.10 R Ł Cr

5.000 N2½°E

Δ

Ł Cr. 1.70 R 4.00 N24°E Ł Cr

3.69 N34°W

Δ

Ł Cr. 2.0 R N46°W Ł 3.00 Fence Ł