C.S. # 1171

Original Town of
Marysville
Block 21

F.B. 84-97

FB#84

Survey Nov 2, 1931 for Mrs Cowgill

1171

70-321 S½ Lot 8 + N 53' Lot 9

70-342?

73-345 Lot 7 + N' Lot 8 -

68-511 Arch Diocese of Oregon City Lots 1, 2, 3

74-311 Frederick Berchtold Lot 4

74-259 R + Mary DeMoss E½ of 5+6

70-25 Mary E. Bier W½ 5+6

73-345 Fred & Anna C. Fischer Lot 7 + N 8

41-620 H.M. Stone + Helen Cowgill S 28.9 of 5 & 2½ 9.

41-620 " " N 28.9 of 10 & 11

74-193 Needham, Adeliat Nathan S½ 10 & N 11

78-522 B.F. Bier W½ 5+6

Note Pipe at N.E. Cor is 2' E + 3½ S of S.E. Cor garage pipe on south line by woodshed could not set SE cor. in woodshed full of wood.

304.45
152.22

50.74
25.37
76.11

6 | 304.7
50.78
28.39
76.17
53.39
129.56

25.39
28.00
53.39


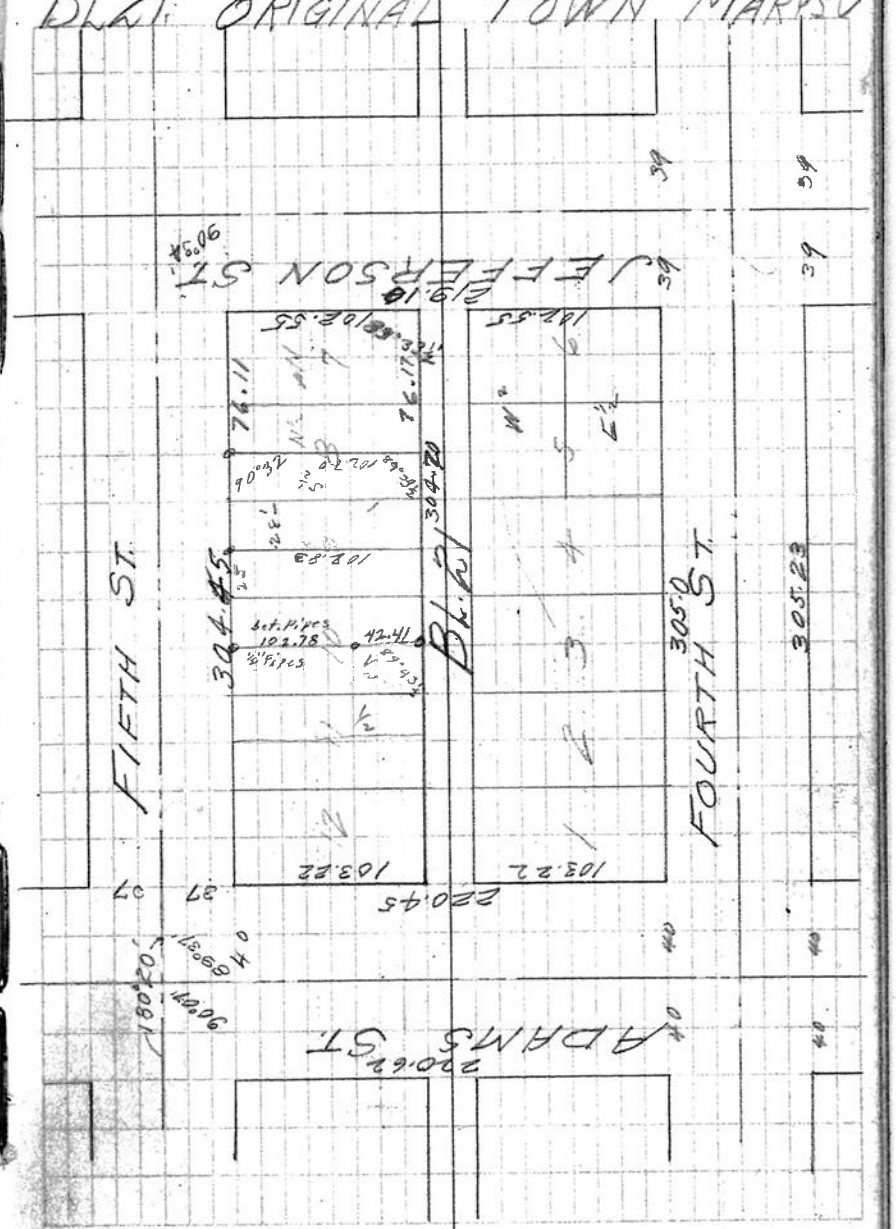
BL 21 ORIGINAL TOWN MARYSV