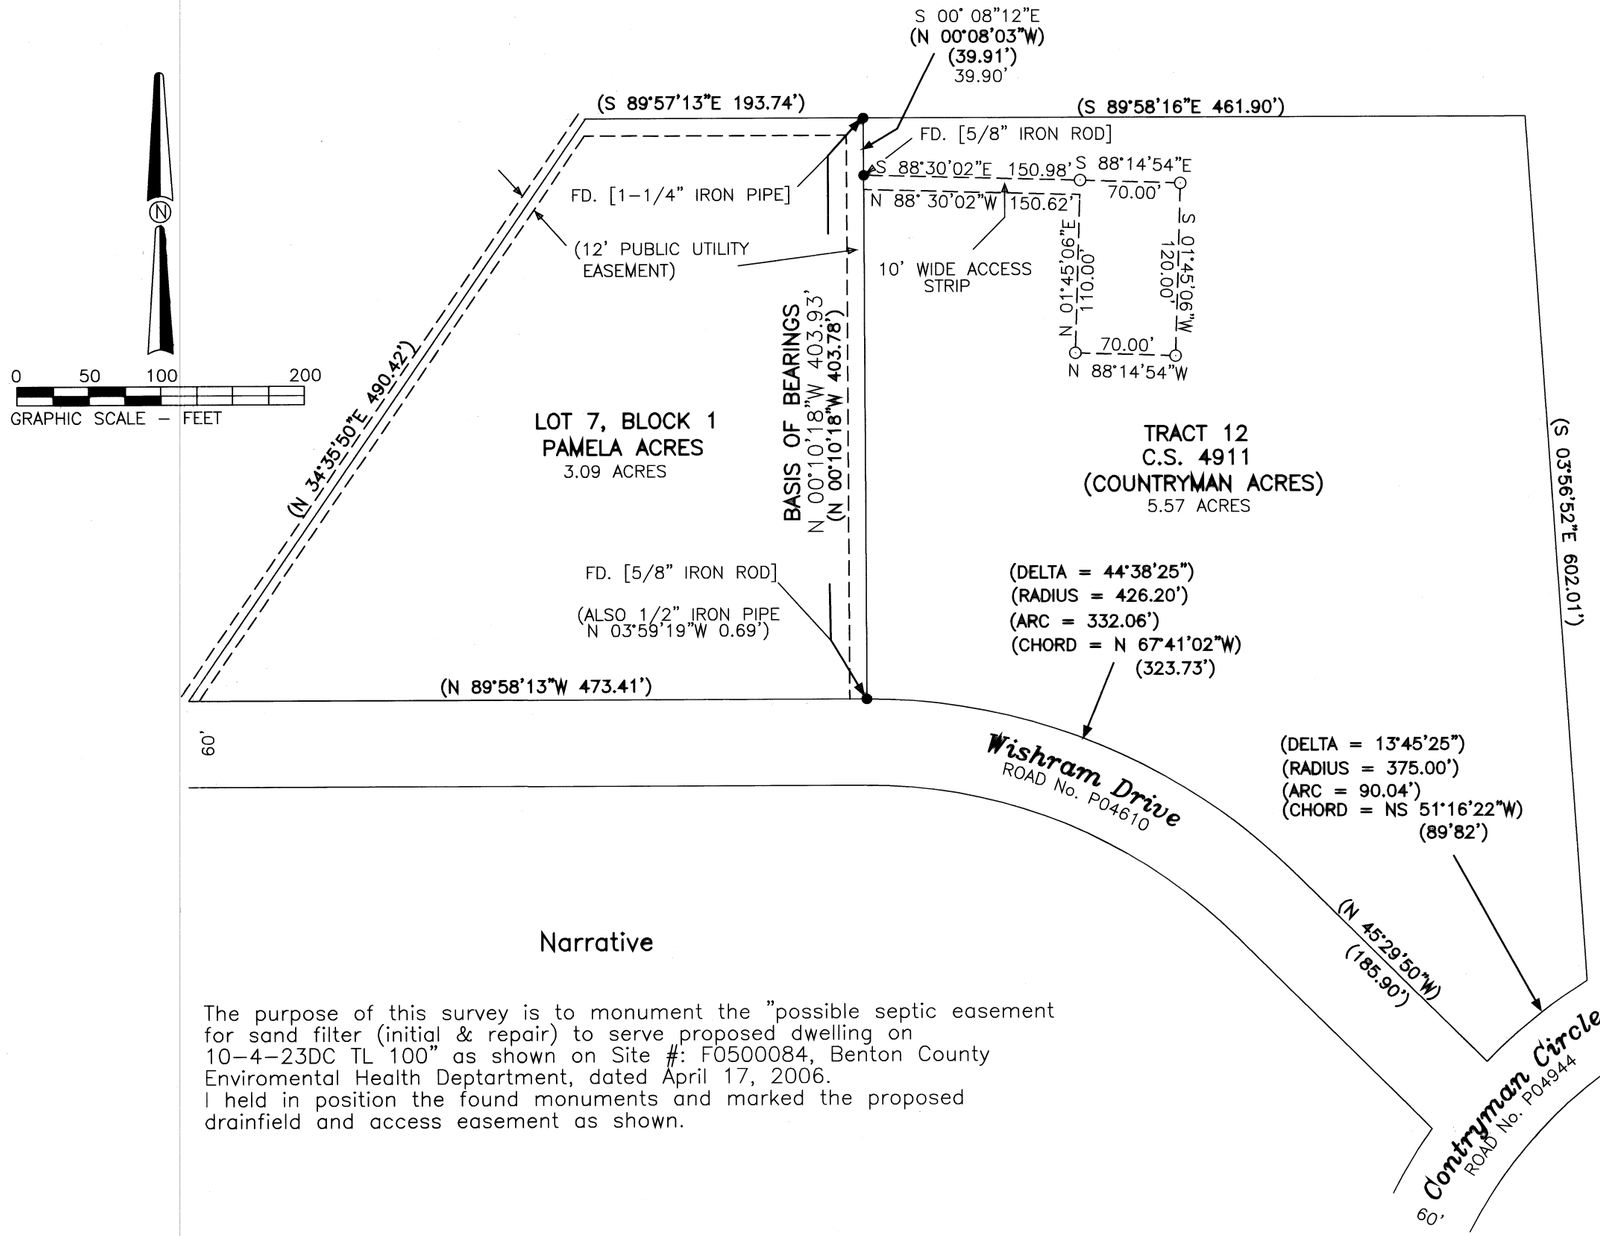

Benton County Surveyor's Office

C.S. FILE No. 10723

FILING DATE 7-27-15

FILE SIZE 11X17

MAP OF SURVEY
FOR

Geoffrey & Kaye Berg

JULY 22, 2015

IN THE S.E. 1/4 OF SECTION 23,
TOWNSHIP 10 SOUTH, RANGE 4 WEST, W.M.,
BENTON COUNTY, OREGON.

Legend

- ● MONUMENT FOUND, TYPE & SOURCE NOTED PIPES MEASURED INNER DIAMETER
- ○ SET 5/8" X 30" STEEL REBAR WITH BLUE PLASTIC CAP STAMPED "DARRYL HARMS, PLS 1079"
- ( ) RECORD DATA FROM C.S. 10068
- [ ] RECORD DATA FROM C.S. 4911 COUNTRYMAN ACRES

Narrative

The purpose of this survey is to monument the "possible septic easement for sand filter (initial & repair) to serve proposed dwelling on 10-4-23DC TL 100" as shown on Site #: F0500084, Benton County Enviromental Health Deptartment, dated April 17, 2006.
I held in position the found monuments and marked the proposed drainfield and access easement as shown.

REGISTERED
PROFESSIONAL
LAND SURVEYOR

Darryl W. Harms

OREGON
JULY 30,1976
DARRYL W. HARMS
1079

RENEWAL DATE: 6/30/17

DARRYL W. HARMS, P.L.S.
P.O. BOX 1051
CORVALLIS, OR 97339
PHONE: (541) 745-3948
E-MAIL
darrylharms@proaxis.com