11

Block 25, Co. Addn & Fract. Blk.

C.S. For Jack Porter 1/23/37
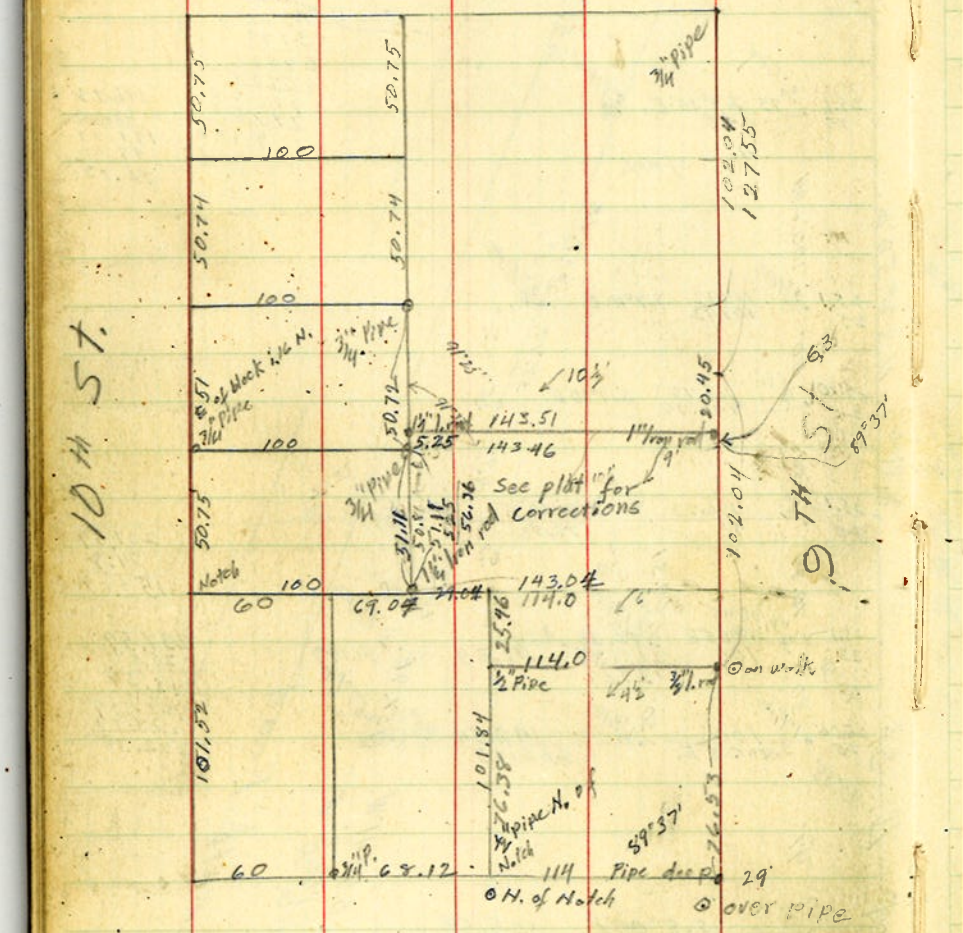
1310 Harrison St.