

C.S. # 2014

Hardcopy 15-5 #5

also see notes in file

F.B. 113-3











Sta

B.S.

H.I.

F.S.

Elev.

4.41

3620.3

1.63

3604.0

364.81

1.16

363.65

on spike N. of  
18" oak side to red  
so. NW of pine  
tree

5.92

368.85

1.88

362.93

3.74

368.38

4.21

364.64

7.53

360.85

on spike  
E. of C. P.P.  
18. E. of P.P.

11.05

379.27

1.6

368.22

on 1. rod

12.22

367.05

of pipe N.

of line fixed

11.58

390.84

.01

379.26

11.17

401.99

.02

390.82

11.85

413.83

.01

401.98

11.86

425.64

.05

413.78

11.67

437.31

.00

425.64

11.90

449.19

.02

437.29

Δ 37

11.95

461.12

11.54

437.65

on iron  
Δ 37

.02

449.17

Sta.	B.S.	I.I.	F.S.	Elev.	
	12.06	461.12	.04	461.08	
	11.93	473.14	.07	473.07	
Δ 36-4		415.00	8.49	476.51	on 6" board
	11.36	496.35	.01	484.99	
	11.37	507.70	.02	496.33	
Δ 35		519.18	4.20	503.50	on nail in stake
	11.62	531.08	.14	507.56	left spike
	11.92	543.04	.02	519.16	
	11.96	555.01	.00	531.08	
	11.99	550.11	.02	543.02	
	11.37	566.36	4.90	559.99	
	7.68	573.91	.02	554.99	
	12.08	585.92	.13	566.23	
			.07	573.84	

May 29, 1948,  
 Mr. G. J. Dave Schoppert  
 and W. N. Carpenter



10 1/2 Sta.	B.S.	H.I.	F.S.	Elev.
	10.90	585.92	.02	585.90
	11.42	596.80	.14	596.66
Δ 31	13.89	608.08	3.78	604.30
			.35	607.73
	11.20	621.62	.00	621.62
		632.82	.31	632.51
Δ 30	11.46	644.28	.00	642.82
	11.26	655.54	.00	644.28
	11.61	667.07	.08	655.46
	11.69	678.71	.00	667.07
Δ 30 A	11.71	690.40	10.20	668.51
			.02	678.69
	11.30	701.70	.00	690.40
	12.12	713.82	.00	701.70

on stake  
40.1.00


on stake

spike  
3/4" bolt  
brack for 1" pipe line on Millers

49  
37  
12



Sta.	B.S.	H.I.	I.S.	Elev.	
11.50	713.82	725.31	.01	713.81	
11.10	736.26	736.26	10.26	715.05	8" Pipe on sec. line 4" Oak Stamp
10.90	747.16	747.16	.00	736.26	on
11.61	758.77	758.77	8.10	739.06	
11.58	770.30	770.30	.00	747.16	
11.45	781.35	781.35	.05	758.72	
11.77	793.06	793.06	7.55	762.75	on 3 1/2" rod N.W. cor Spring lot
11.94	804.21	804.21	.38	769.92	
11.08	815.19	815.19	.06	781.29	
11.38	826.37	826.37	.79	792.27	on 1/2" rod S.W. cor
			.10	804.11	
			7.21	807.98	
			.20	814.99	
			9.69	816.68	Car axle on N. line Spring lot

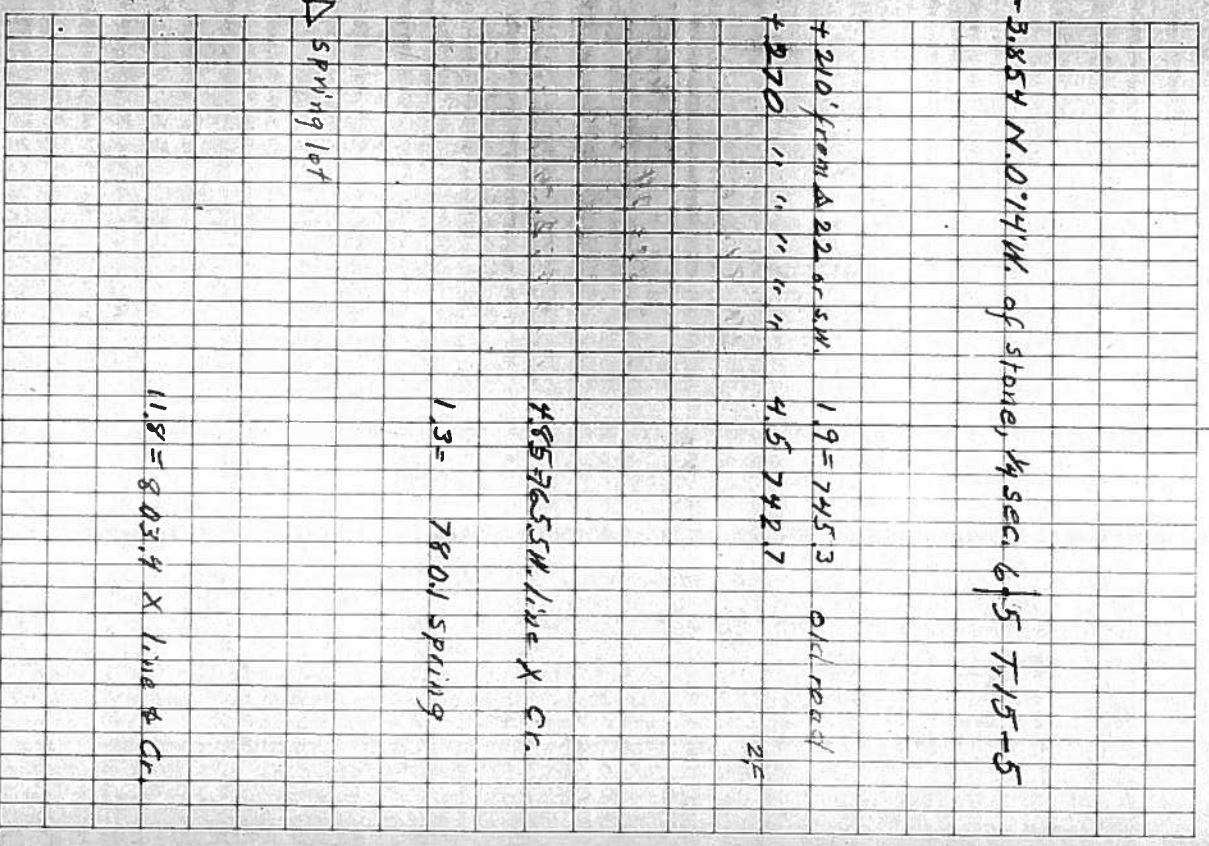

from pipe  
37' E 44.5  
+ 14' S. 11

:

826.37

837.77

849.40

860.88

872.49

883.03





















.16 826.21

.00 837.77

.27 849.13

.00 860.88

.20 872.29

9.74 873.29

9.23 873.80

10.74 872.29

oil 3/4" pipe  
28' W. line  
285' N. E. BM  
30' N. pipe, BM


873.80

End of Book