C.S. 283

M. O. WILKINSON

T. 10 S., R. 4 W.

SCALE: 1" = 100' AUGUST 1948

BERT W. UDELL
REG. ENGINEER
2134

Bert W. Udell

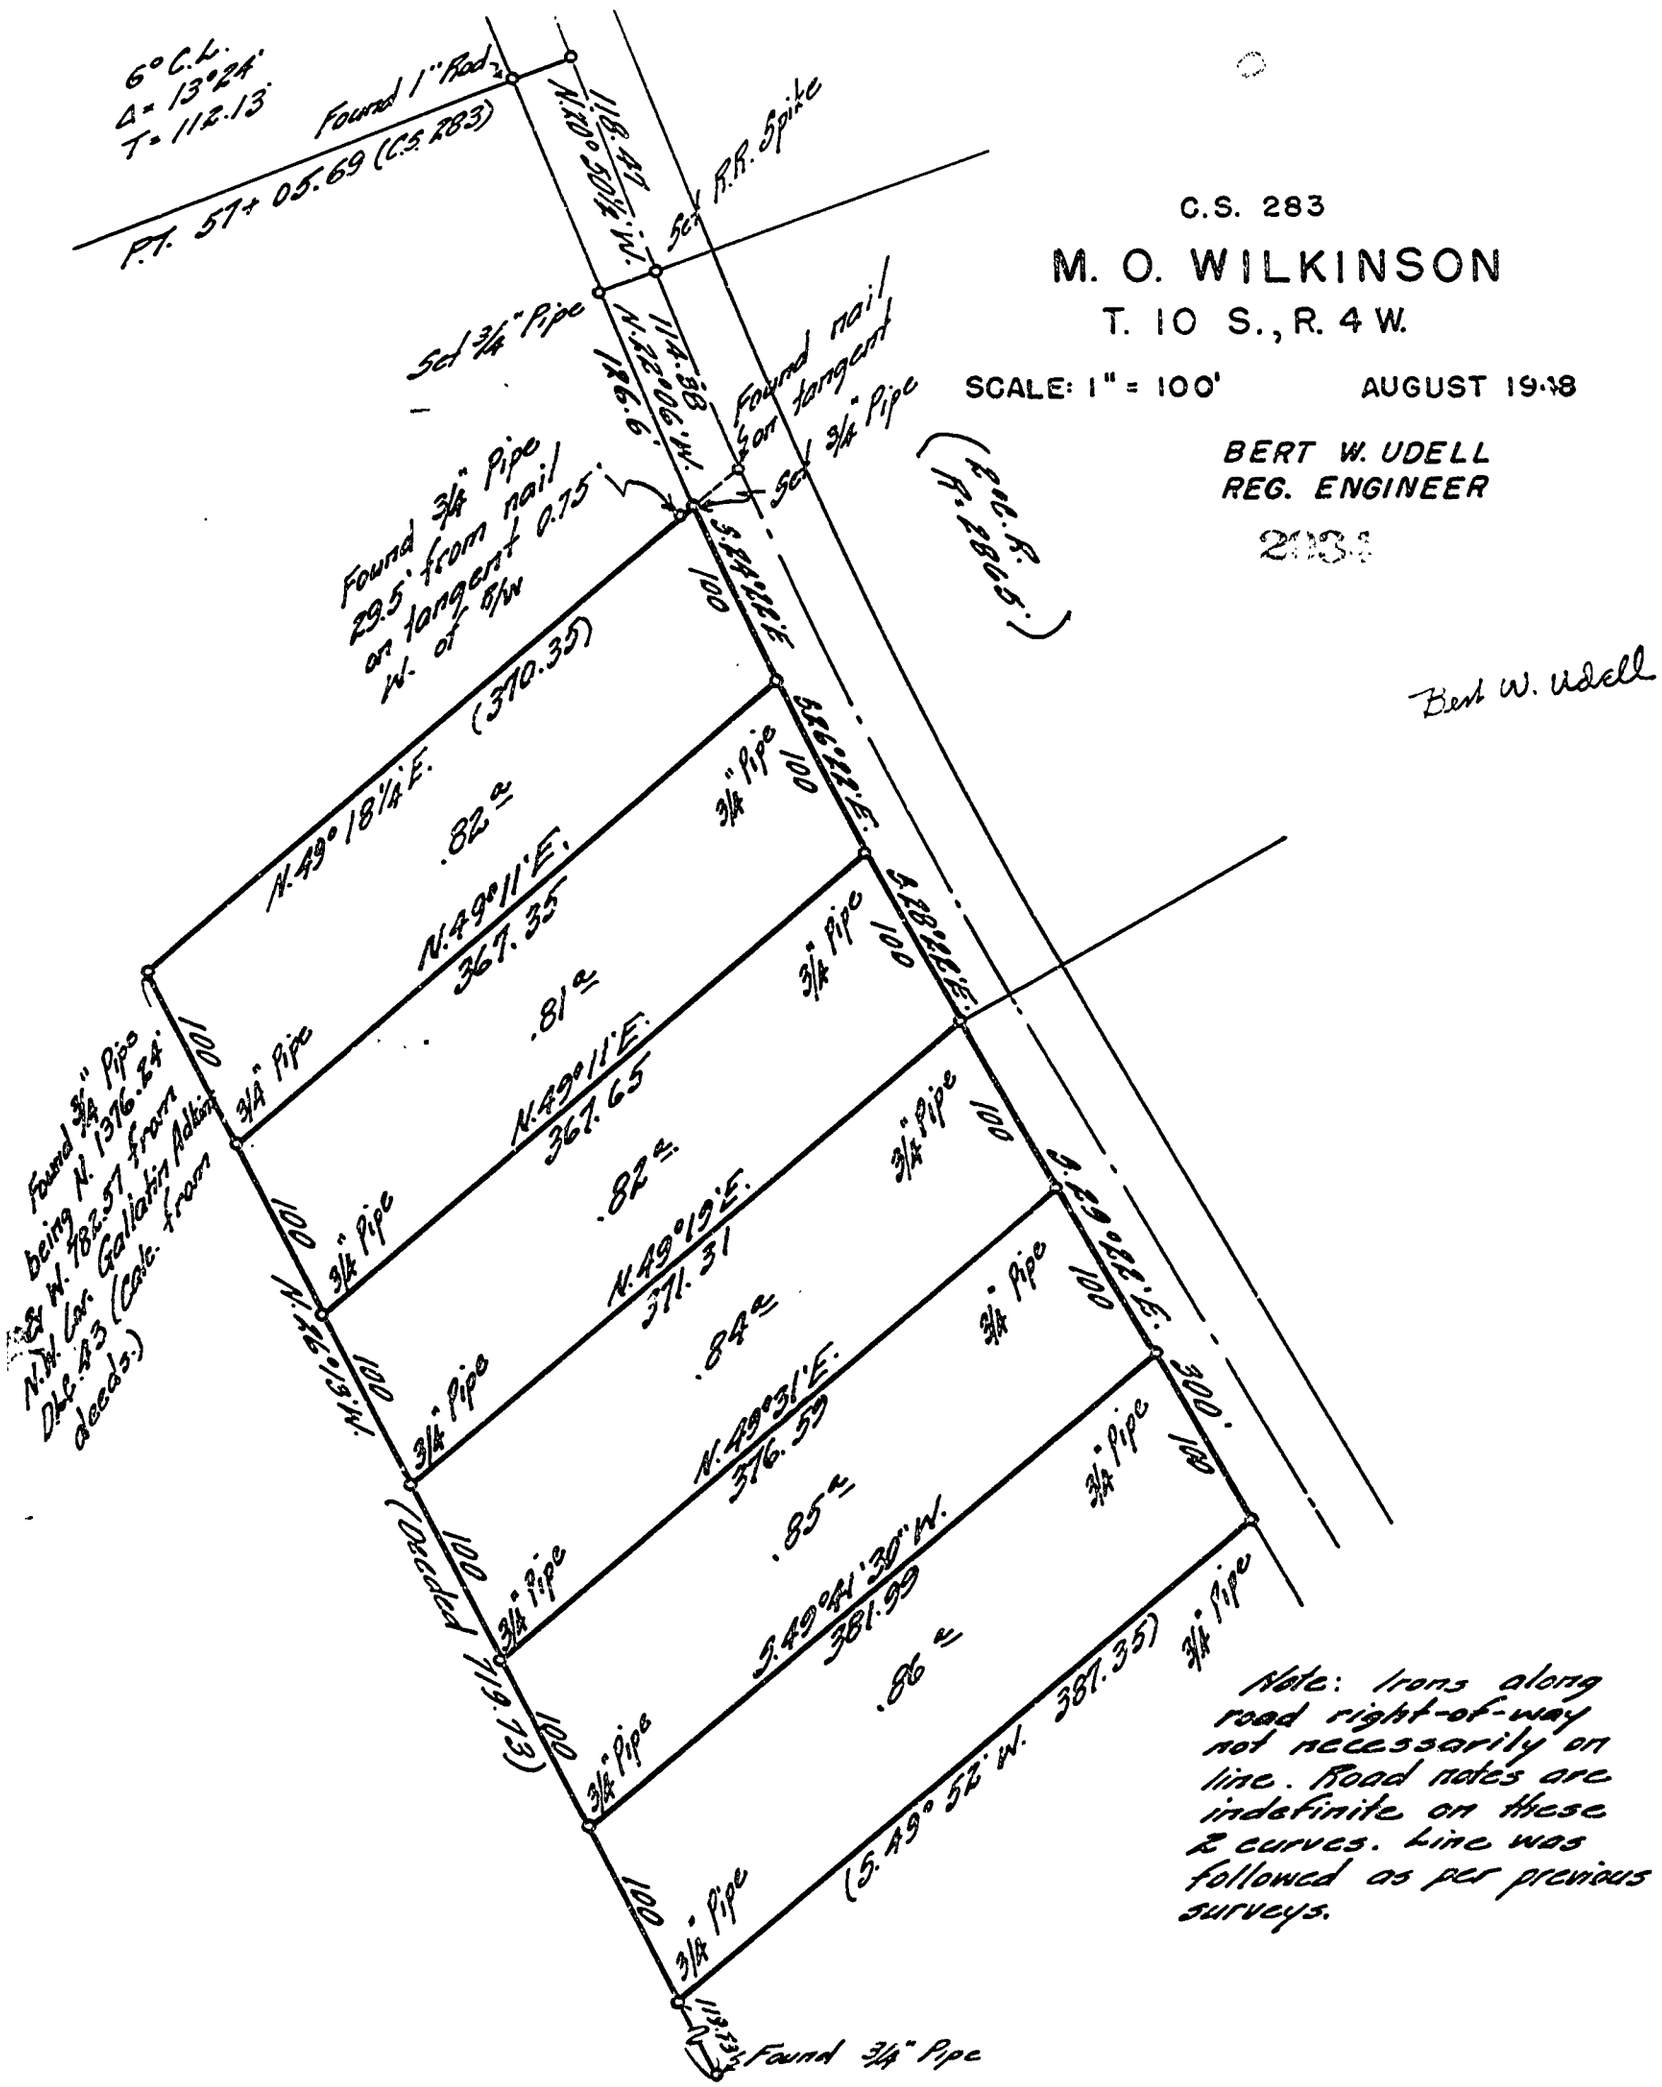

Note: Irons along road right-of-way not necessarily on line. Road notes are indefinite on these 2 curves. Line was followed as per previous surveys.