OTTO H. MEYER
CIVIL ENGINEER
621 North 35th Street
CORVALLIS, OREGON

Feb. 18, 1950

21.73

1" = 400'

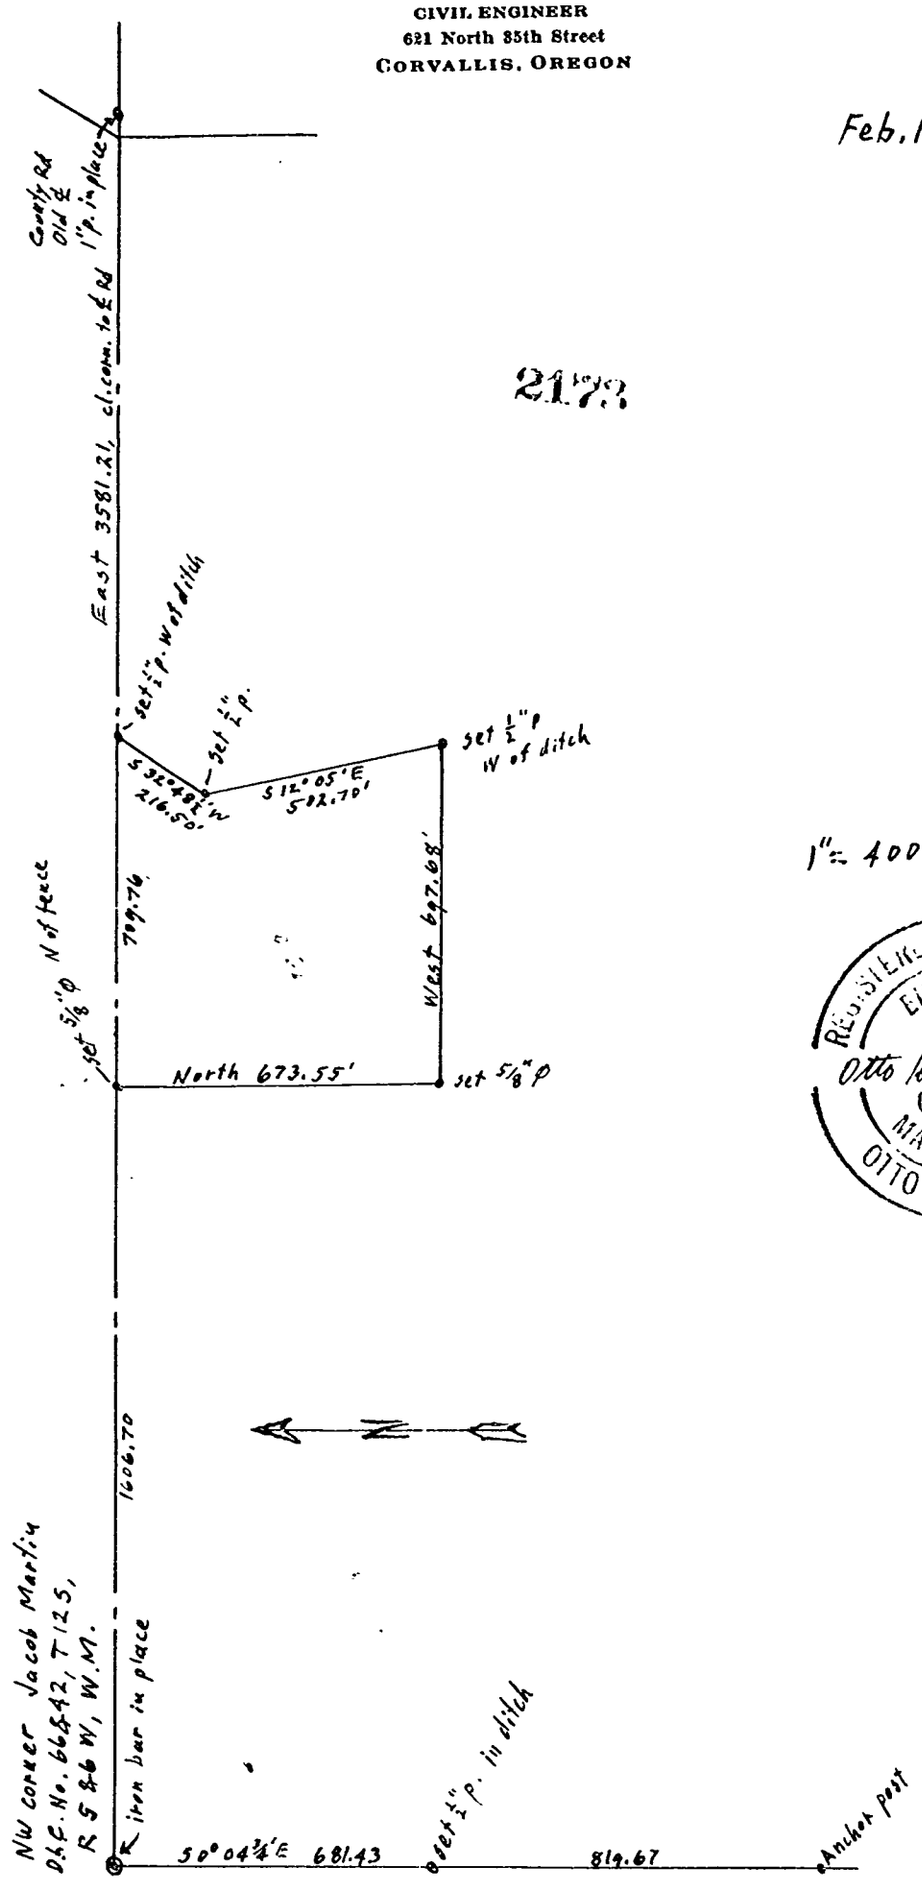

REGISTERED PROFESSIONAL ENGINEER 2152
Otto H. Meyer
OREGON
OTTO H. MEYER

OTTO H. MEYER
CIVIL ENGINEER
621 North 35th Street
CORVALLIS, OREGON

Feb. 18, 1950

2173

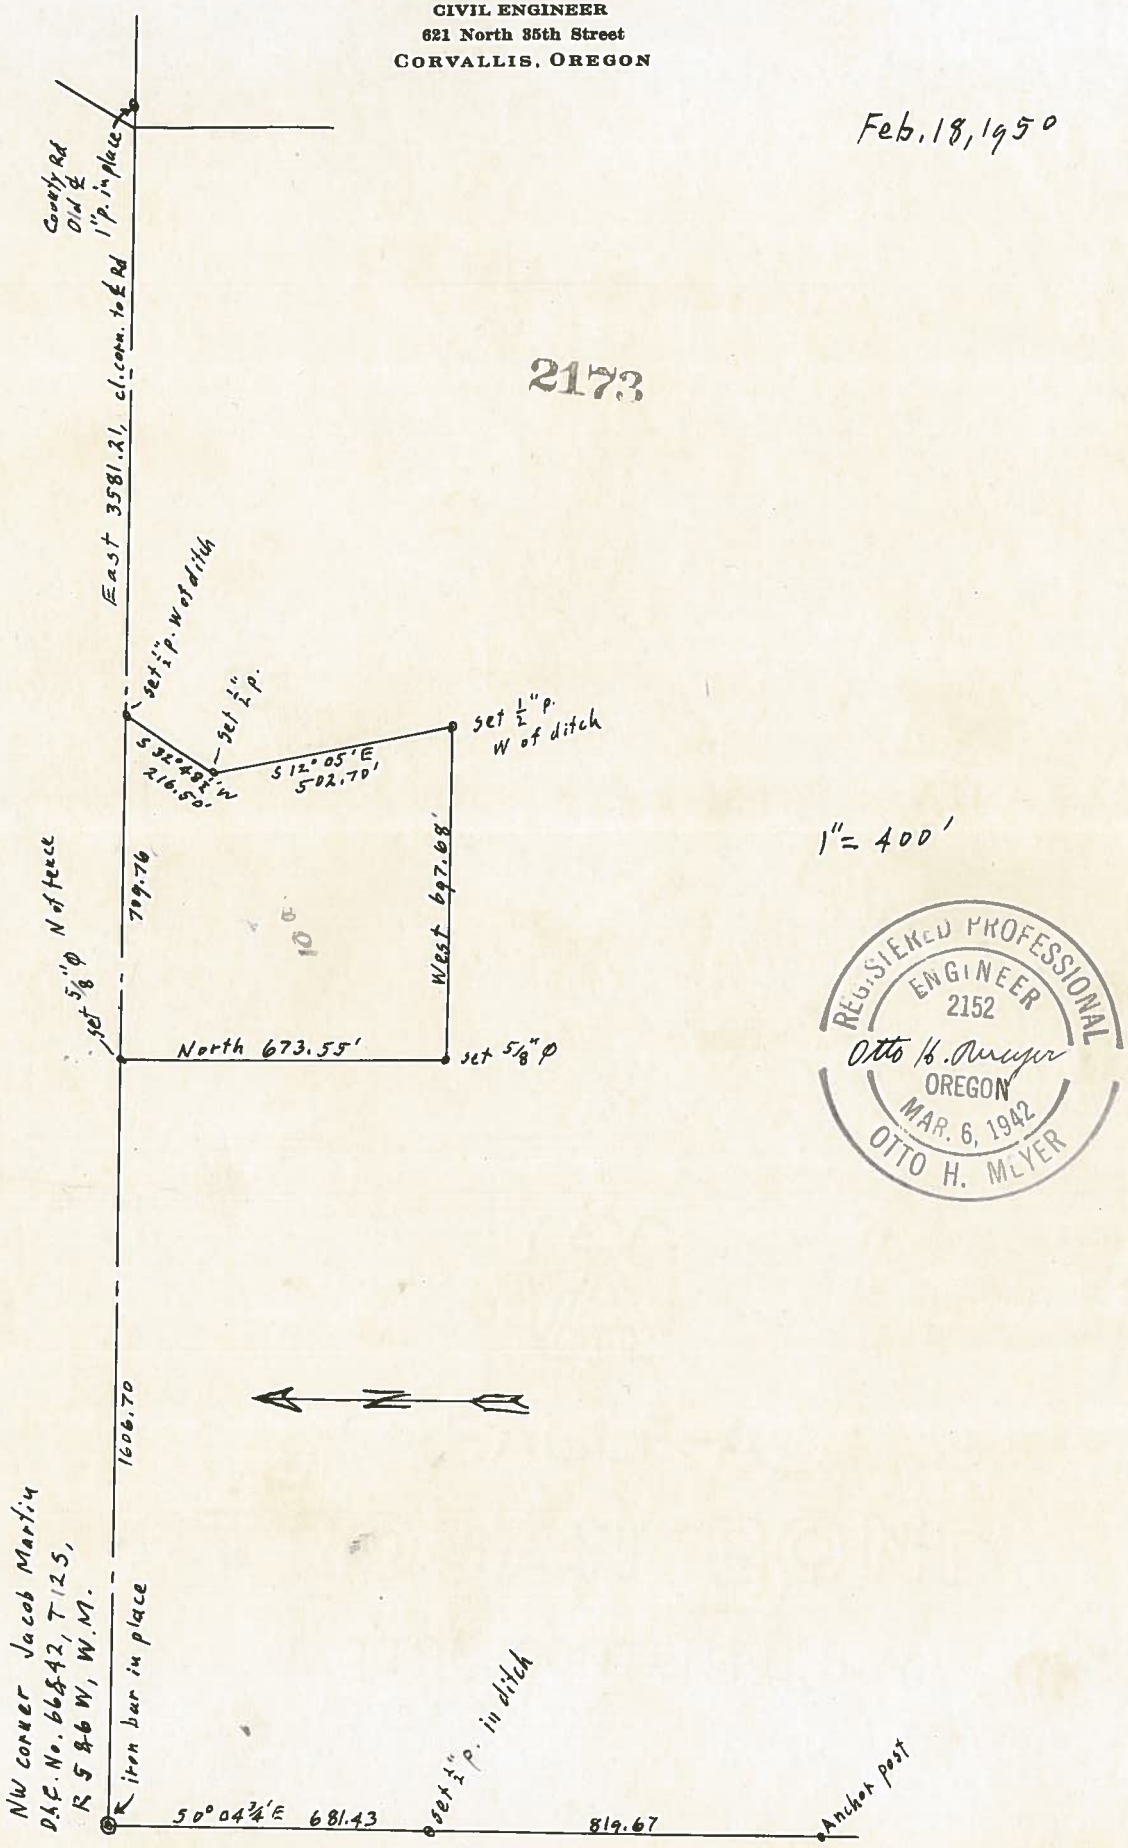

1" = 400'

REGISTERED PROFESSIONAL ENGINEER 2152
Otto H. Meyer
OREGON
MAR. 6, 1942
OTTO H. MEYER