WAYNE GIESY

JOS. C. AVERY D.L.C. No. 41, T.12 S., R.5 W., W.M.

Scale: 1" = 100' DECEMBER 22, 1953.

2533

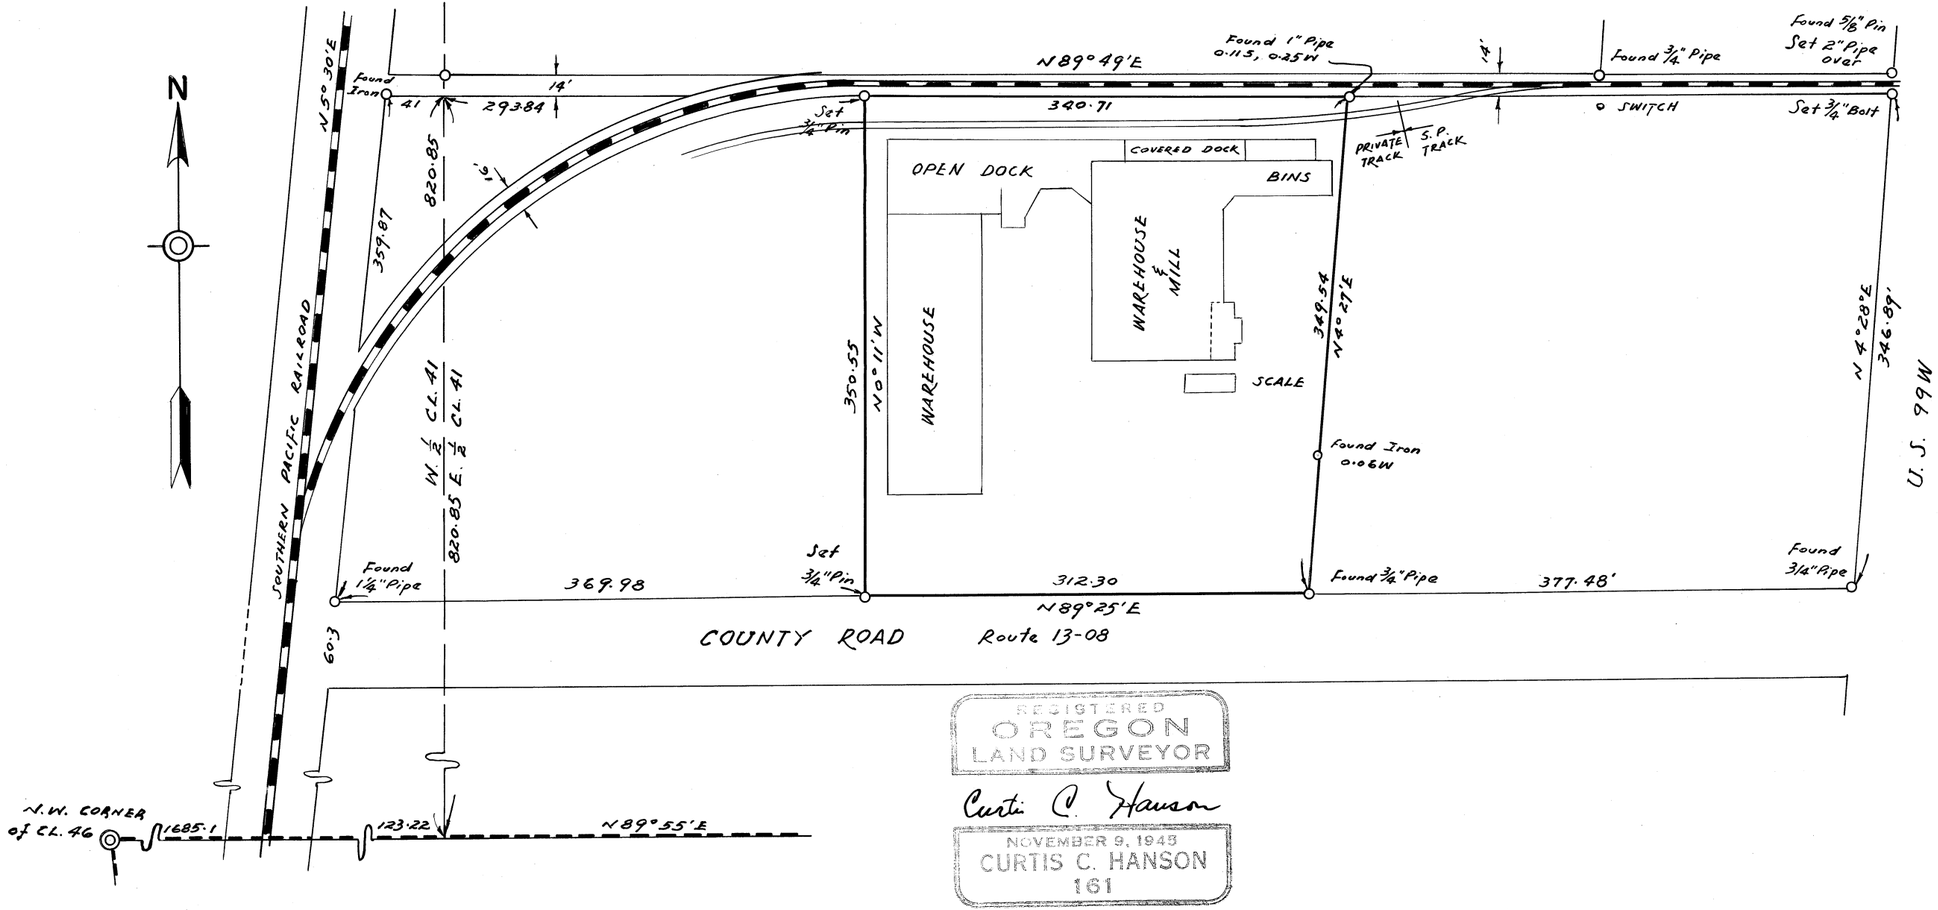

REGISTERED
OREGON
LAND SURVEYOR

Curtis C. Hanson

NOVEMBER 9, 1948
CURTIS C. HANSON
161