2560

ROYAL DOTY

JAMES A. BENNETT D.L.C. NO. 45, SEC. 10, T. 12 S., R. 5 W., WILL. MER.

Scale: 1" = 100'

April 10, 1954.

REGISTERED
OREGON
LAND SURVEYOR
Curtis C. Hanson
NOVEMBER 9, 1945
CURTIS C. HANSON
161

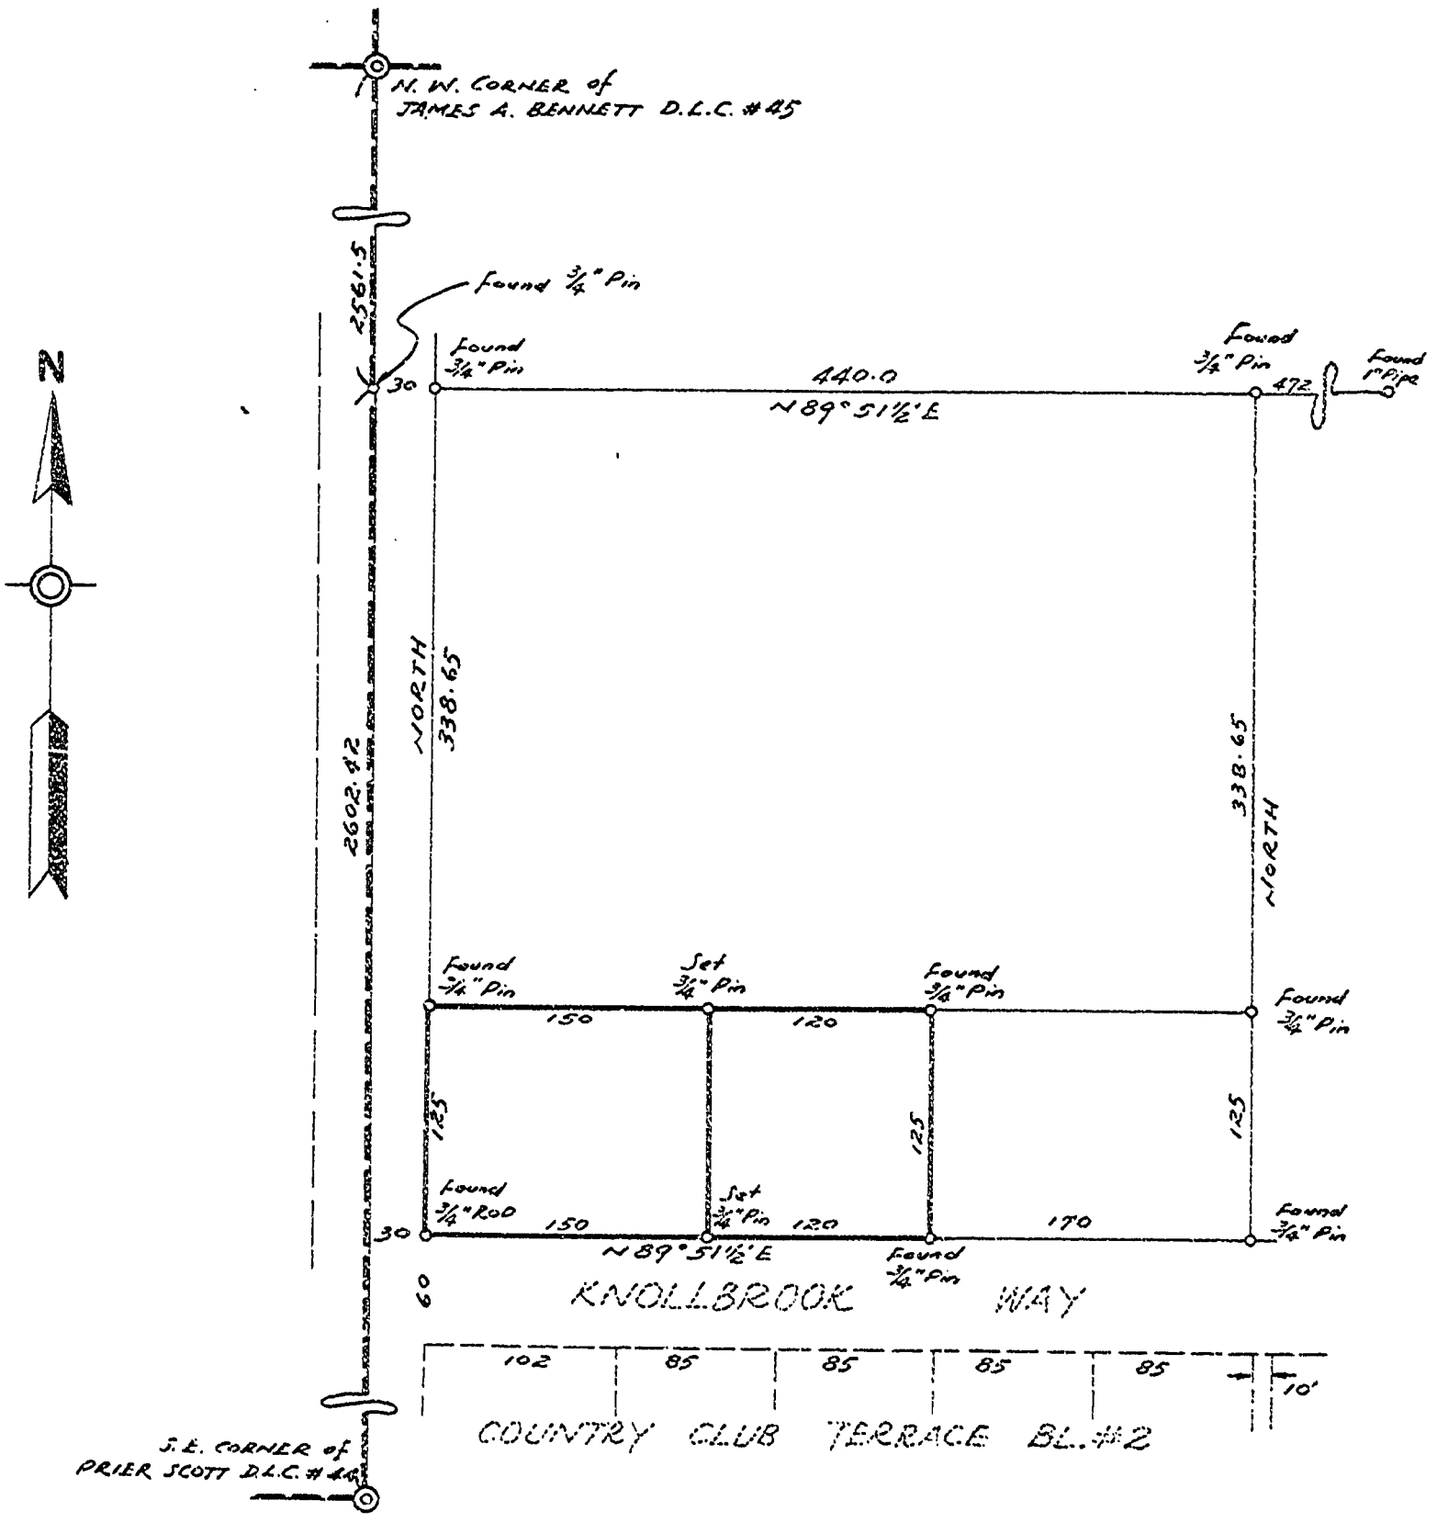

2560

ROYAL DOTY

JAMES A. BENNETT D.L.C. NO. 45, SEC. 10, T. 12 S., R. 5 W., WILL. MER.

Scale: 1" = 100'

April 10, 1954.
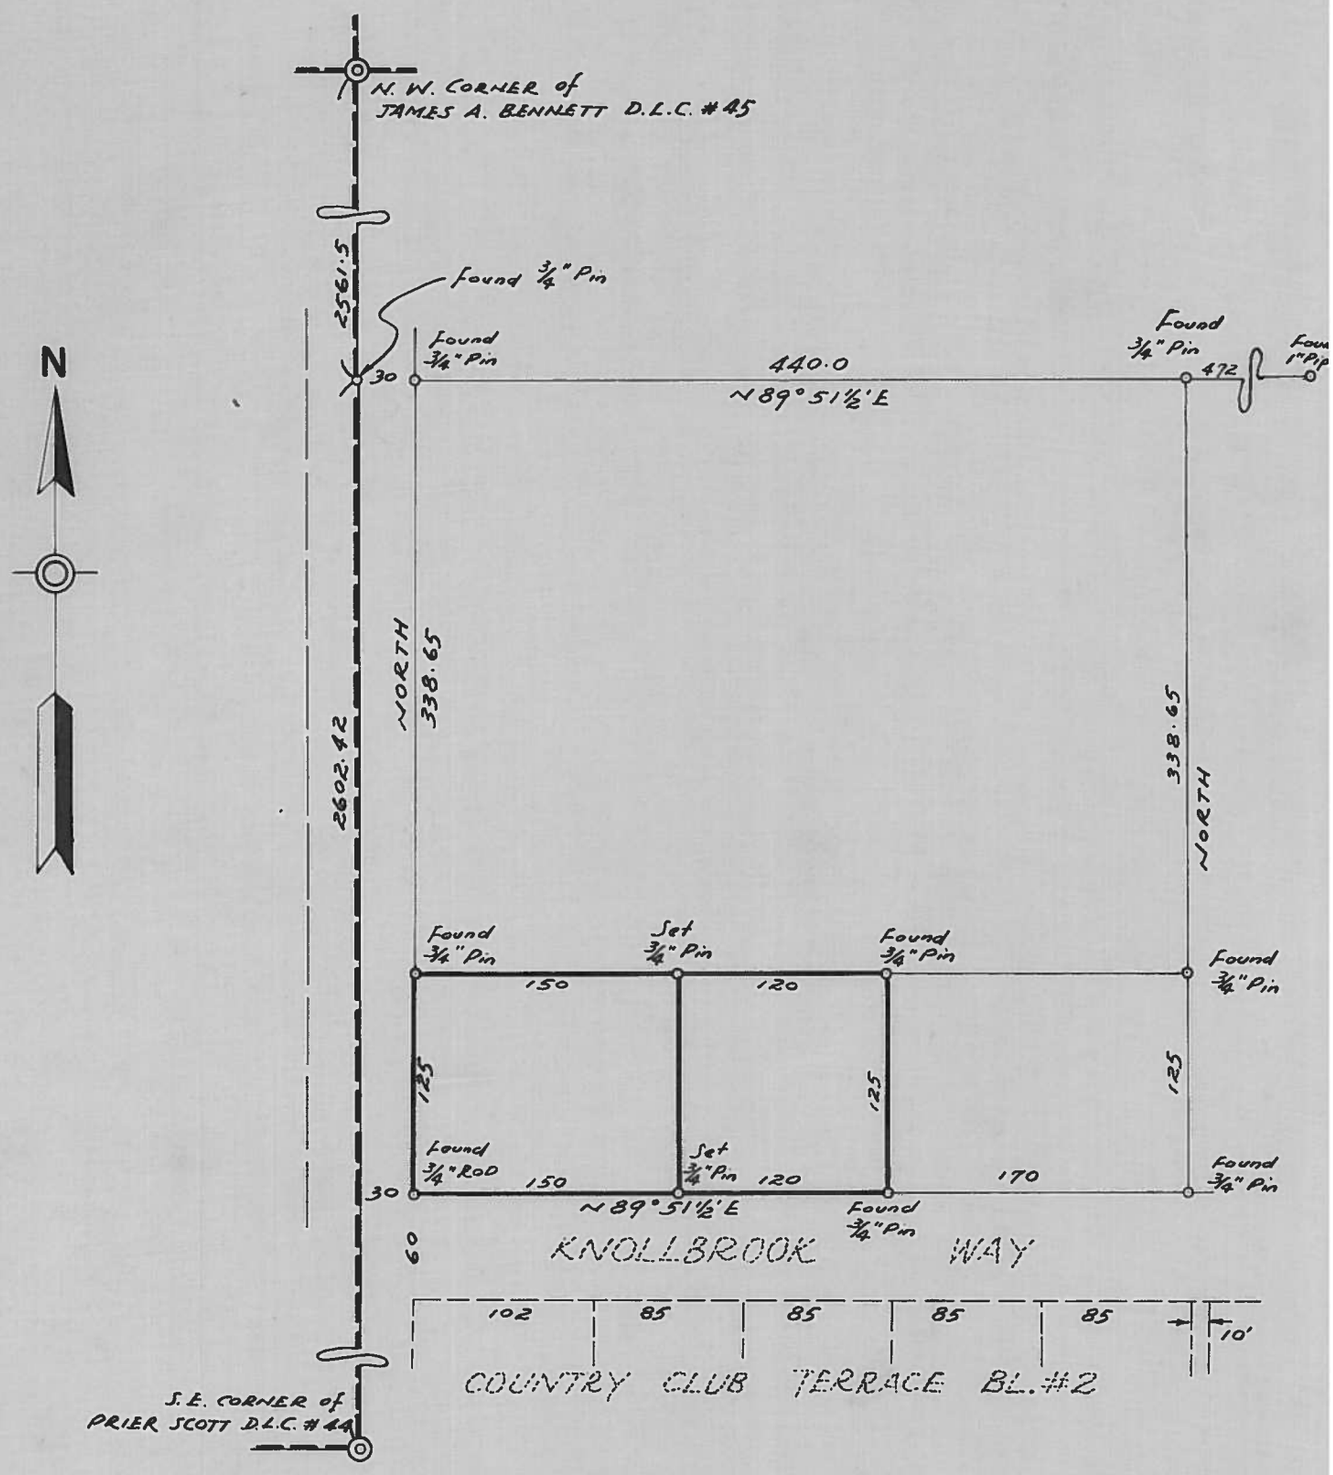
REGISTERED
OREGON
LAND SURVEYOR
Curtis C. Hanson
NOVEMBER 9, 1945
CURTIS C. HANSON
161