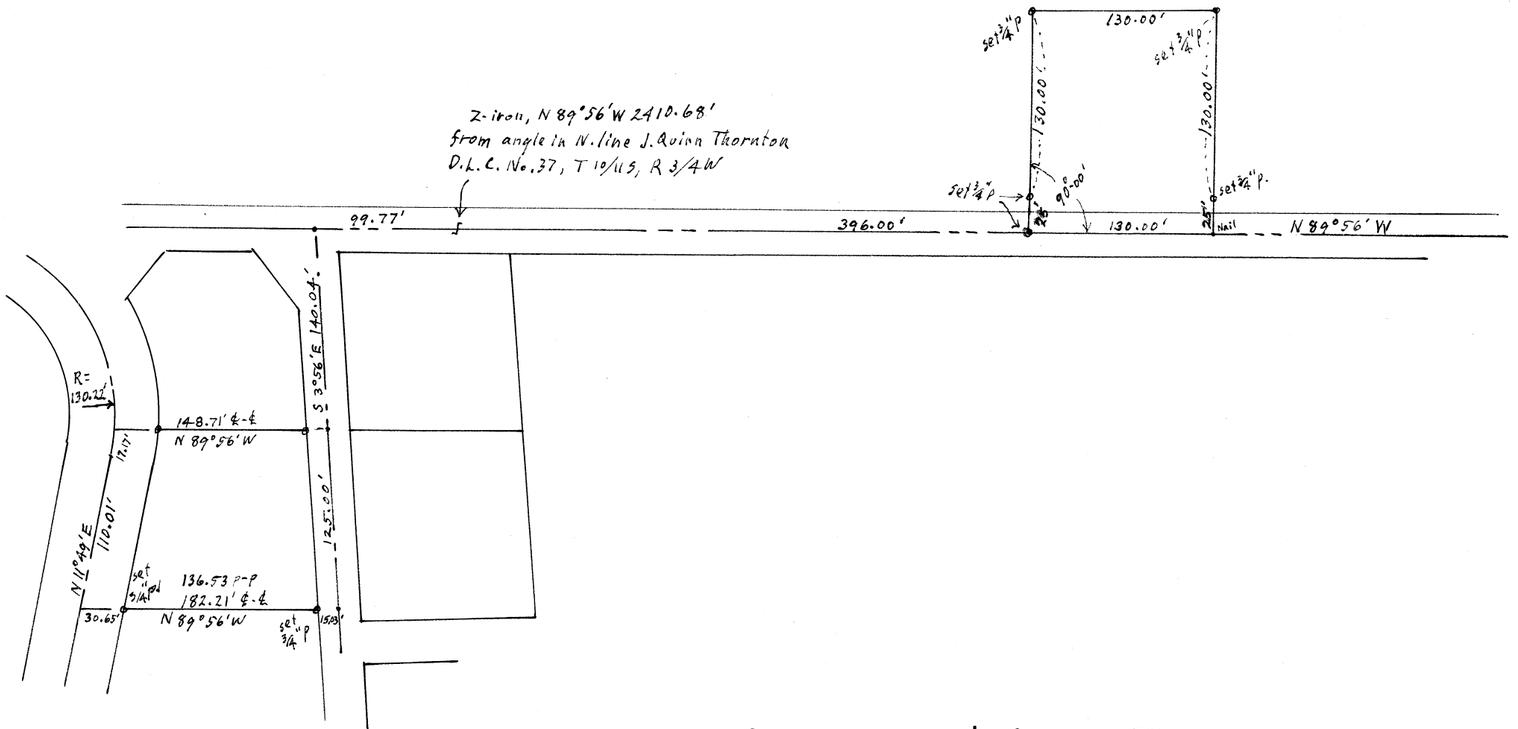

SURVEY IN J. QUINN THORNTON D.L.C.
FOR RUSSELL PARKER
Scale: 1" = 100'
Sept. 11, 1954

2612

REGISTERED PROFESSIONAL ENGINEER
2152
OREGON
MAR. 6, 1942
OTTO H. MEYER