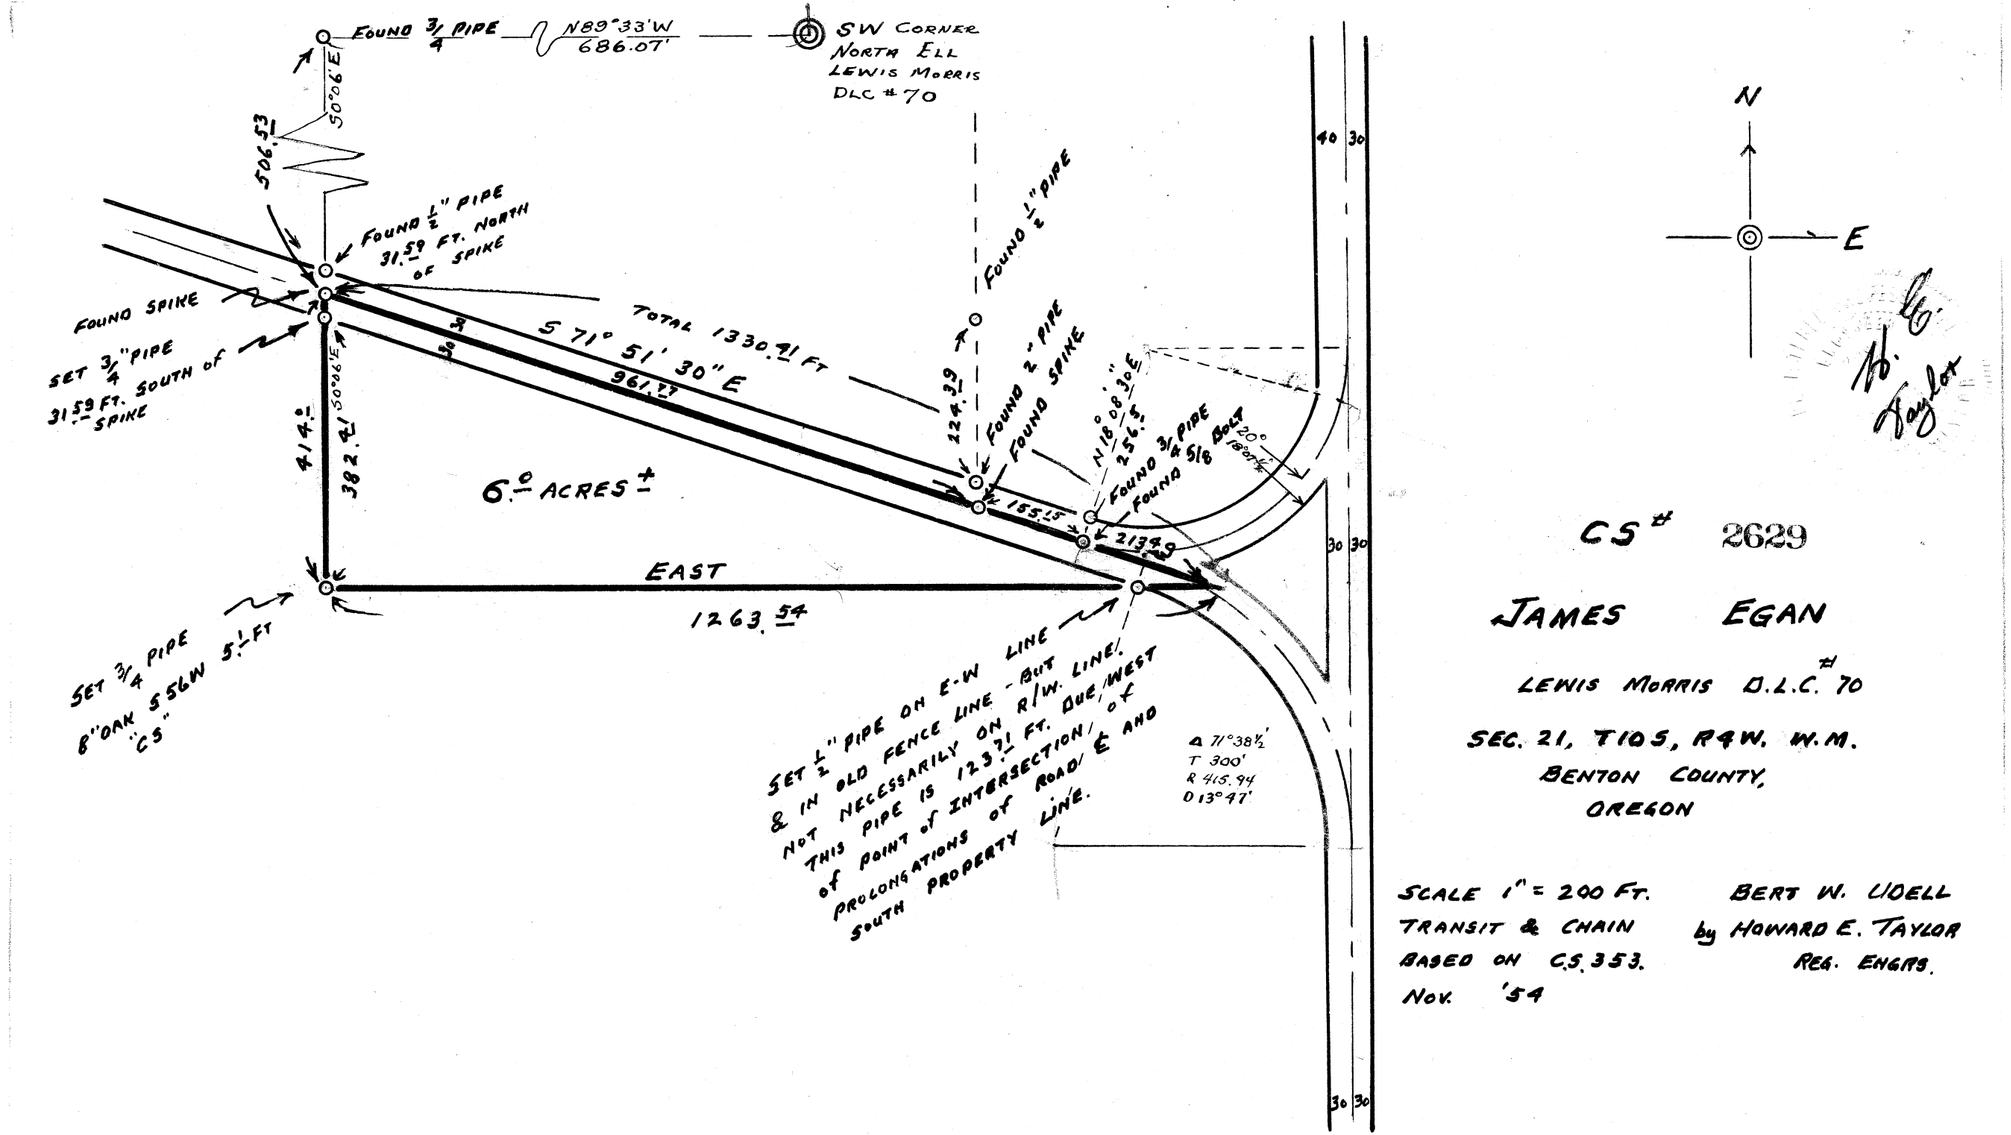

C.S. # 2629

JAMES EGAN

LEWIS MORRIS D.L.C. # 70

SEC. 21, T10S, R4W. W.M.

BENTON COUNTY,

OREGON

SCALE 1" = 200 FT.

TRANSIT & CHAIN

BASED ON C.S. 353.

NOV. '54

BERT W. LOELL

by HOWARD E. TAYLOR

REG. ENGRS.