2630

T. J. STARKER

Sec. 32, T. 12 S., R. 6 W., W.M.

Scale: 1" = 3 ch. Sept 17, 1954.

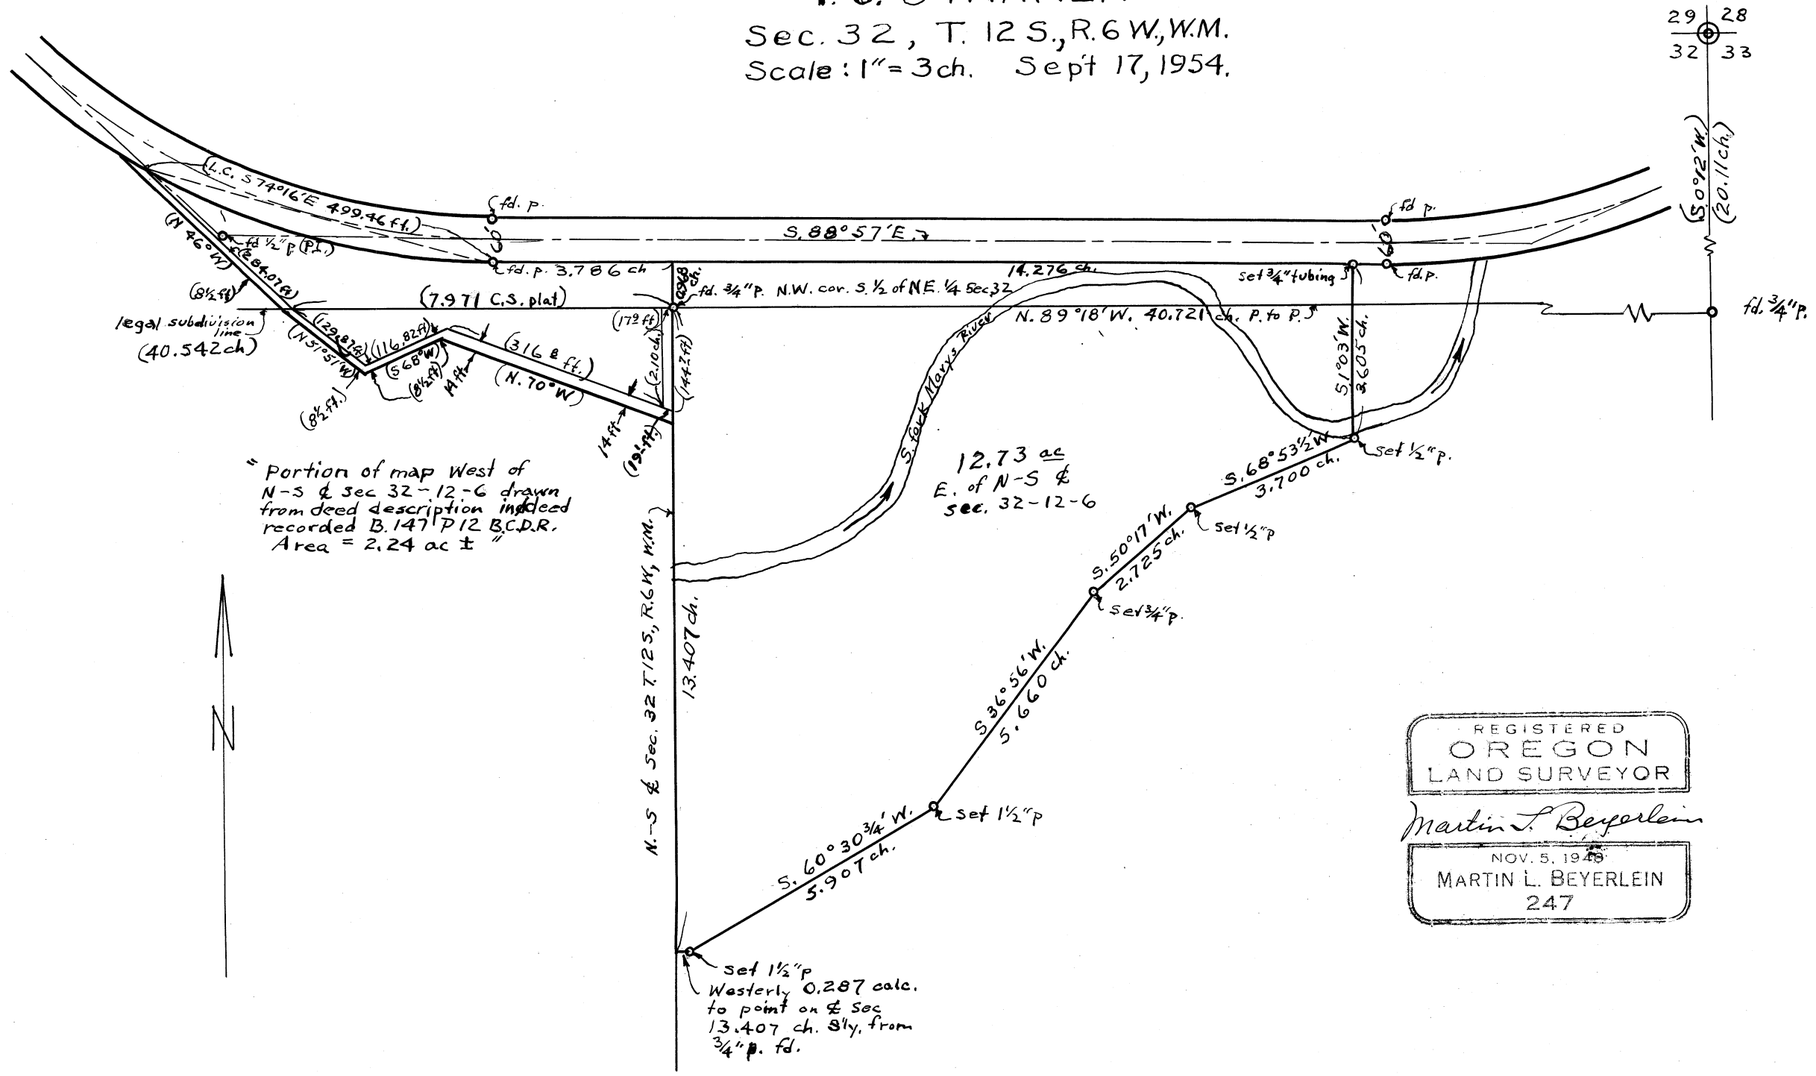

"Portion of map West of N-S ℄ Sec 32-12-6 drawn from deed description in deed recorded B. 147 P 12 B.C.D.R. Area = 2.24 ac ±"

REGISTERED
OREGON
LAND SURVEYOR

Martin L. Beyerlein

NOV. 5, 1949
MARTIN L. BEYERLEIN
247