2633

JOHN K. UNDERHILL

FARMLOT ONE, BROWN'S ADDITION, PHILOMATH, BENTON Co., ORE.

Scale: 1" = 100' Oct. 30, 1954.
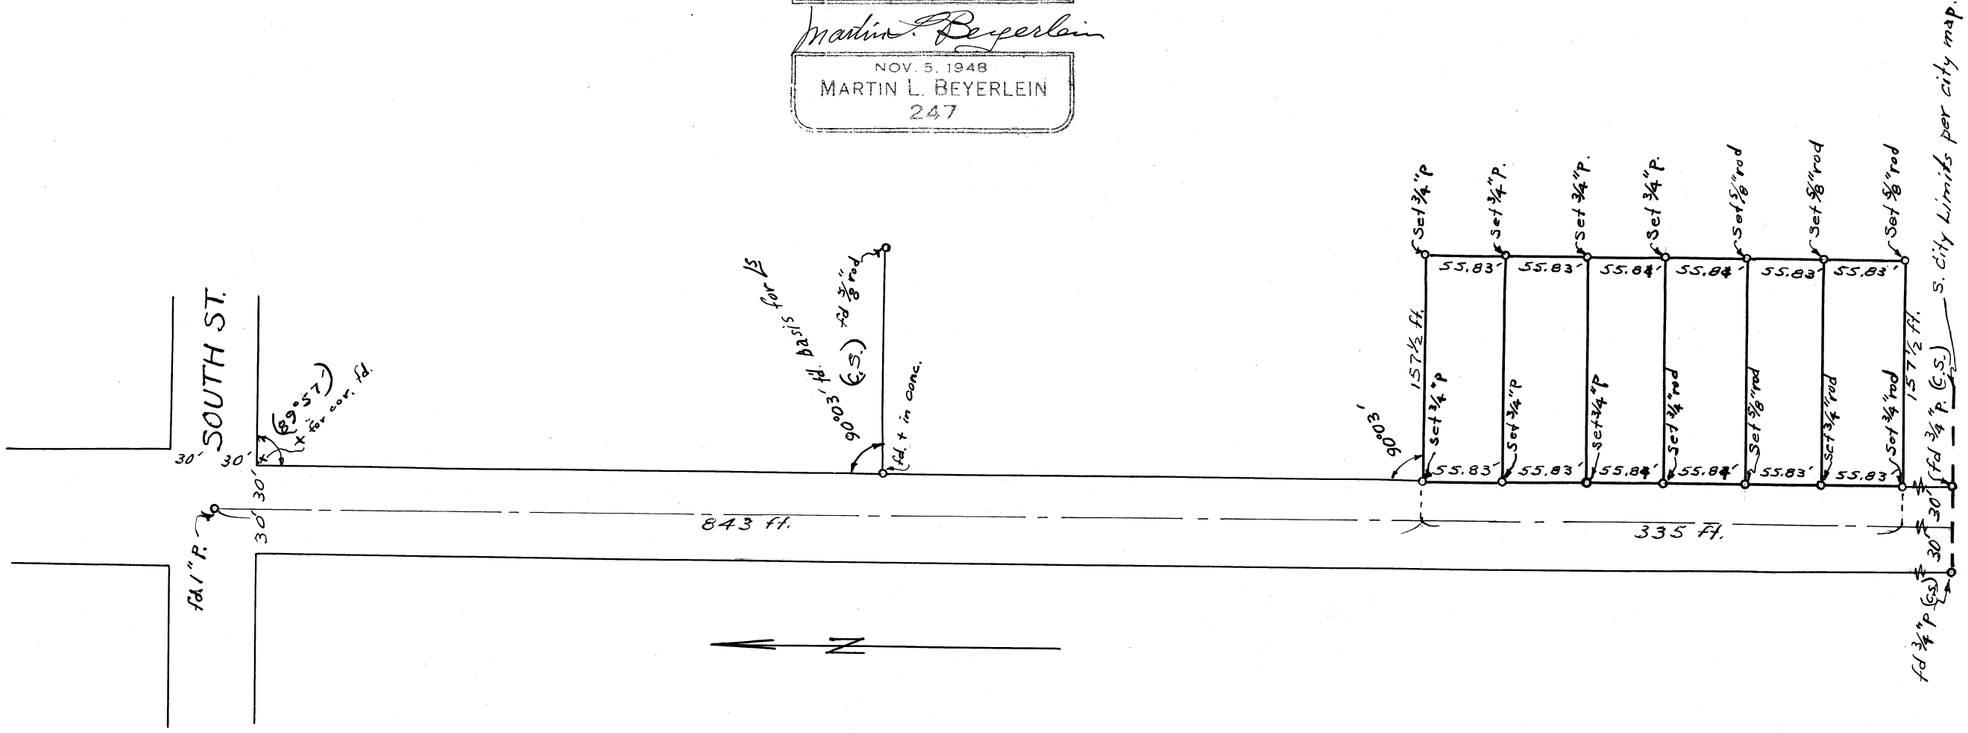
REGISTERED
OREGON
LAND SURVEYOR
Martin L. Beyerlein
NOV. 5, 1948
MARTIN L. BEYERLEIN
247