2642

MRS. AGNES FLINT

LOT 3, BLOCK 2, RAYBURN'S ADDITION TO CORVALLIS, OREGON

SCALE: 1"=50' NOVEMBER 30, 1954
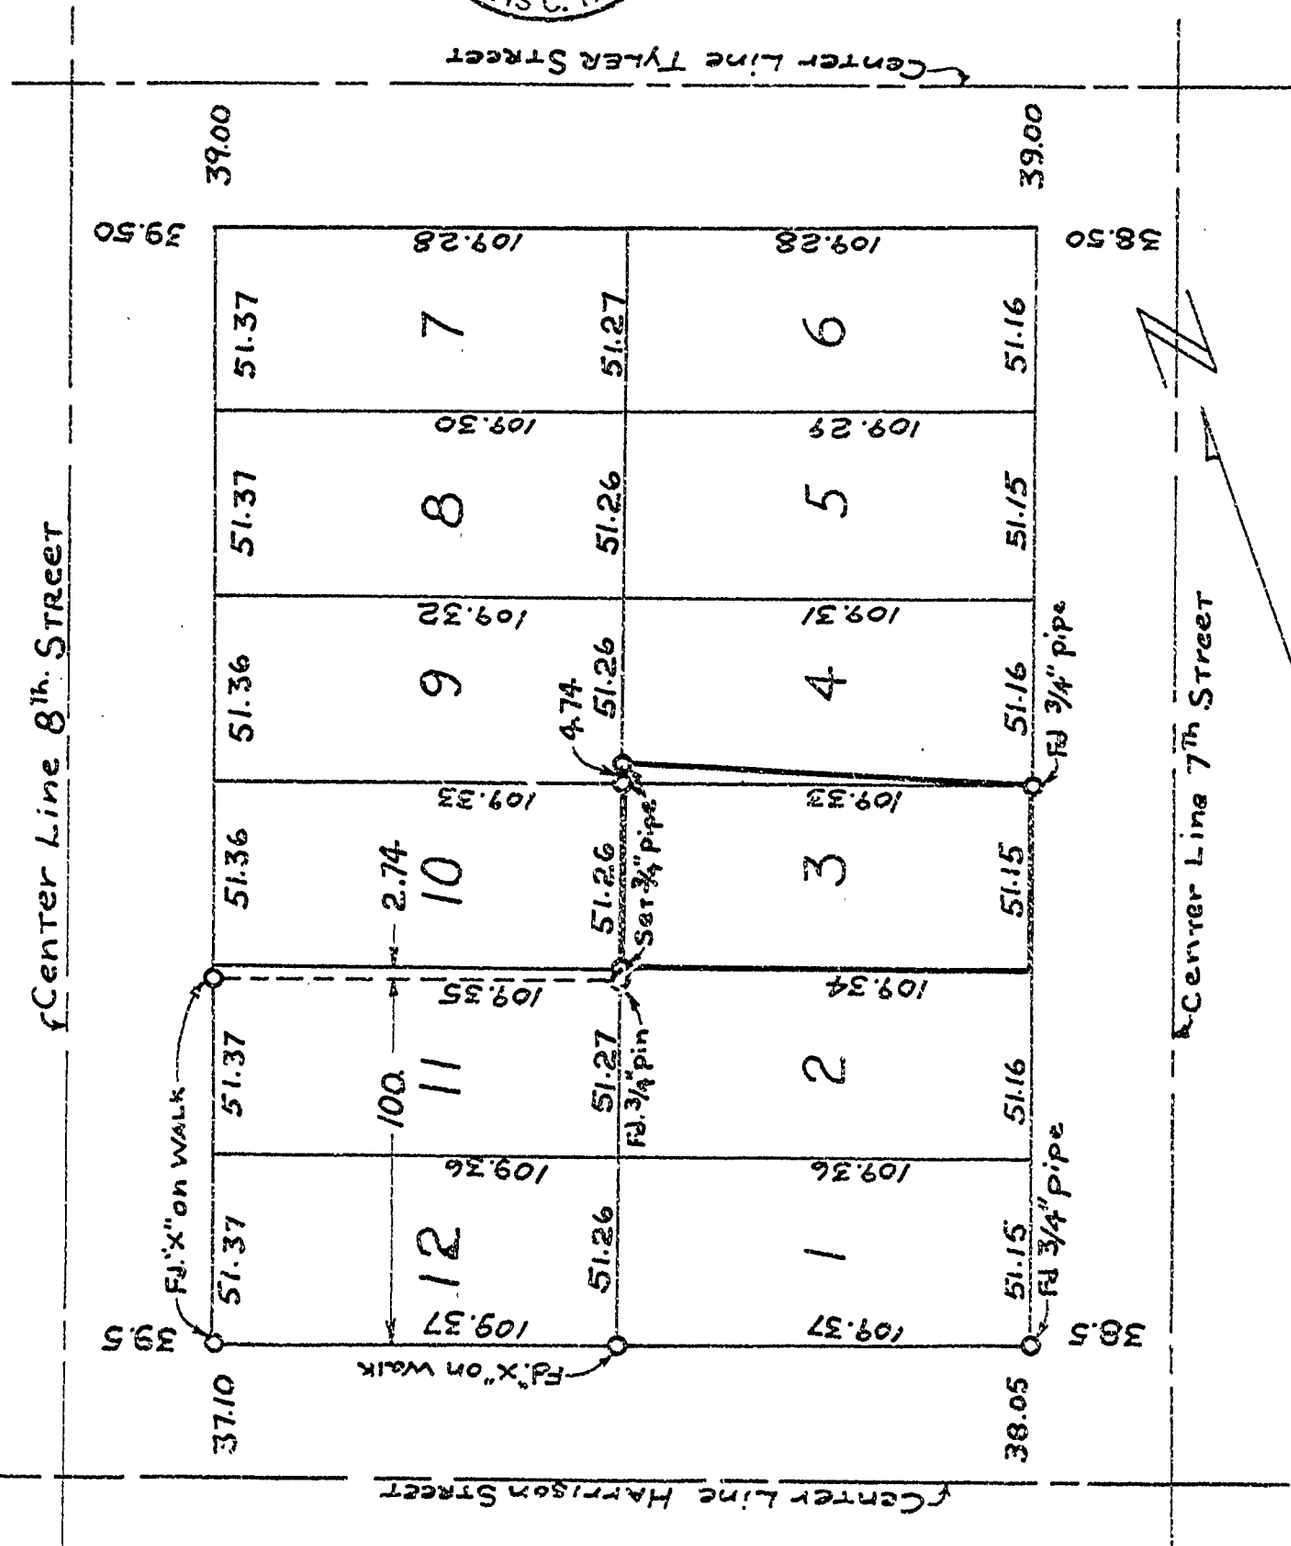
REGISTERED PROFESSIONAL ENGINEER 3627 Curtis C. Hanson OREGON May 7th 1954 CURTIS C. HANSON