2847

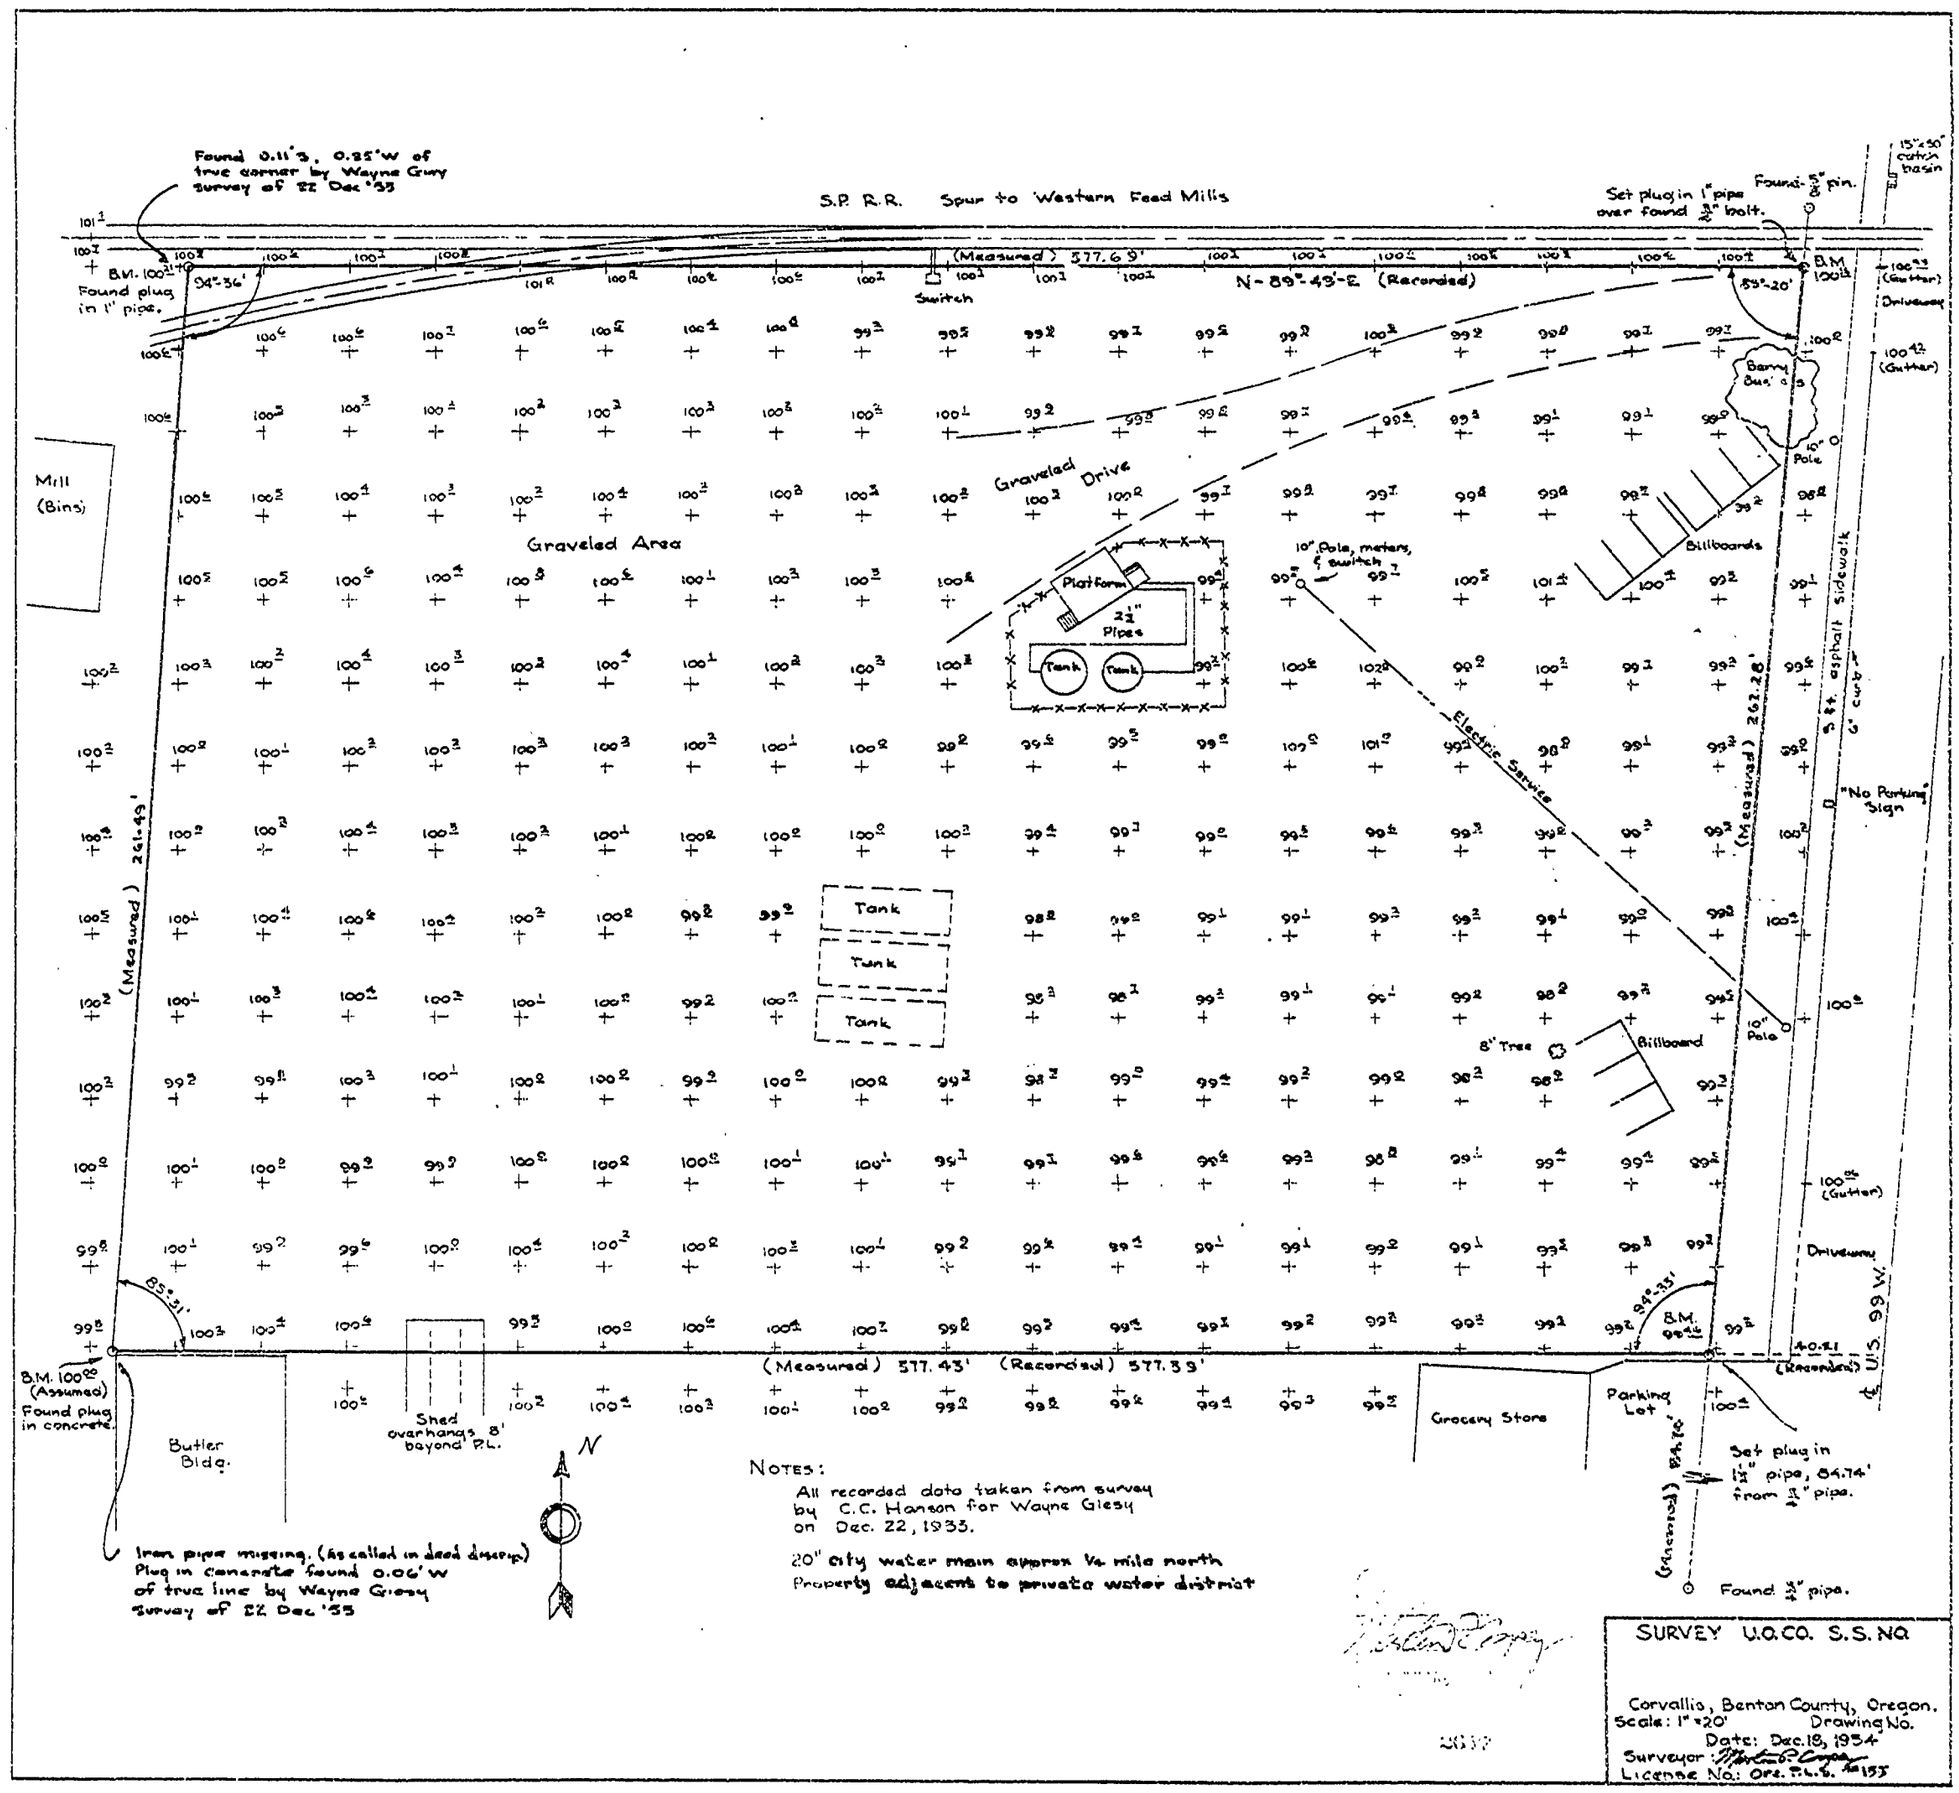

NOTES:

All recorded data taken from survey by C.C. Hanson for Wayne Giesy on Dec. 22, 1933.

20" city water main approx ½ mile north
Property adjacent to private water district

SURVEY U.O.CO. S.S. NO

Corvallis, Benton County, Oregon.
Scale: 1"=20' Drawing No.
Date: Dec. 18, 1934
Surveyor: [signature]
License No: Ore. R.L.S. No 153