2726

J. L. KIPPER

ROSEPARK ADDITION, BLOCK 1 PHILOMATH, OREGON

Scale: 1 in. = 50 ft.
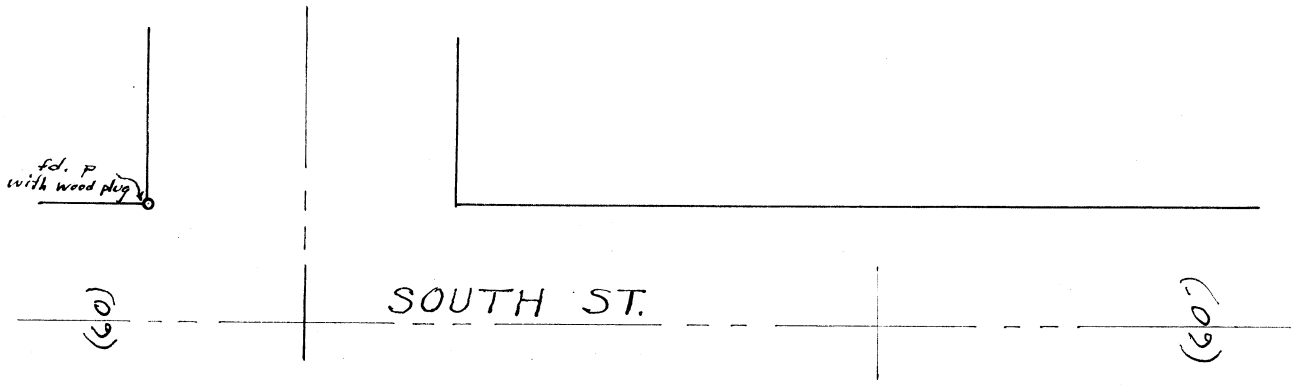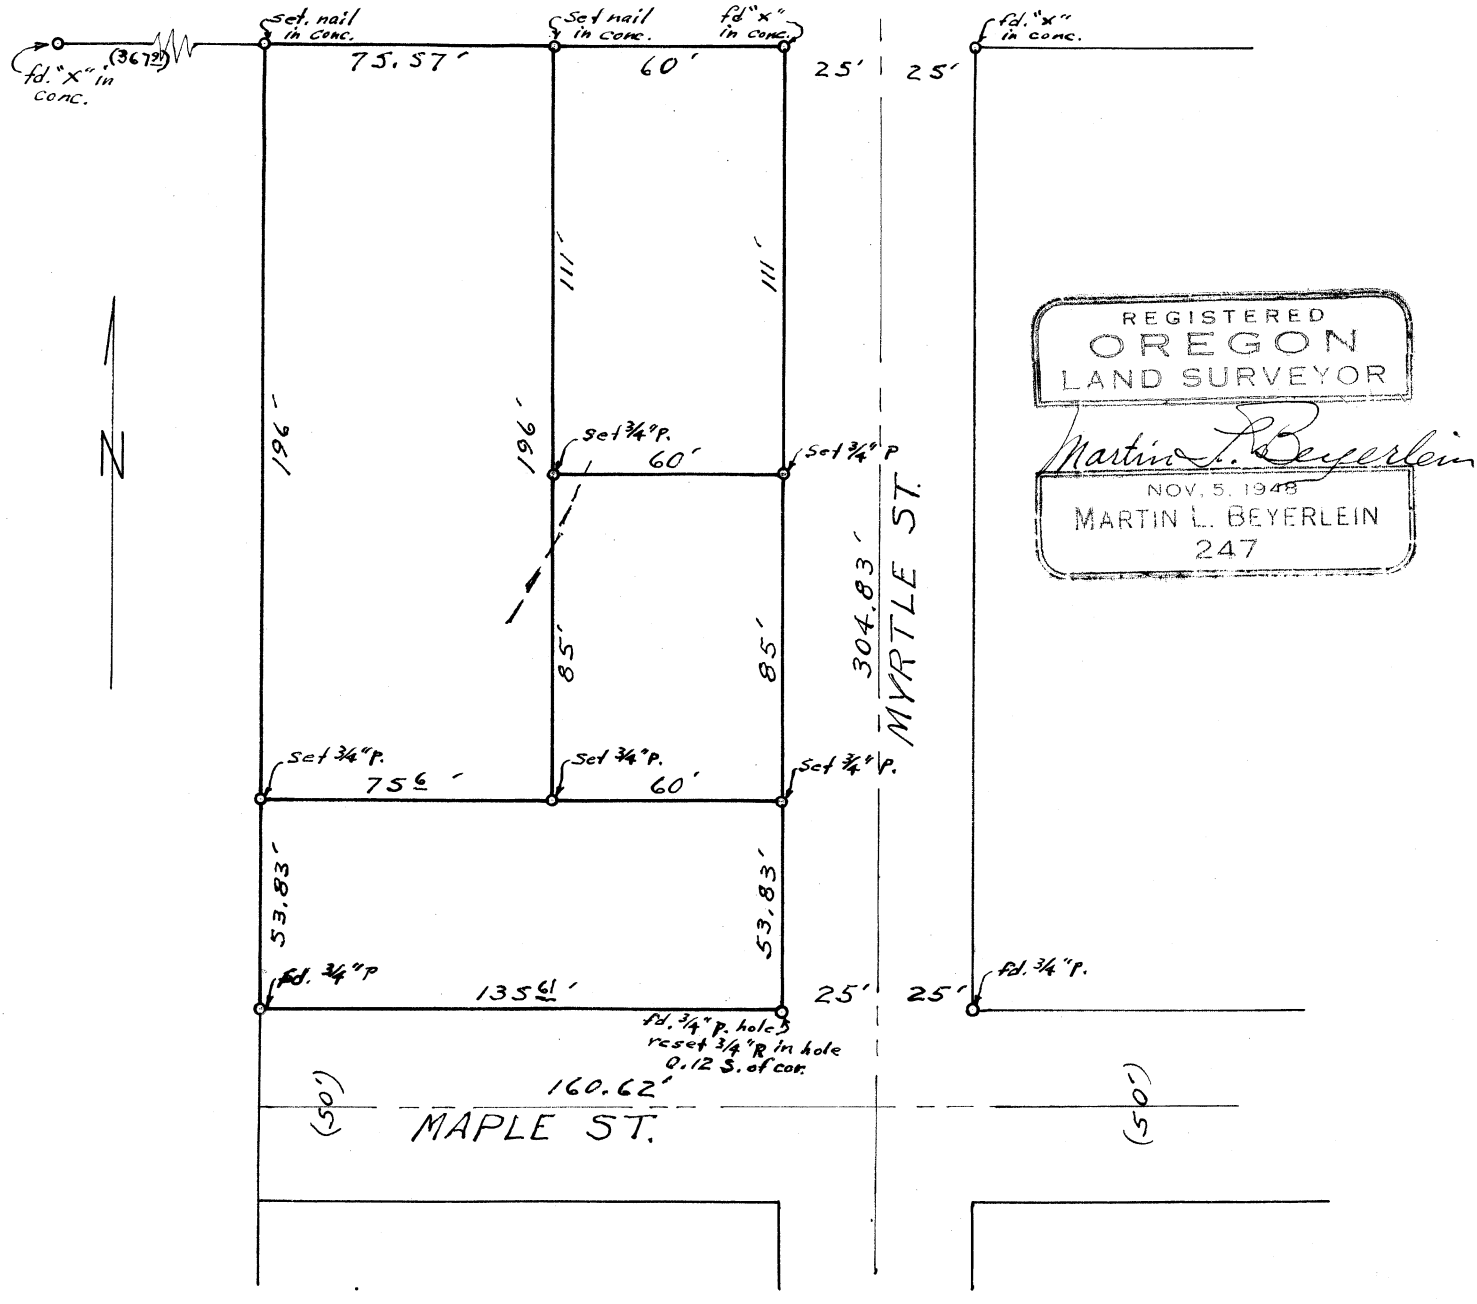
Dec. 2, 1955