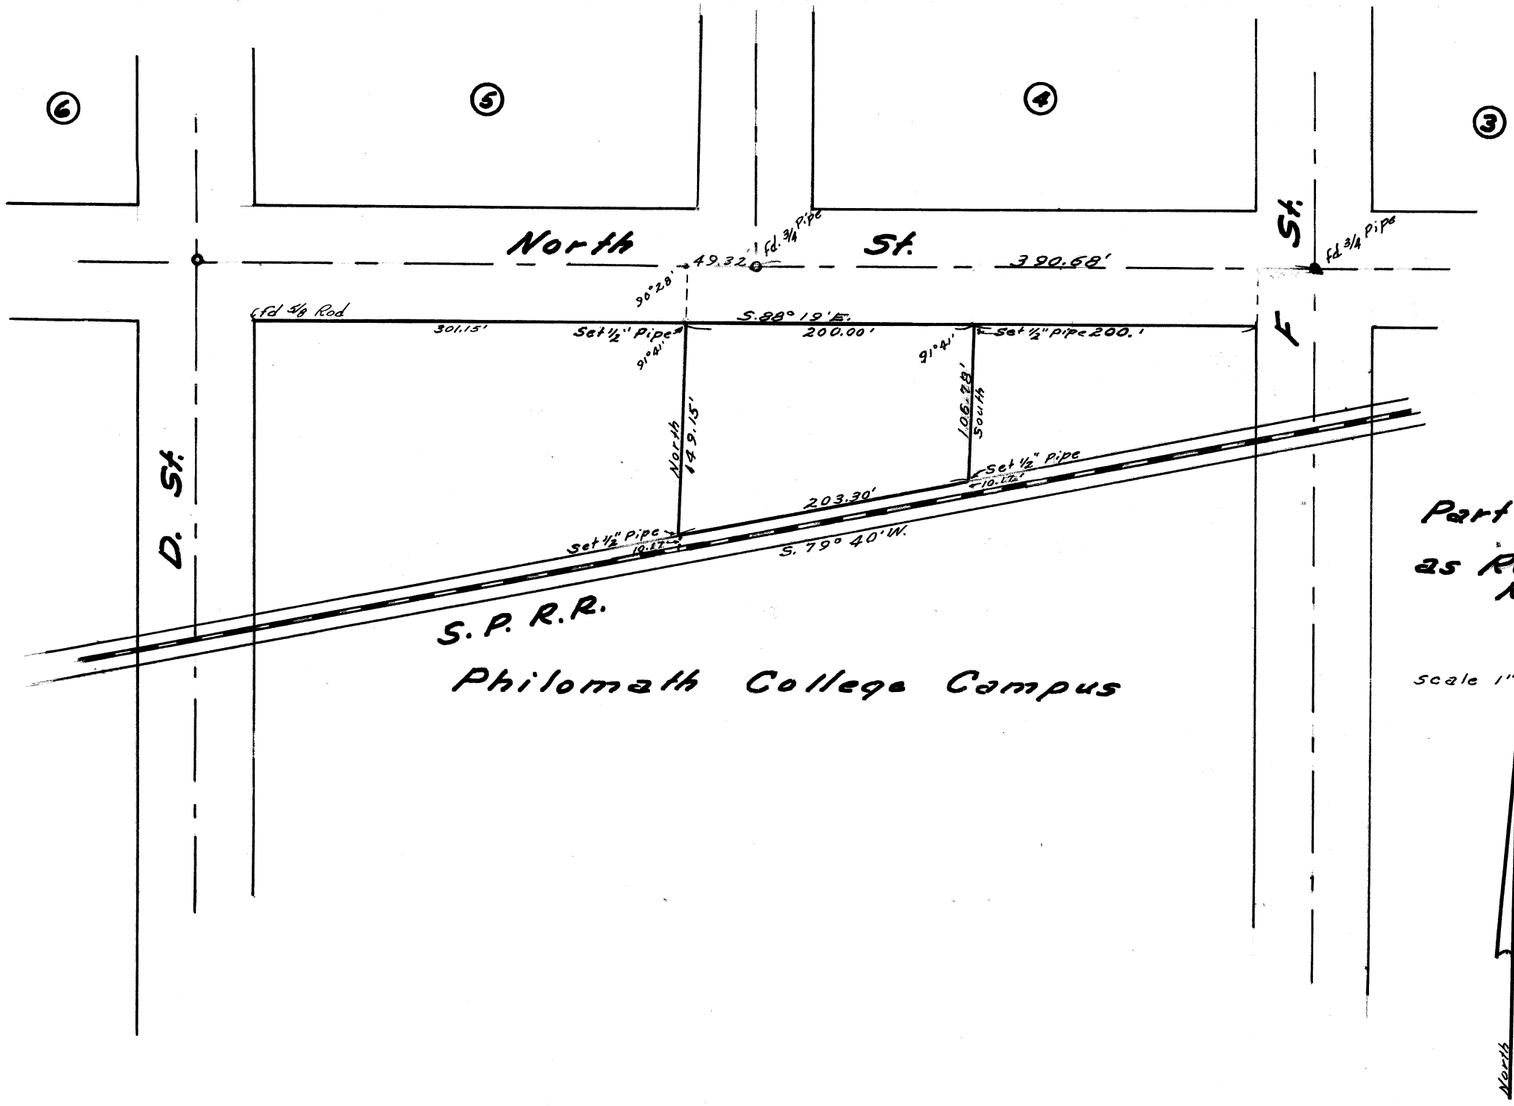

C.S. 2856

F. G. Scherer

Part of the Philomath College Campus as Recorded Book 1, Page 12 Records of Benton County Oregon

Scale 1" = 100

Nov. 14 – 1956

North

REGISTERED
OREGON
LAND SURVEYOR

J. W. Hanna

NOV. 6, 1953
J. W. HANNA
306