J.E. BORDEN

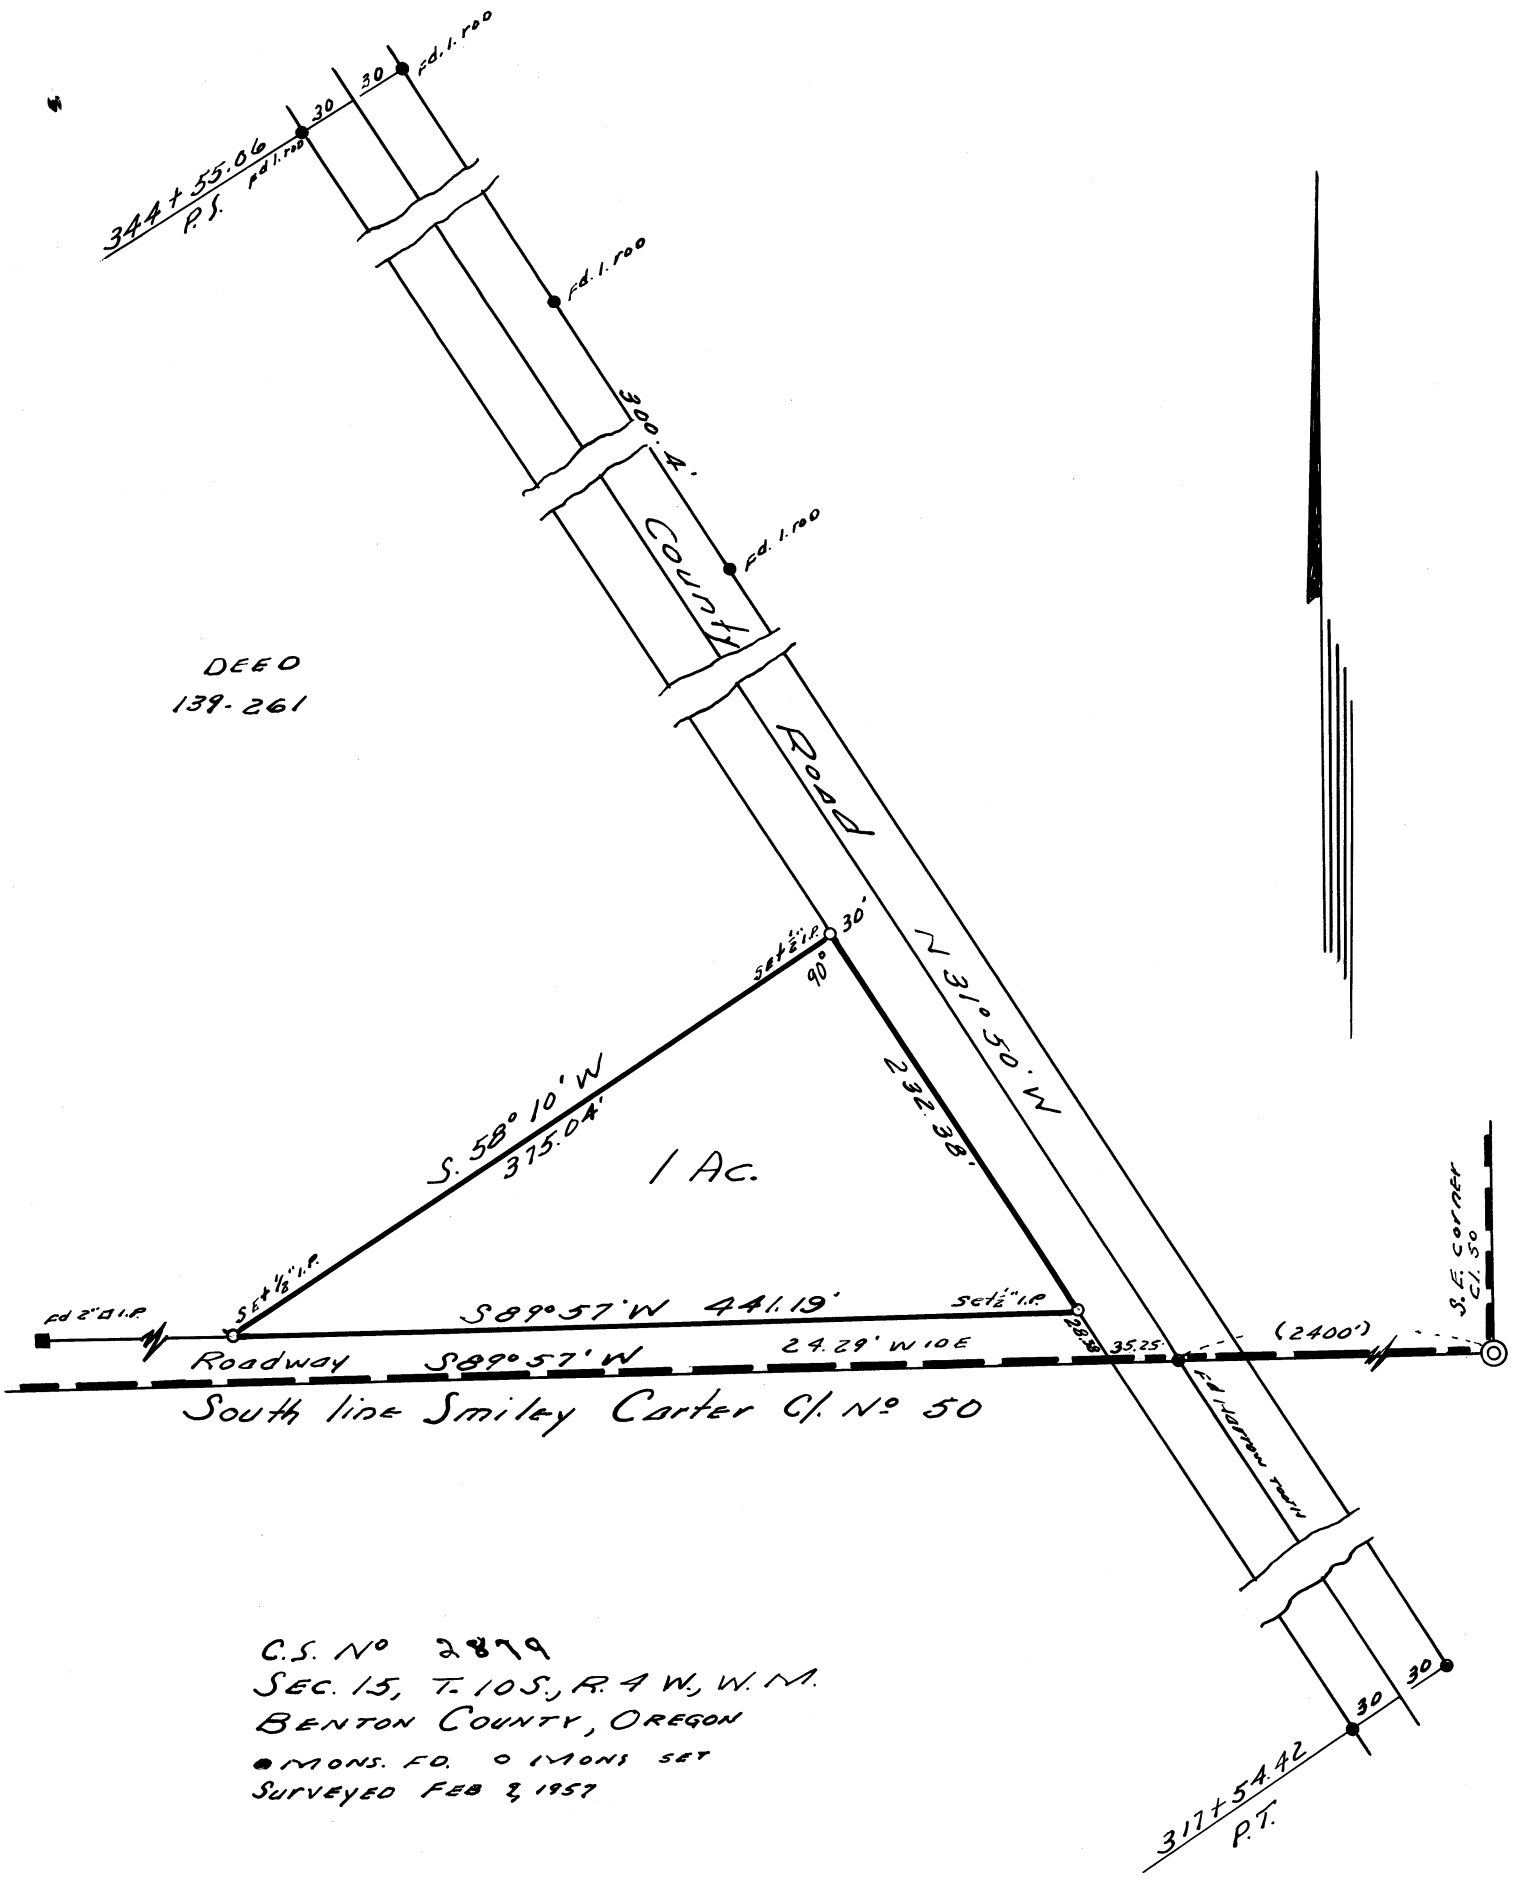

C.S. No 2879
SEC. 15, T. 10 S., R. 4 W., W. M.
BENTON COUNTY, OREGON
● MONS. FD. ○ MONS. SET
SURVEYED FEB 2, 1957

REGISTERED
OREGON
LAND SURVEYOR

Richard W. Fail

NOV. 4, 1955
RICHARD W. FAIL
357