C D N. 2467

...an Long

...

...

the northeast corner of said Block 3, which is the northeast corner of the tract described in deed recorded in Book 154, Page 341, thence South along the west line of said tract to the southline of said block, thence West 94.22 feet along the south line of said block to the southeast corner of the tract described in deed recorded in Book 154, Page 1, said deed records, thence North along the eastline of the last mentioned tract to the northline of said block, thence easterly 94.97 feet along the north line of said block to the point of beginning.

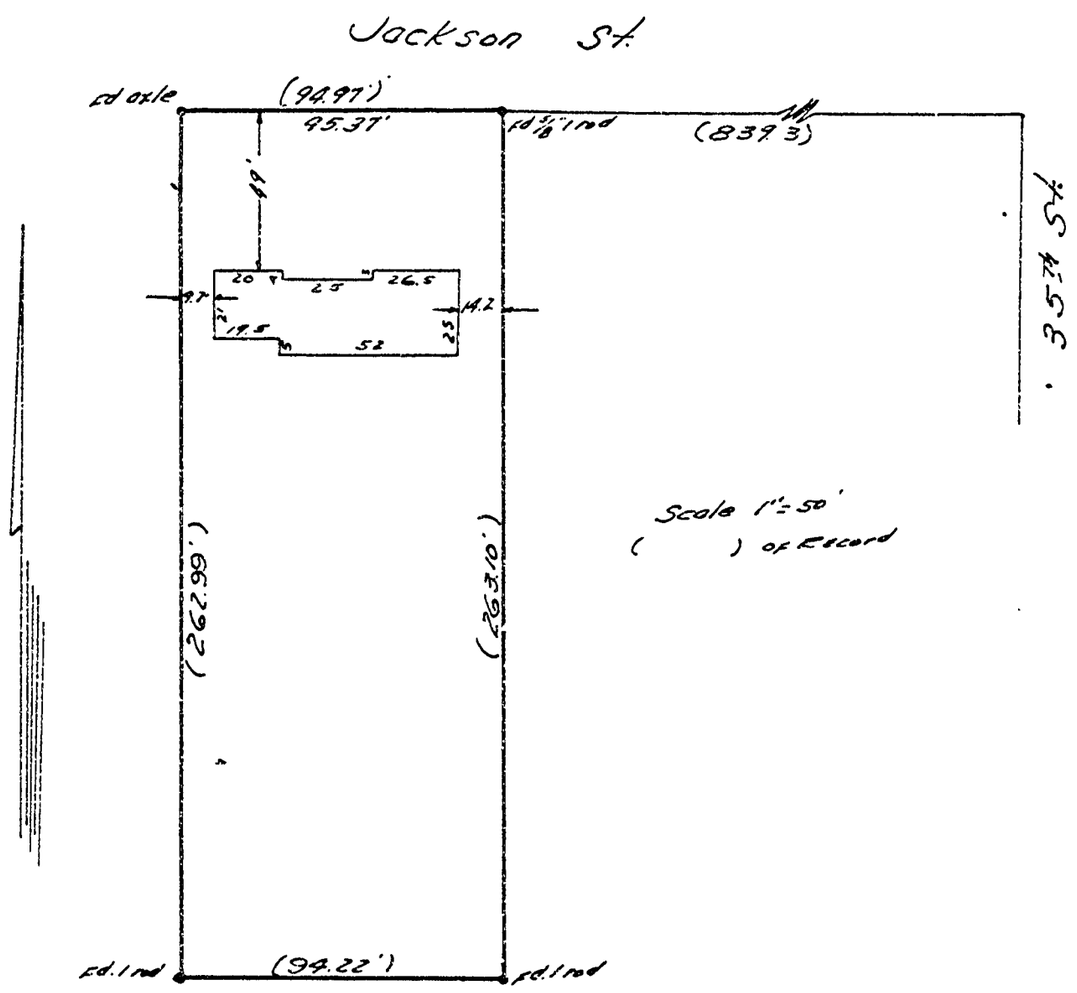

...

follows:

...

There is no ...

Richard A. Sail

REEL 10 FRAME 108