C. S. No. 3007

VIRGIL DUDLEY

DLC #38, T11S, R5W

SCALE 1"=400' NOVEMBER 1957
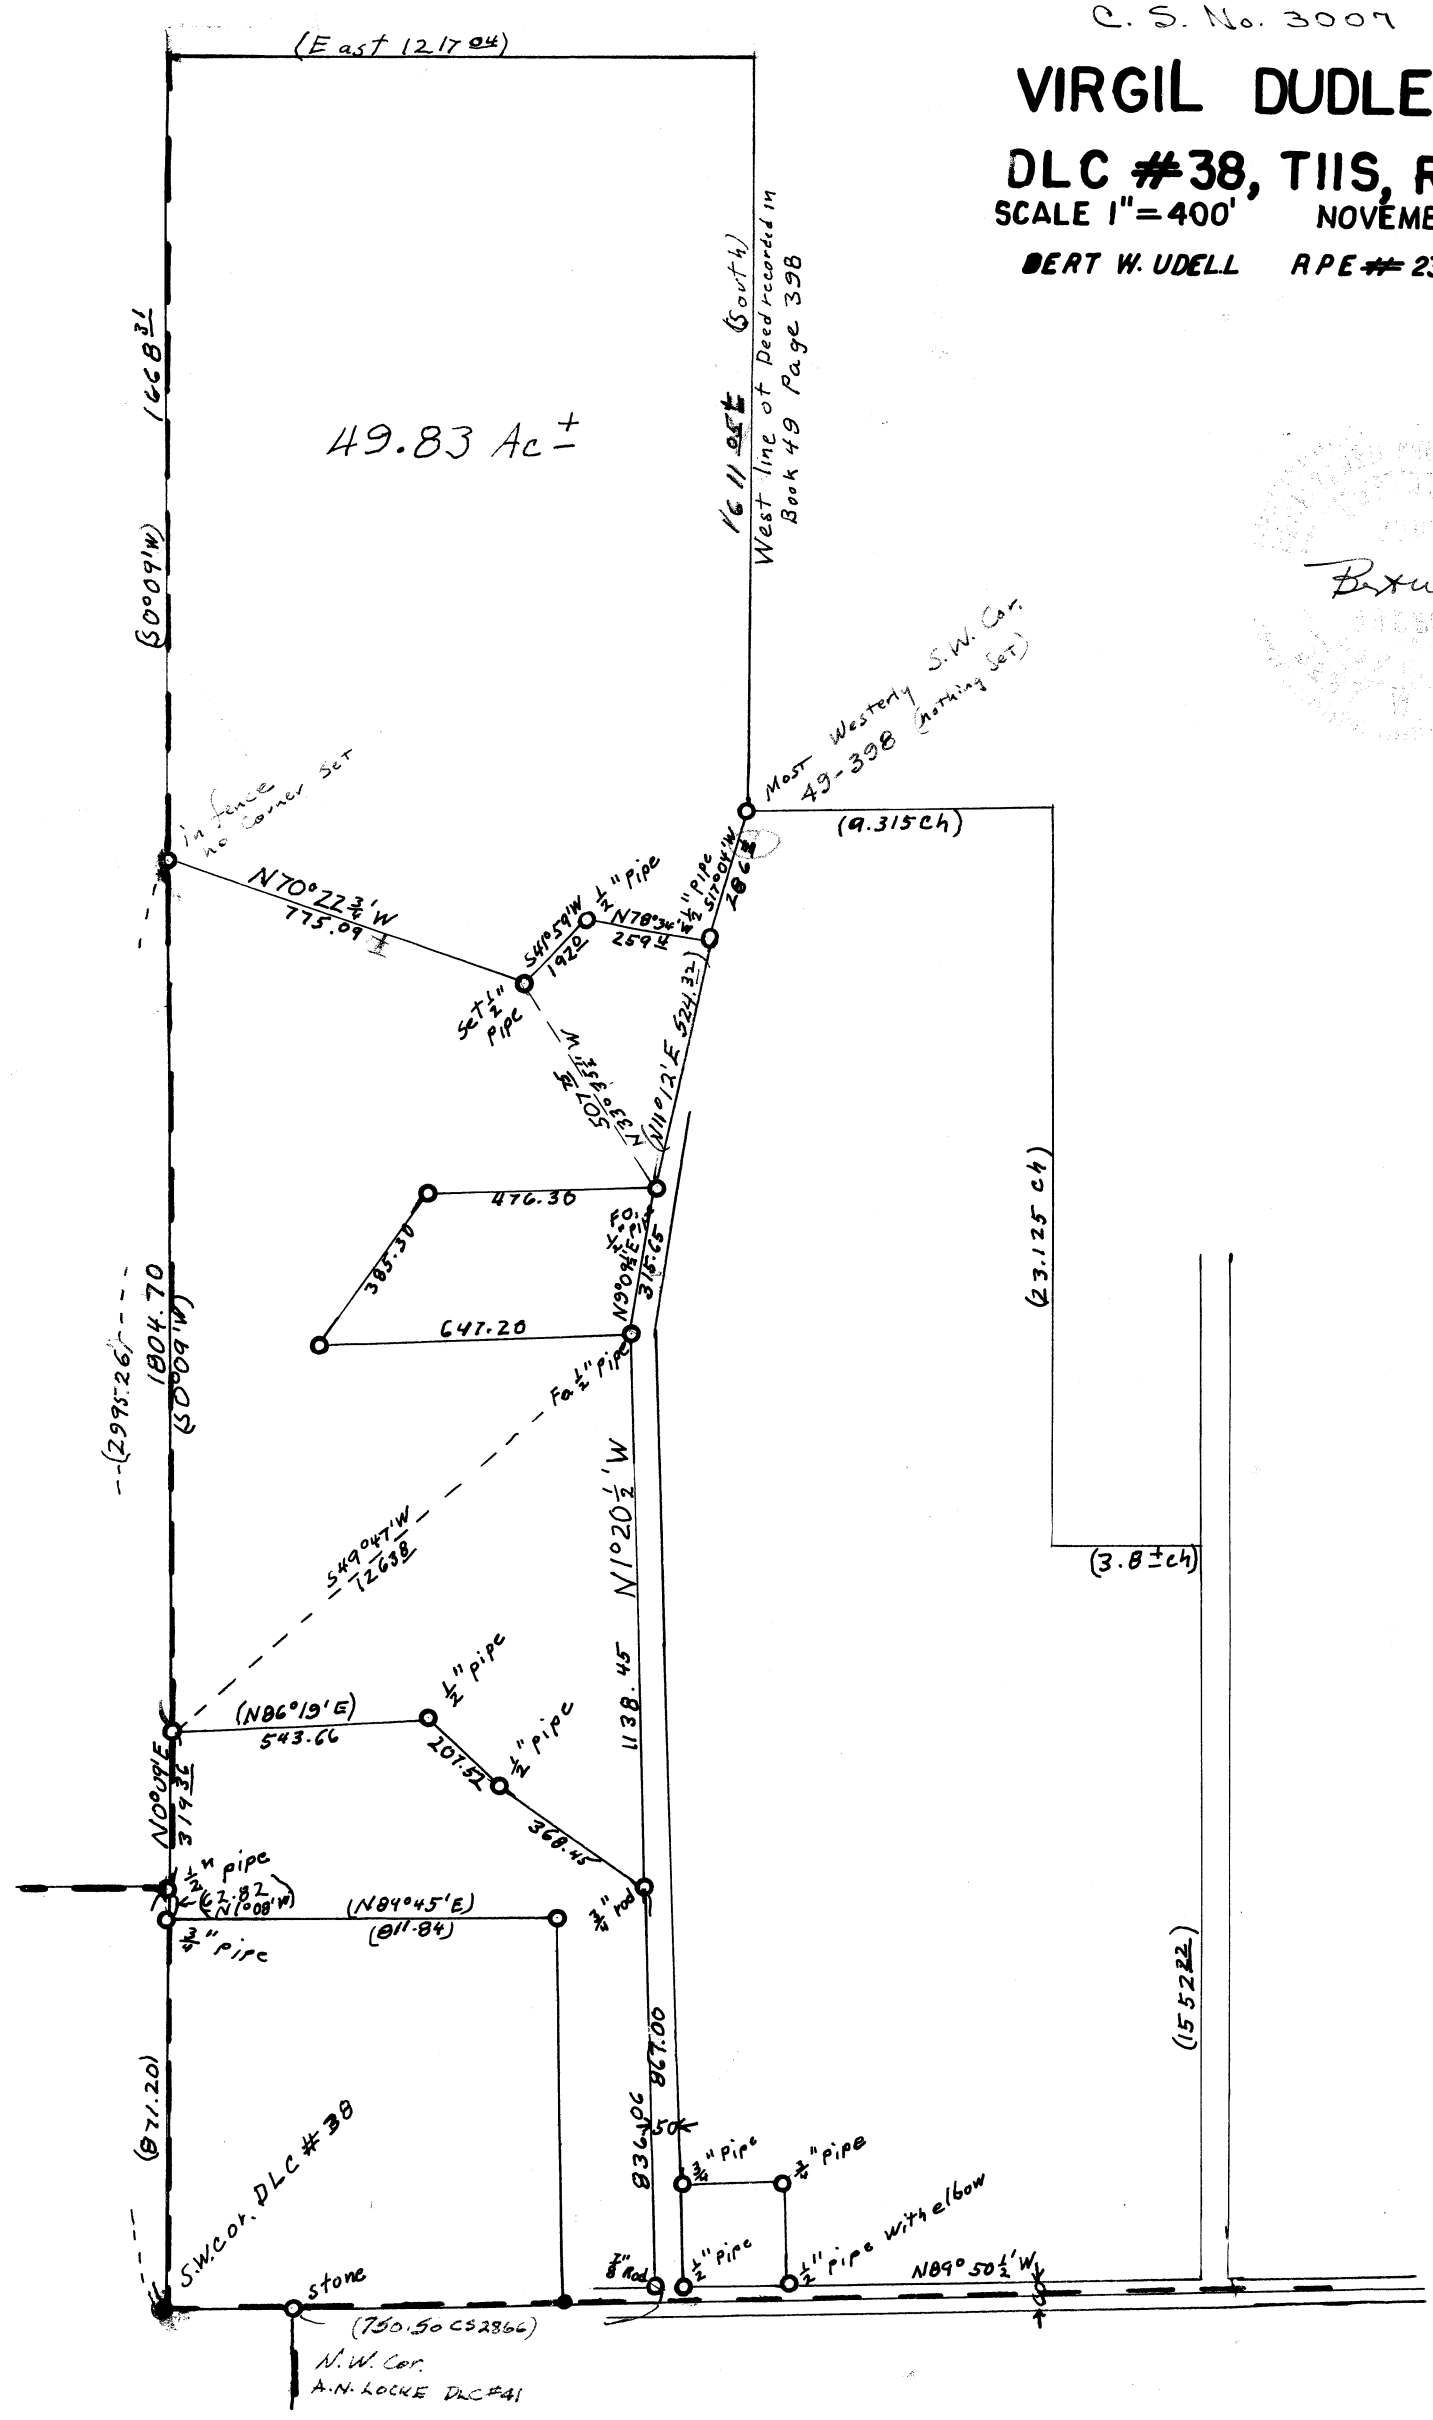
ROBERT W. UDELL RPE # 2301