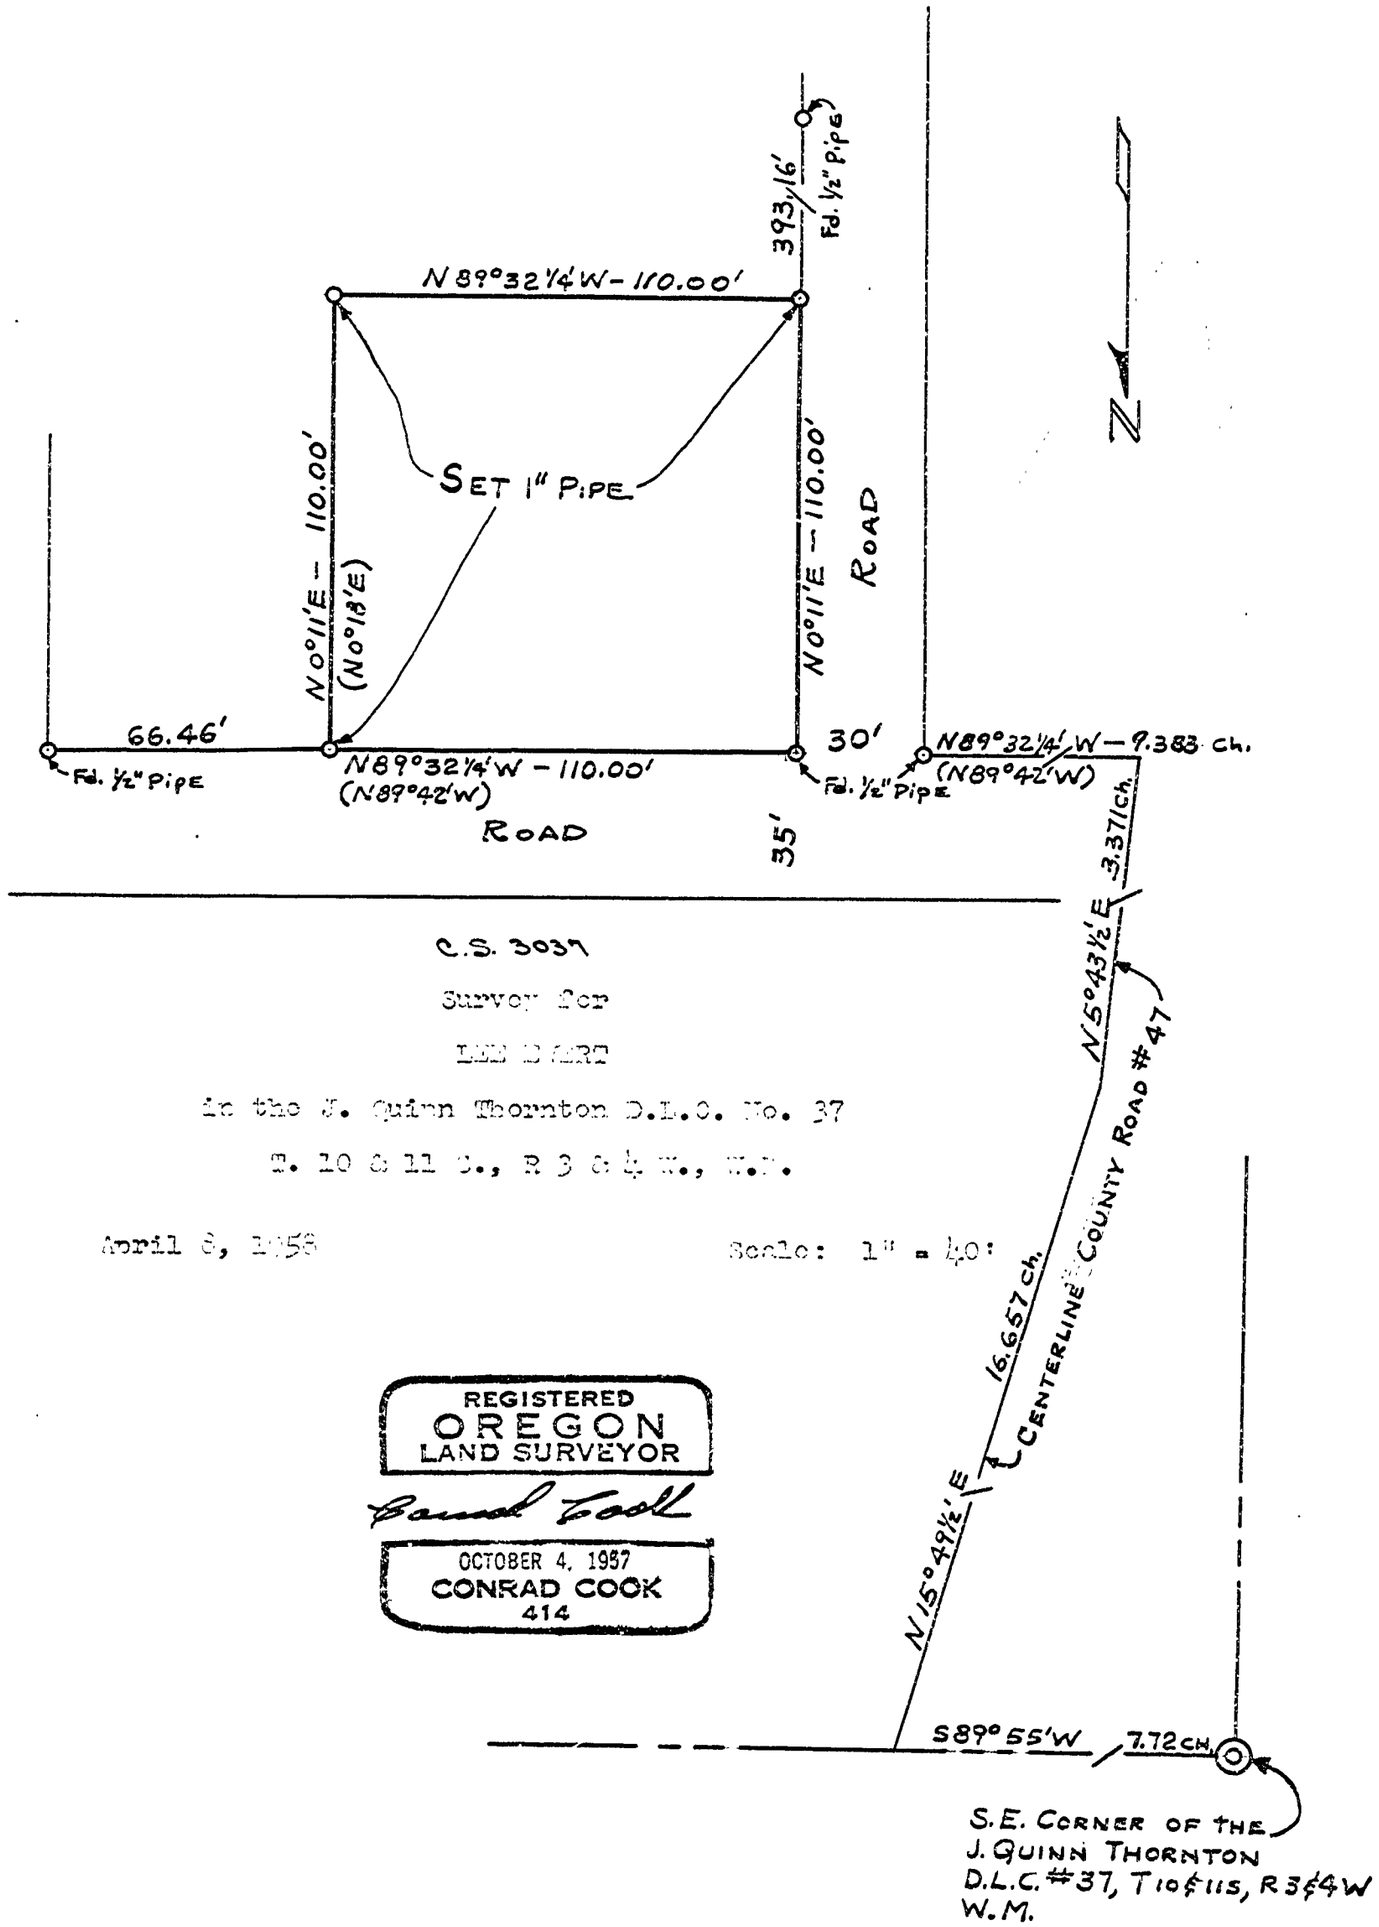

C.S. 3037

Survey for

LEE BART

in the J. Quinn Thornton D.L.C. No. 37

T. 10 & 11 S., R 3 & 4 W., W.M.

April 8, 1958

Scale: 1" = 40'

REGISTERED
OREGON
LAND SURVEYOR

Conrad Cook

OCTOBER 4, 1957
CONRAD COOK
414