C. S No. 3096

SURVEY FOR ALVIN D. ROOT
IN THE DAVID D. STROUD D.L.C. NO. 44
T11S, R4W OF WILLAMETTE MERIDIAN
BENTON COUNTY, OREGON

SCALE 1"= 60' SEPT. 29, 1958

REGISTERED
OREGON
LAND SURVEYOR
Fred I. Lemke
MAY 2, 1958
FRED I. LEMKE
443

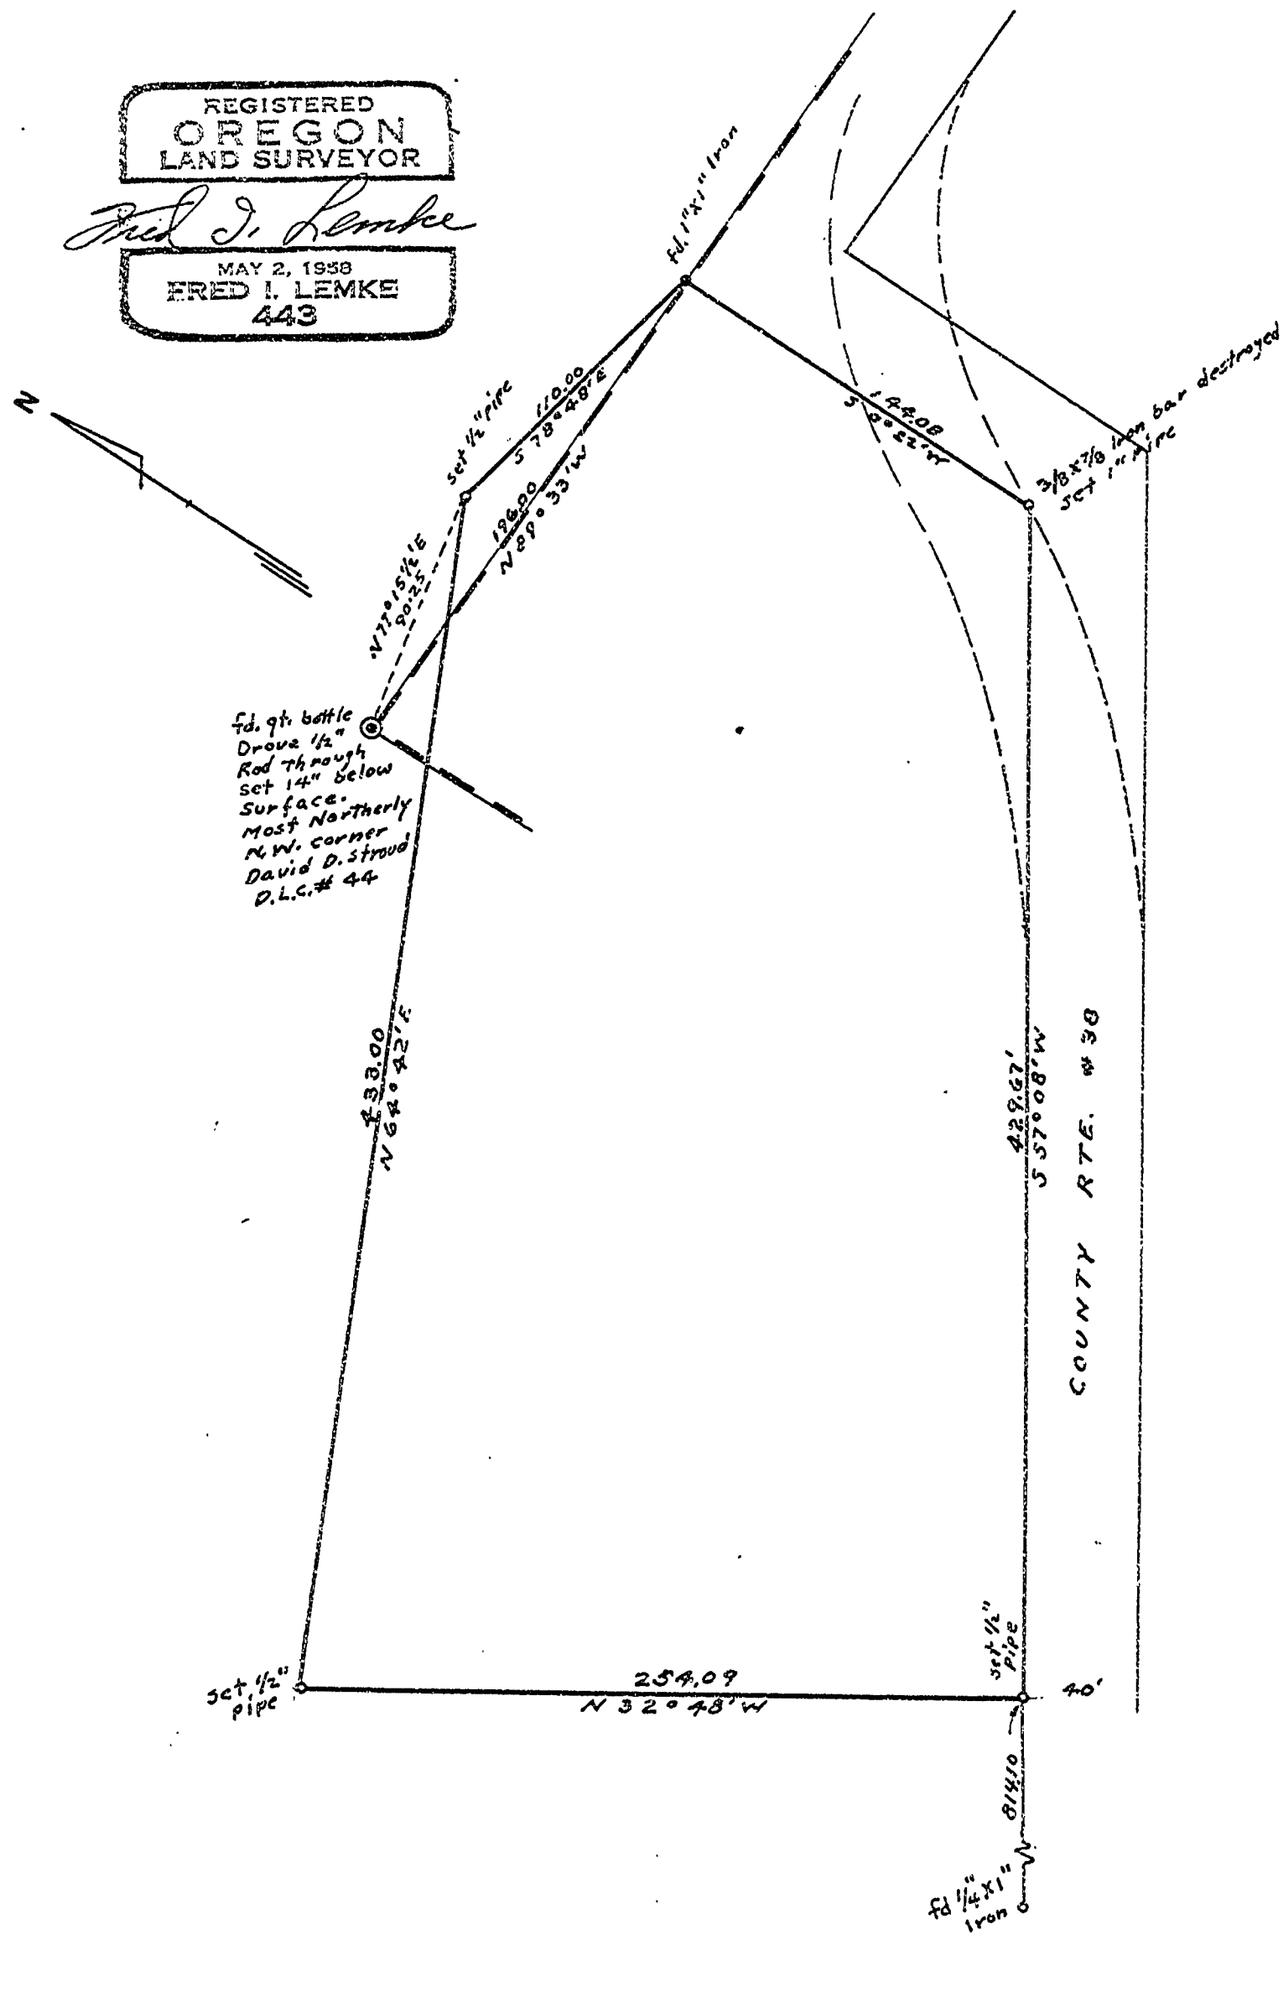

C.S No. 3096

8/2/58

Hot.'

T. F. Lemke

Ch. J. Hoard

Alvin D. Root Survey

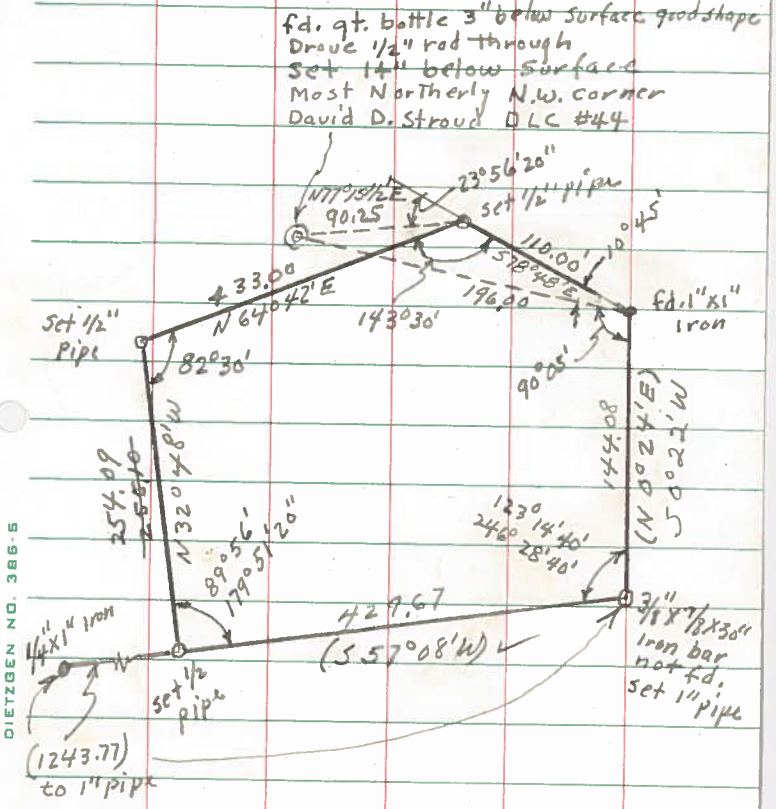

DIETZGEN NO. 386-S