C. S. NO. 3199

JUNE 1. ASP

HARVEY YOUNG D.L.C. NO. 56

T. 12 S., R. 5 W., WILL. MER.
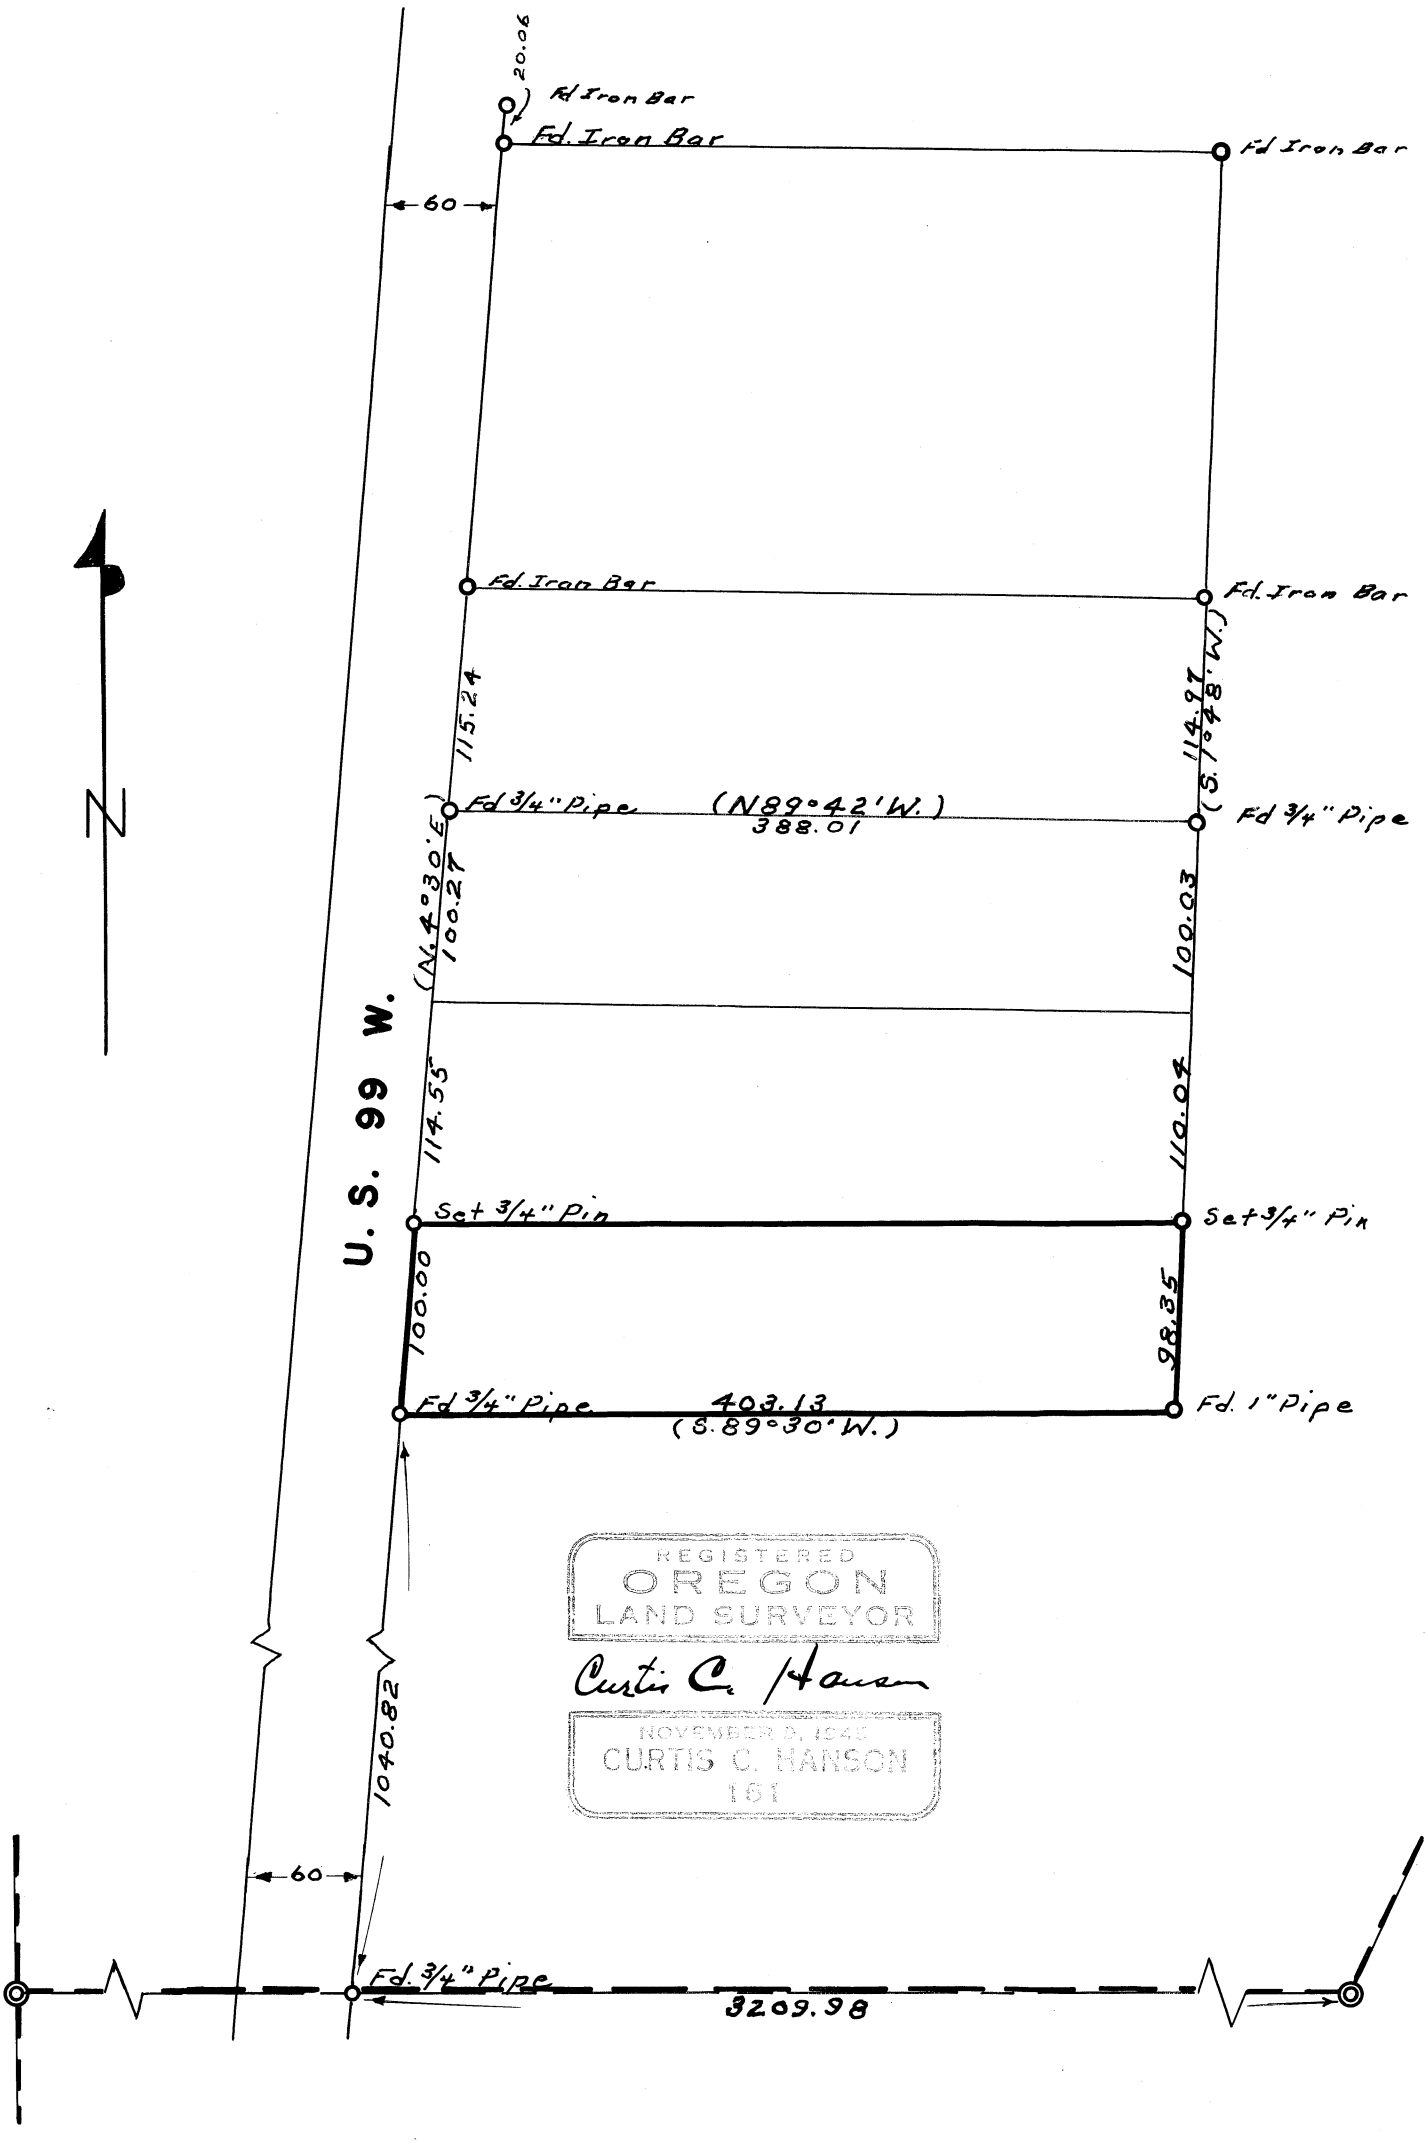
SCALE: 1" = 100' MARCH 6, 1959