CONRAD COOK
Registered Land Surveyor

Telephone
PLaza 2-1733

4450 West Hills Road
Corvallis, Oregon

Job No. 500 Survey for Palmateer-Zaworski Date Nov. 18, 1958

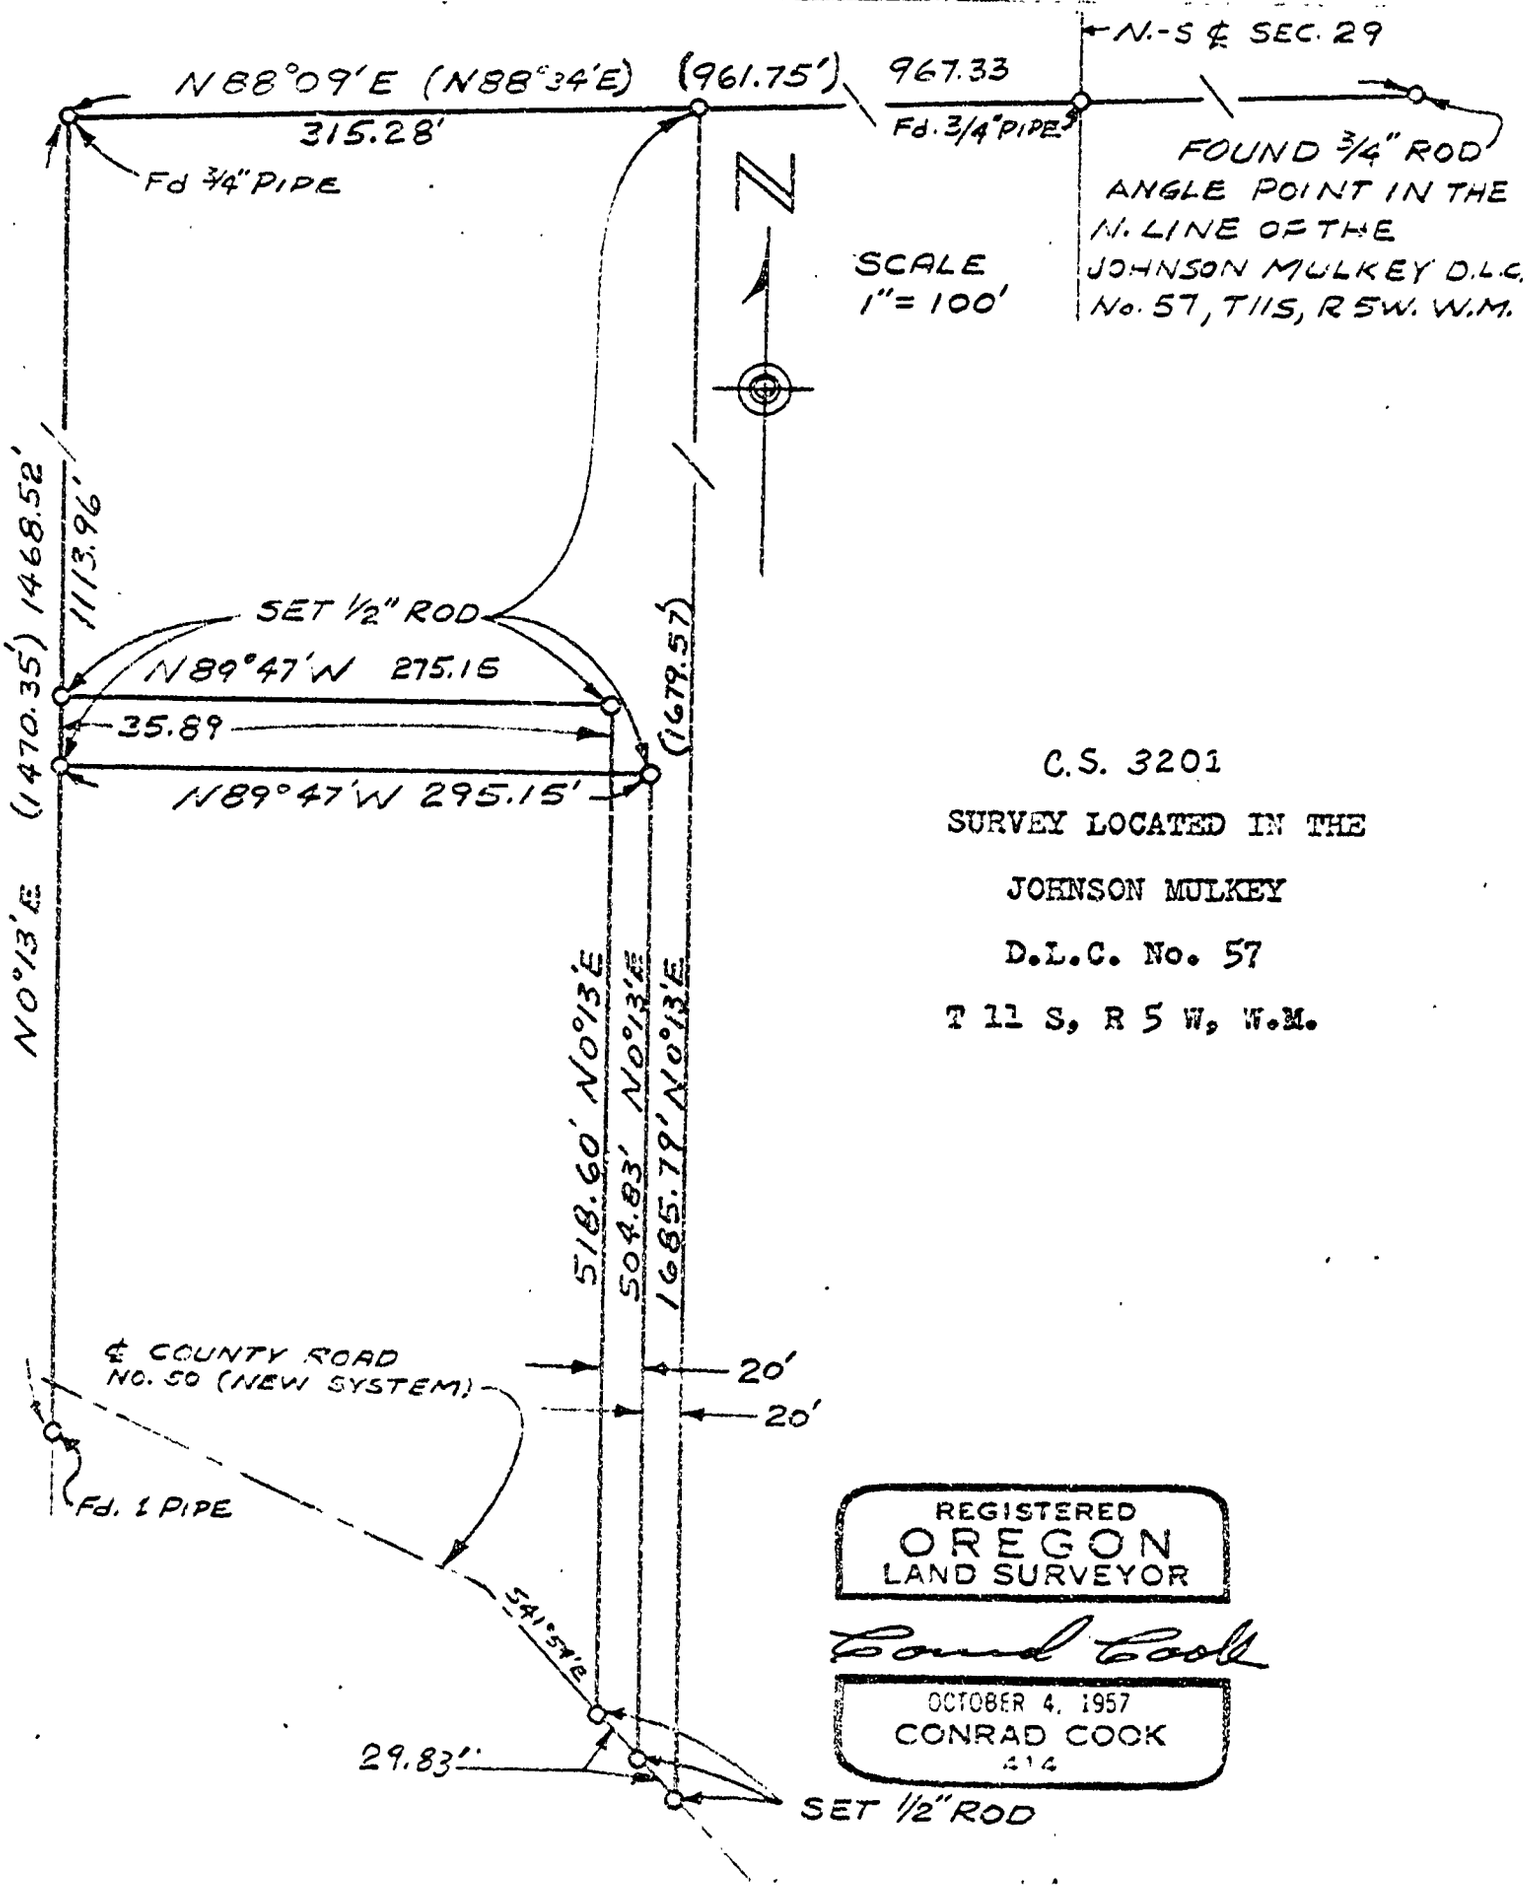

C.S. 3201

SURVEY LOCATED IN THE

JOHNSON MULKEY

D.L.C. No. 57

T 11 S, R 5 W, W.M.

REGISTERED
OREGON
LAND SURVEYOR

Conrad Cook

OCTOBER 4, 1957
CONRAD COOK
414