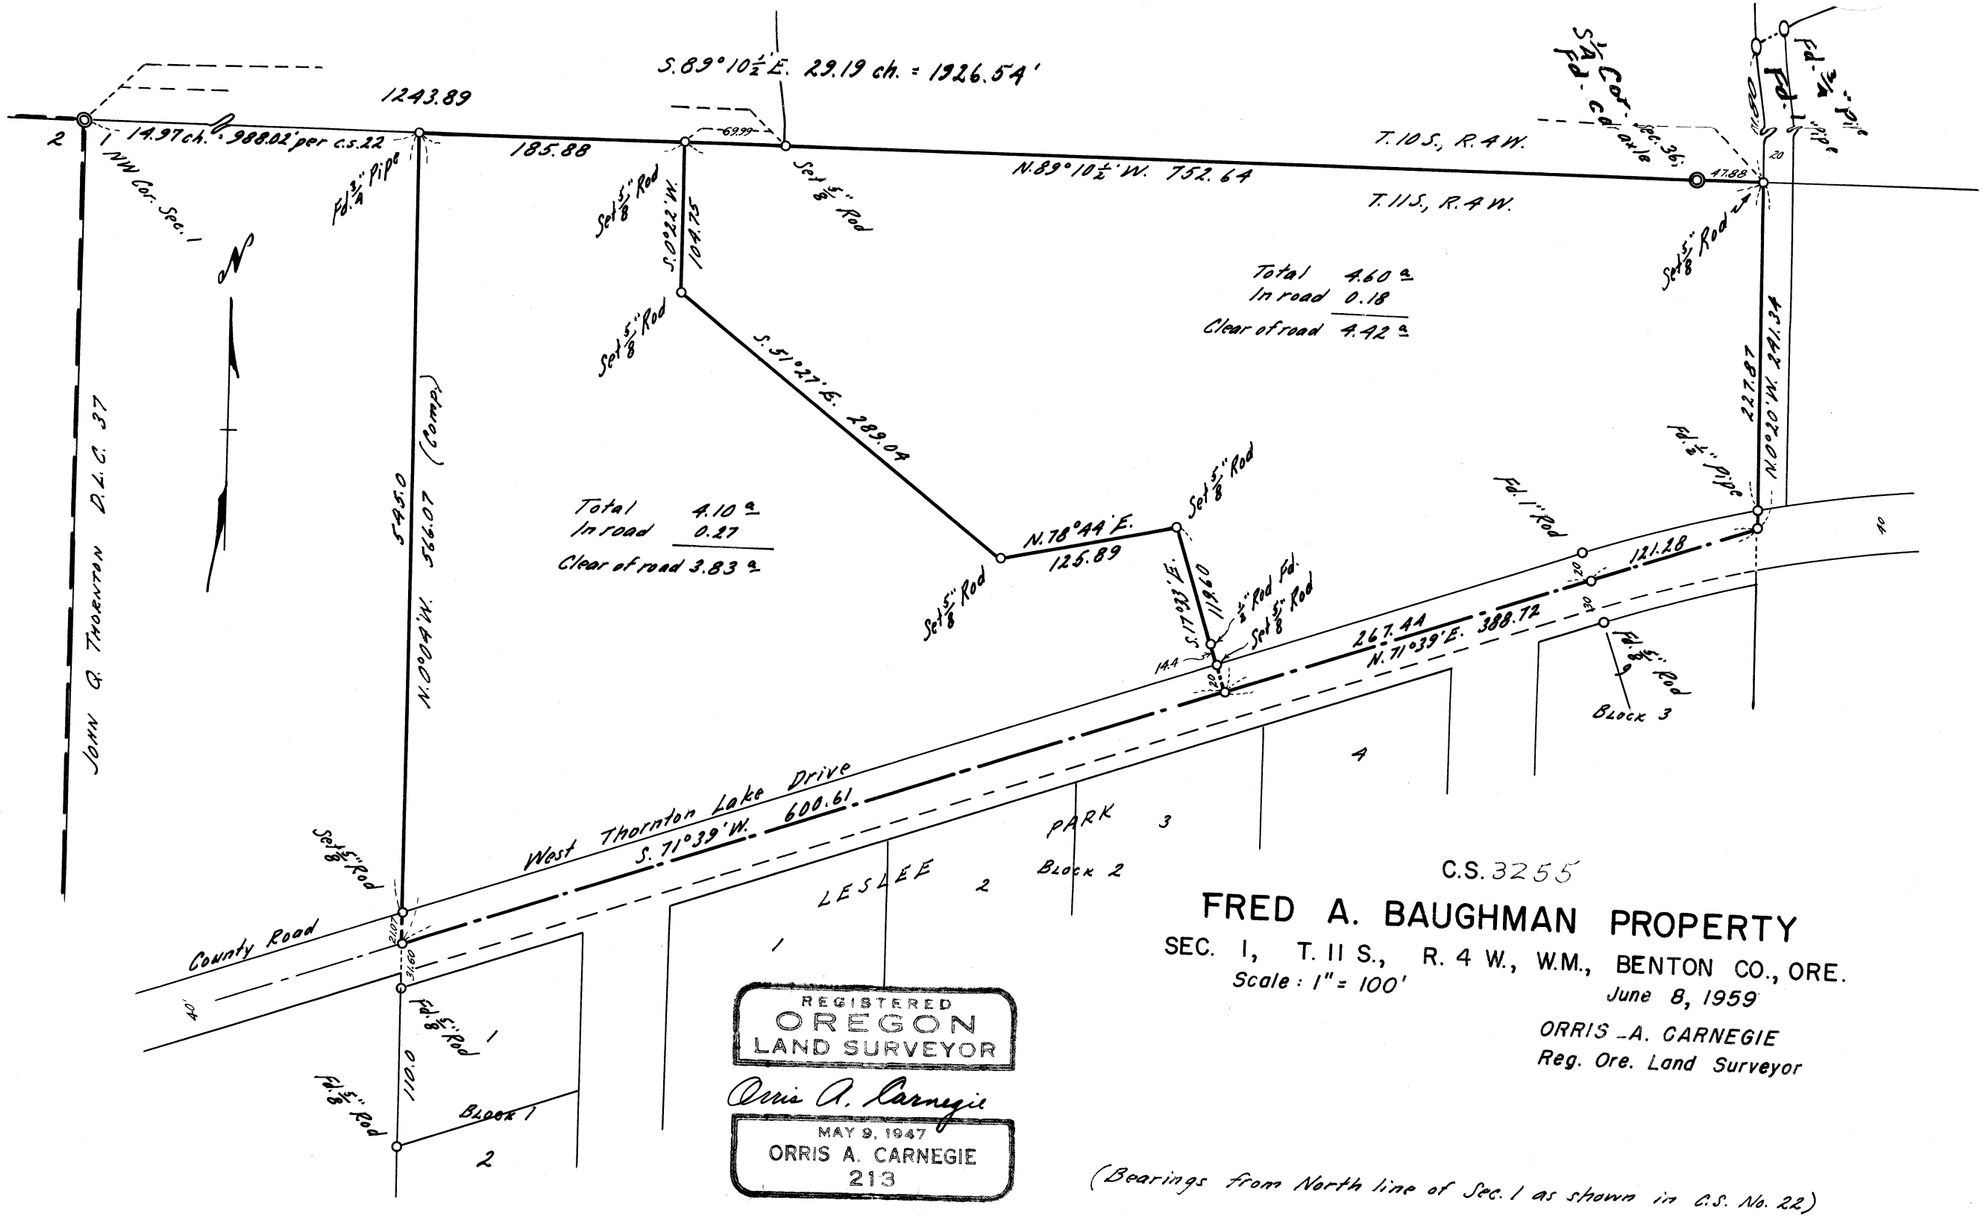
S.89°10½'E. 29.19 ch. = 1926.54'
1243.89
14.97 ch. = 988.02' per c.s.22
185.88
N.89°10½'W. 752.64
T.10S., R.4W.
T.11S., R.4W.
NW Cor. Sec. 1
Fd. 3" Pipe
Set 5/8" Rod
S.51°27'E. 289.09
N.78°44'E. 125.89
S.17°22'E. 111.60
Total 4.60 a.
In road 0.18
Clear of road 4.42 a.
Total 4.10 a.
In road 0.27
Clear of road 3.83 a.
S.A. Cor. Sec. 36
Fd. 3" Pipe
Fd. 1" Pipe
Fd. 1" Rod
121.28
267.44
N.71°39'E. 388.72
Fd. 5/8" Rod
Block 3
John R. Thornton D.L.C. 37
West Thornton Lake Drive
S.71°39'W. 600.61'
County Road
PARK
LESLEE
Block 2
Block 1
1
2
3
4
C.S. 3255
FRED A. BAUGHMAN PROPERTY
SEC. 1, T. 11 S., R. 4 W., W.M., BENTON CO., ORE.
Scale: 1" = 100'
June 8, 1959
ORRIS A. CARNEGIE
Reg. Ore. Land Surveyor
REGISTERED
OREGON
LAND SURVEYOR
Orris A. Carnegie
MAY 9, 1947
ORRIS A. CARNEGIE
213
(Bearings from North line of Sec. 1 as shown in C.S. No. 22)

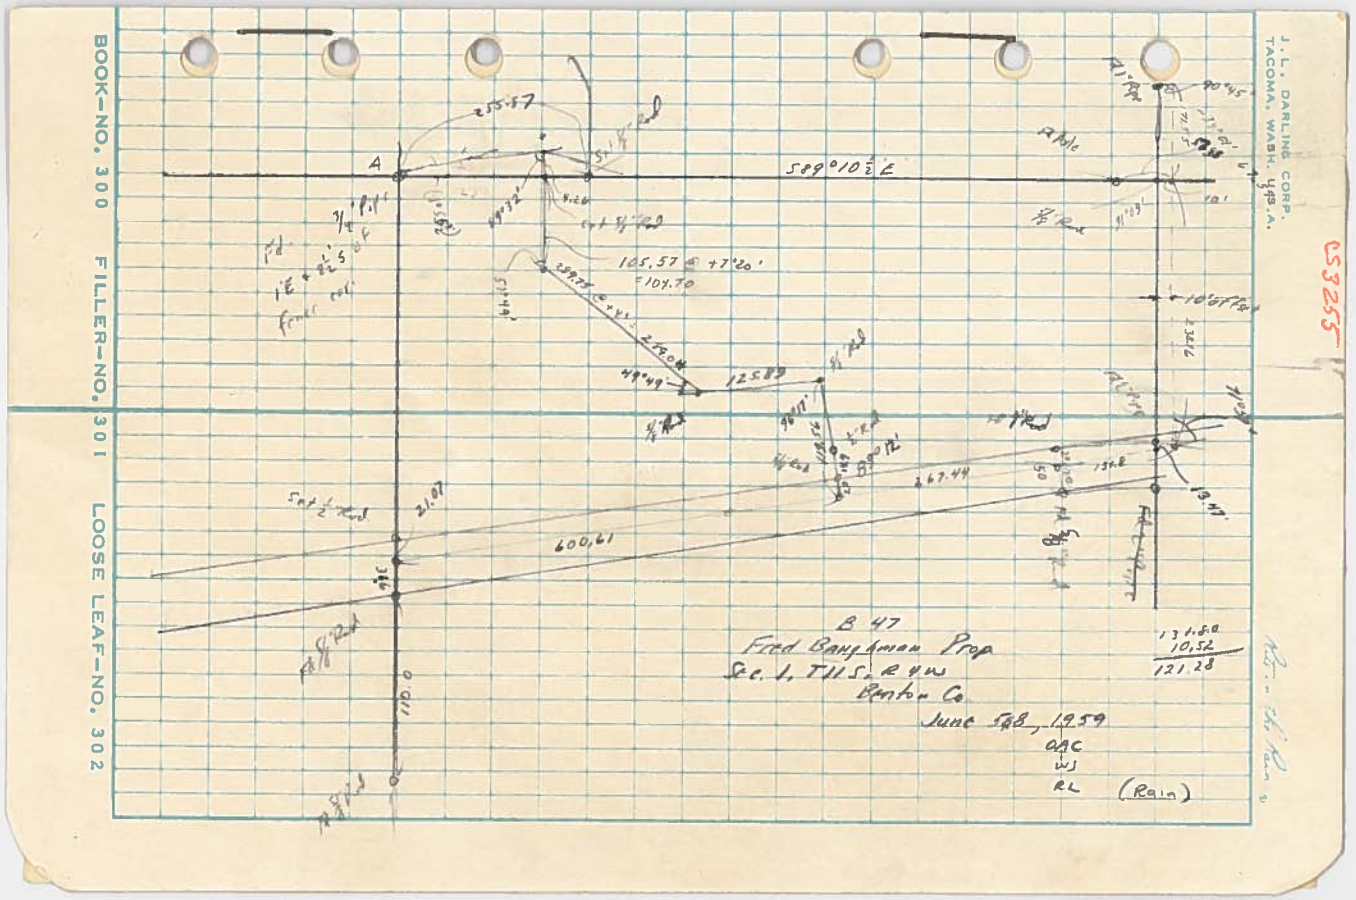

BOOK—NO. 300 FILLER—NO. 301 LOOSE LEAF—NO. 302

J. L. DARLING CORP.
TACOMA, WASH. U.S.A.

53255