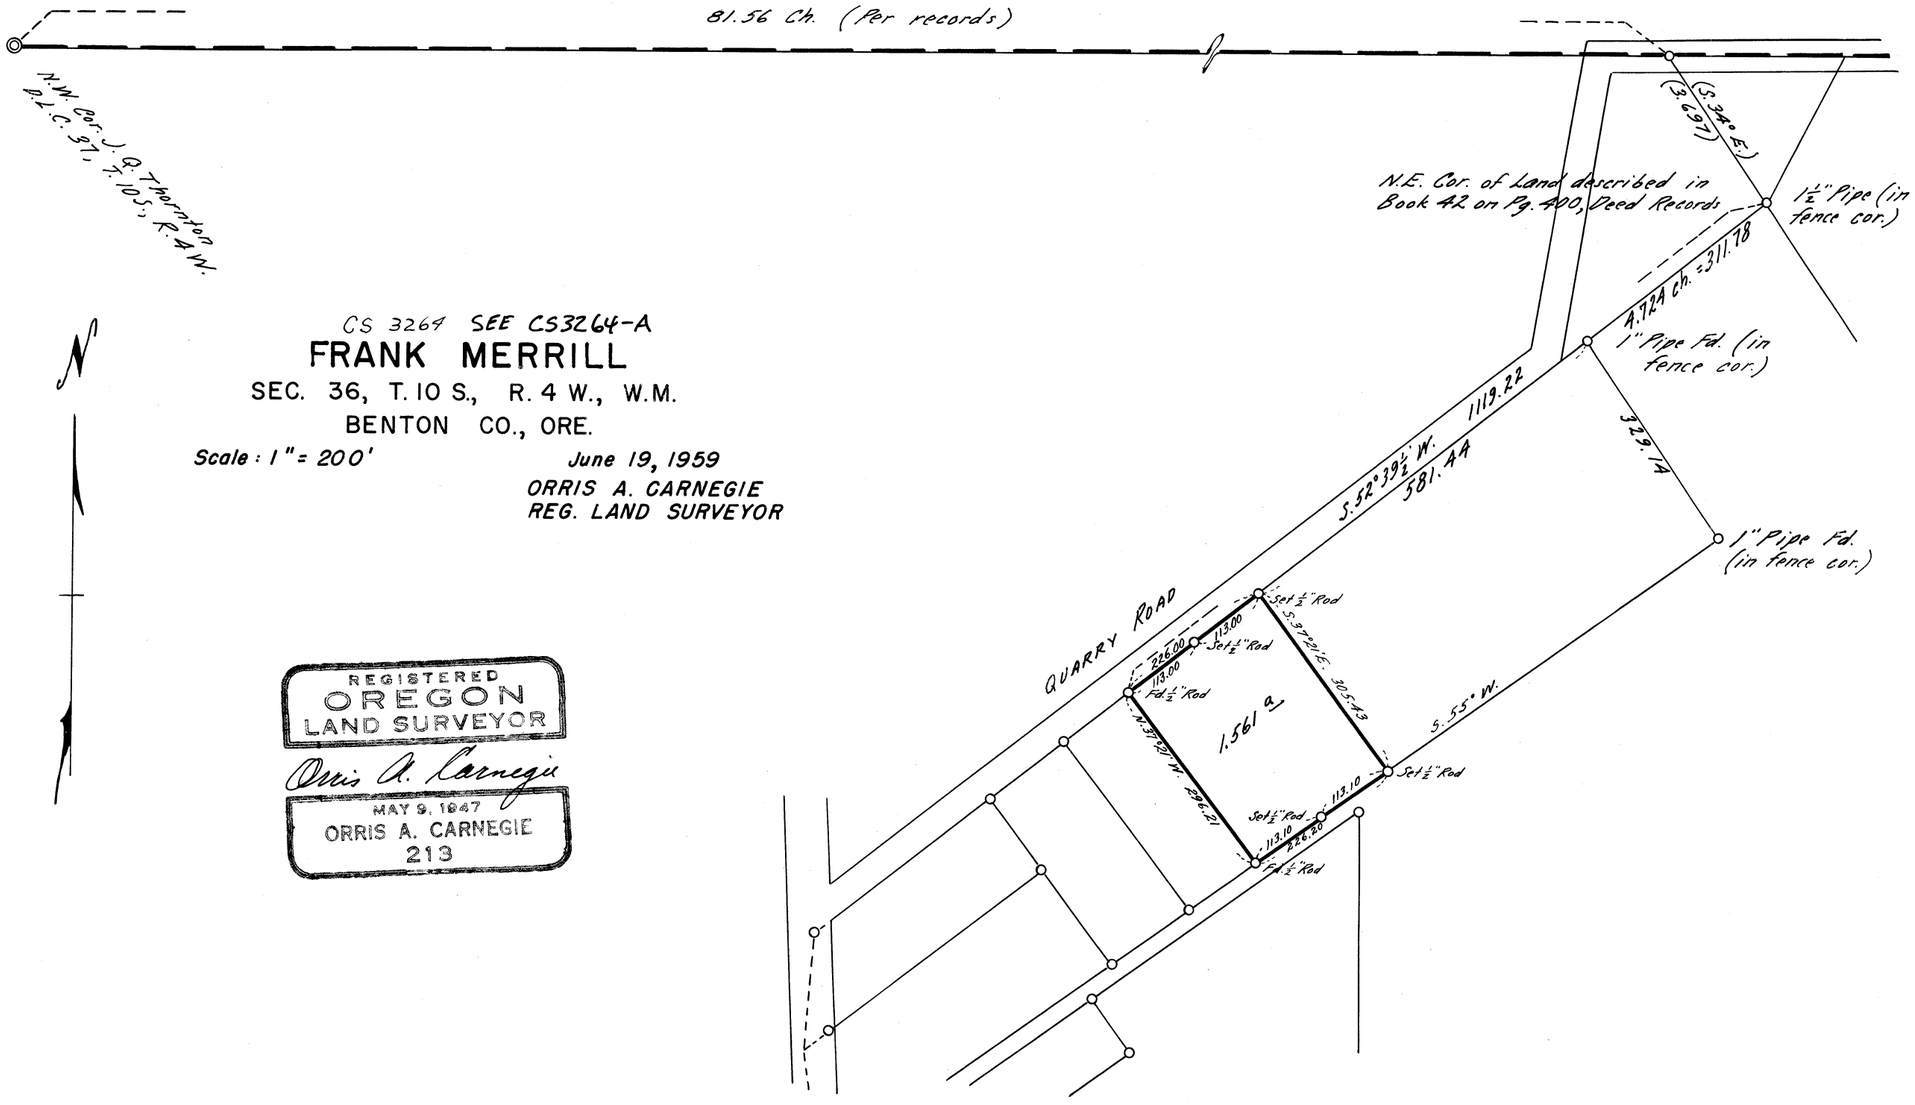

CS 3269 SEE CS3264-A

FRANK MERRILL

SEC. 36, T. 10 S., R. 4 W., W.M.

BENTON CO., ORE.

Scale: 1" = 200'

June 19, 1959

ORRIS A. CARNEGIE
REG. LAND SURVEYOR

REGISTERED
OREGON
LAND SURVEYOR
Orris A. Carnegie
MAY 9, 1947
ORRIS A. CARNEGIE
213

B-48

FRANK MERRILL

SEC. 36, T. 10 S., R. 4 W., W.M.

BENTON CO., ORE.

Scale: 1" = 200'

June 19, 1959

CS 3264-A

ORRIS A. CARNEGIE
REG. LAND SURVEYOR
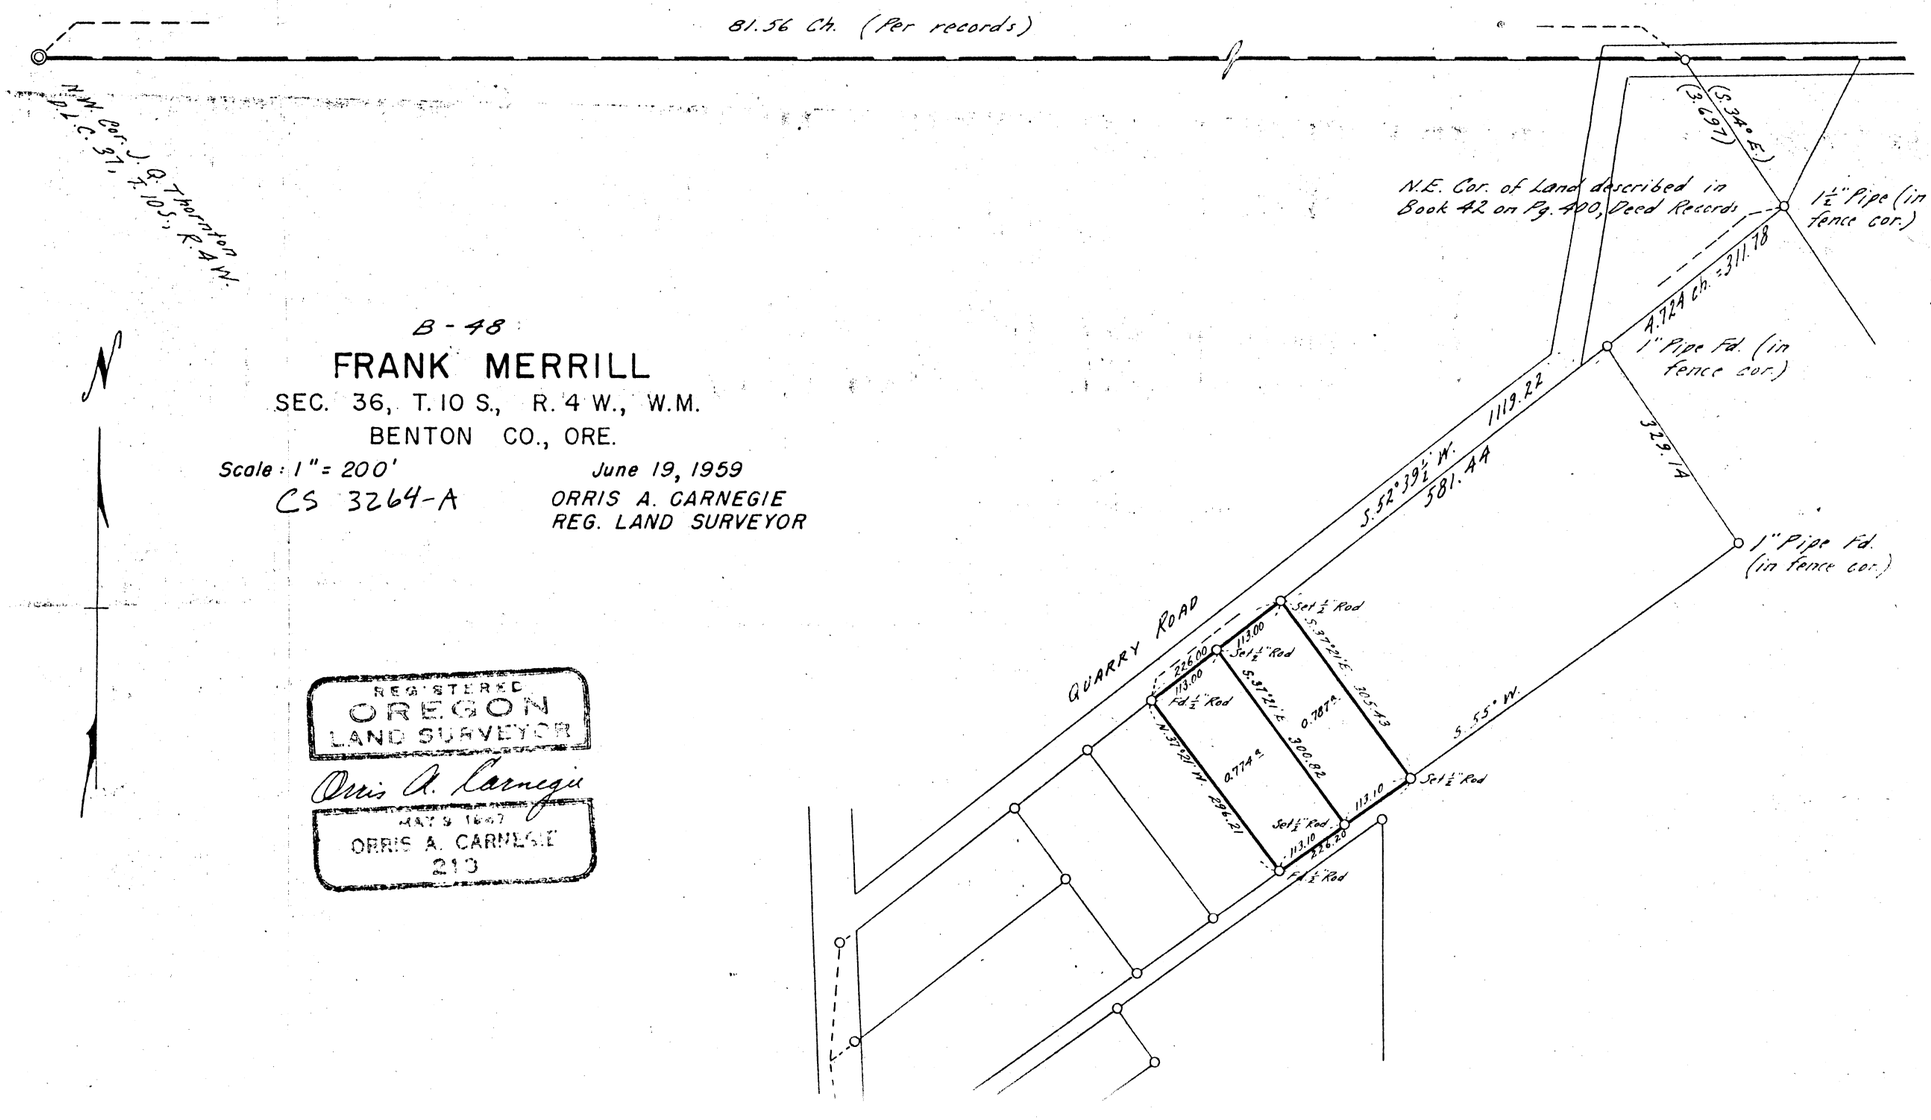
REGISTERED
OREGON
LAND SURVEYOR
Orris A. Carnegie
MAY 9 1967
ORRIS A. CARNEGIE
213