CS 3293

VOLNEY VOLKER

SECTION 13, T.14S. R.5W., W.M.

SEPTEMBER 23, 1959

REGISTERED
OREGON
LAND SURVEYOR

Curtis C. Hanson

NOVEMBER 9, 1945
CURTIS C. HANSON
161
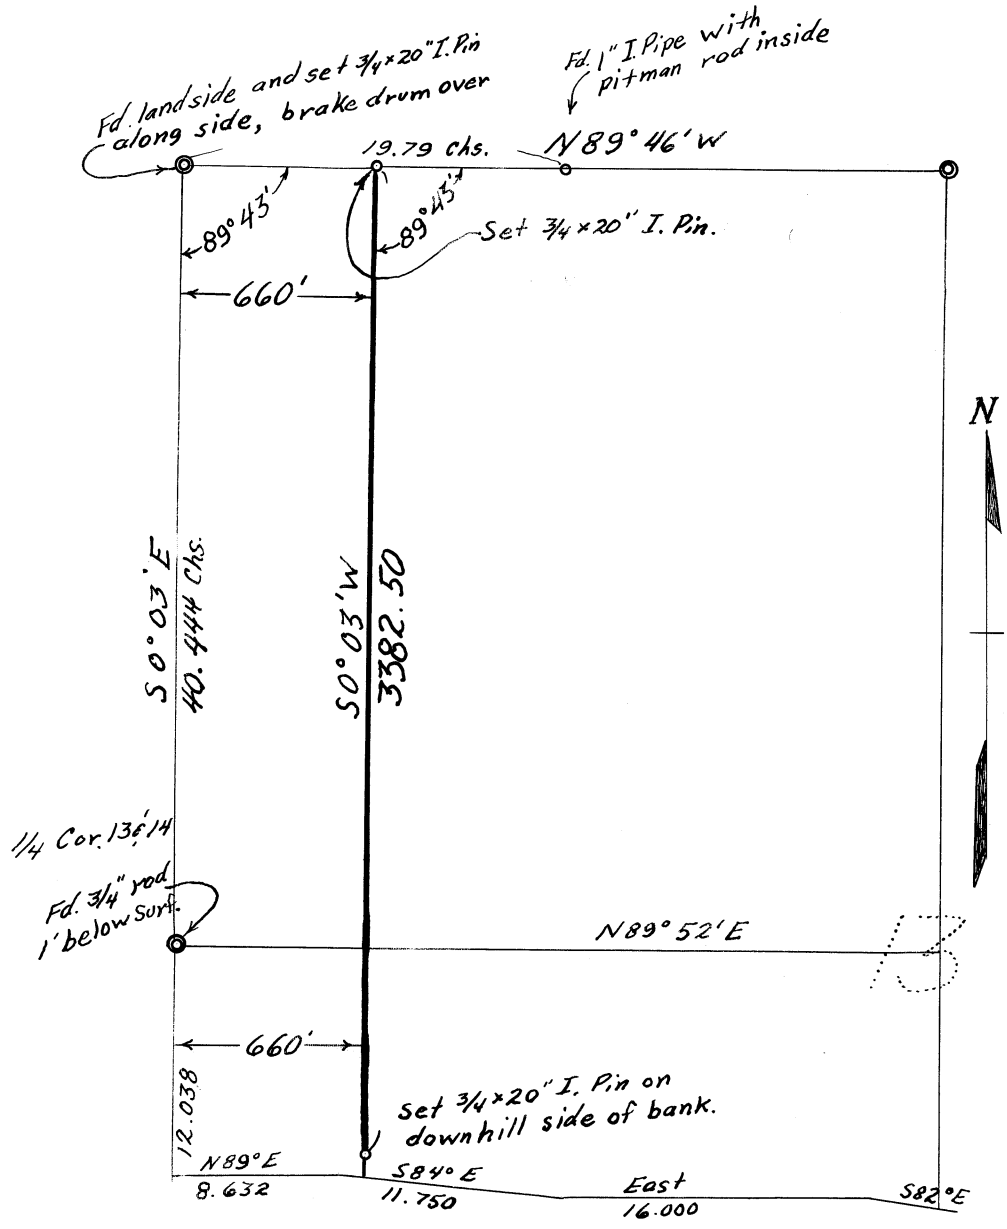
Scale 1" = 10 Chains, or 660 Feet