CS 3301
MIDLAND BROADCASTING
Heman C. Lewis DLC #47
Sec. 24, T. 11 S., R. 5 W.
Scale 1" = 100' October 22, 1959

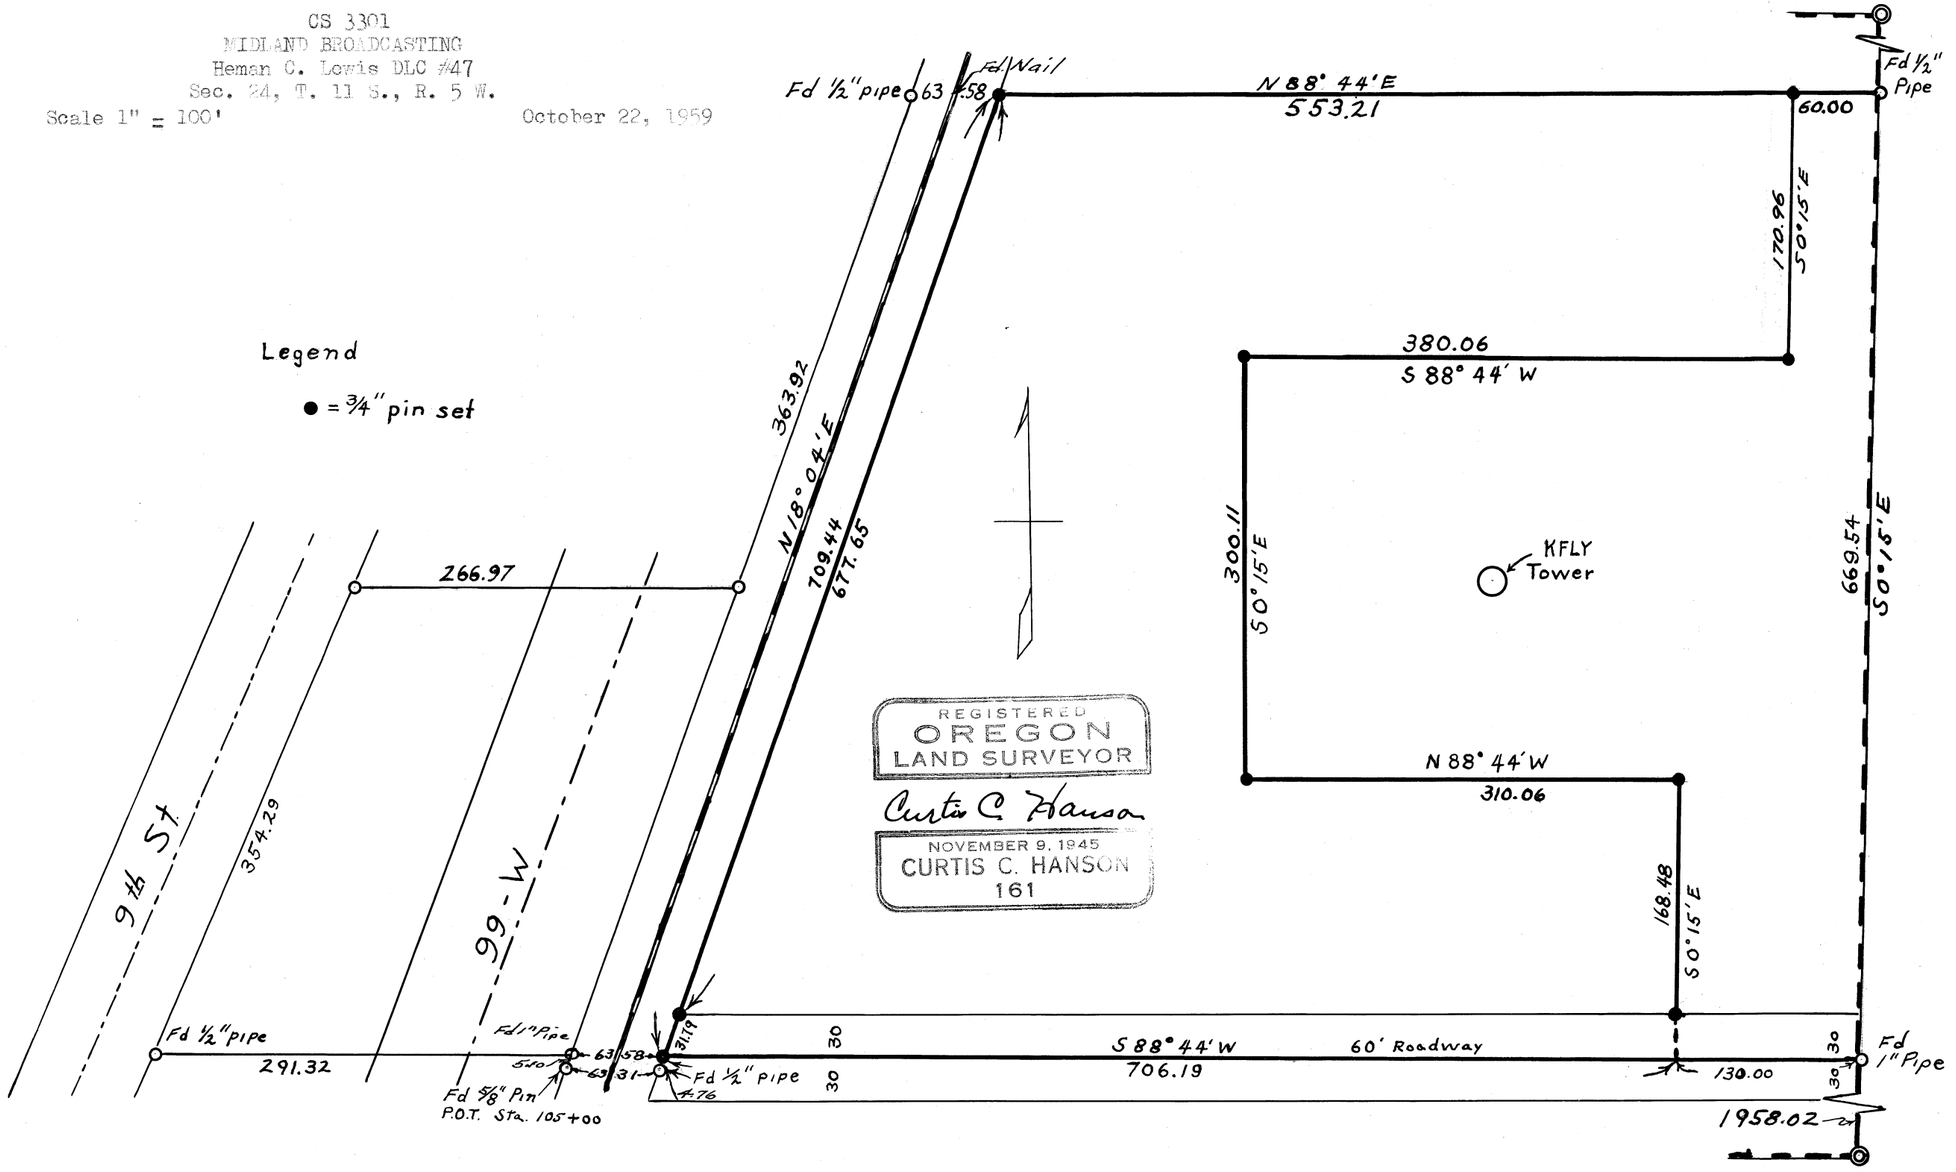

REGISTERED
OREGON
LAND SURVEYOR
Curtis C. Hanson
NOVEMBER 9, 1945
CURTIS C. HANSON
161