C. S. 3401

VERN HAYES

SEC 36, T10S, R4W

BENTON COUNTY

SCALE 1"=100' AUG, 1960

Refer: C.S. 3178

REGISTERED OREGON LAND SURVEYOR

B. Osburn Shaw

OCTOBER 4, 1957

B. OSBURN SHAW
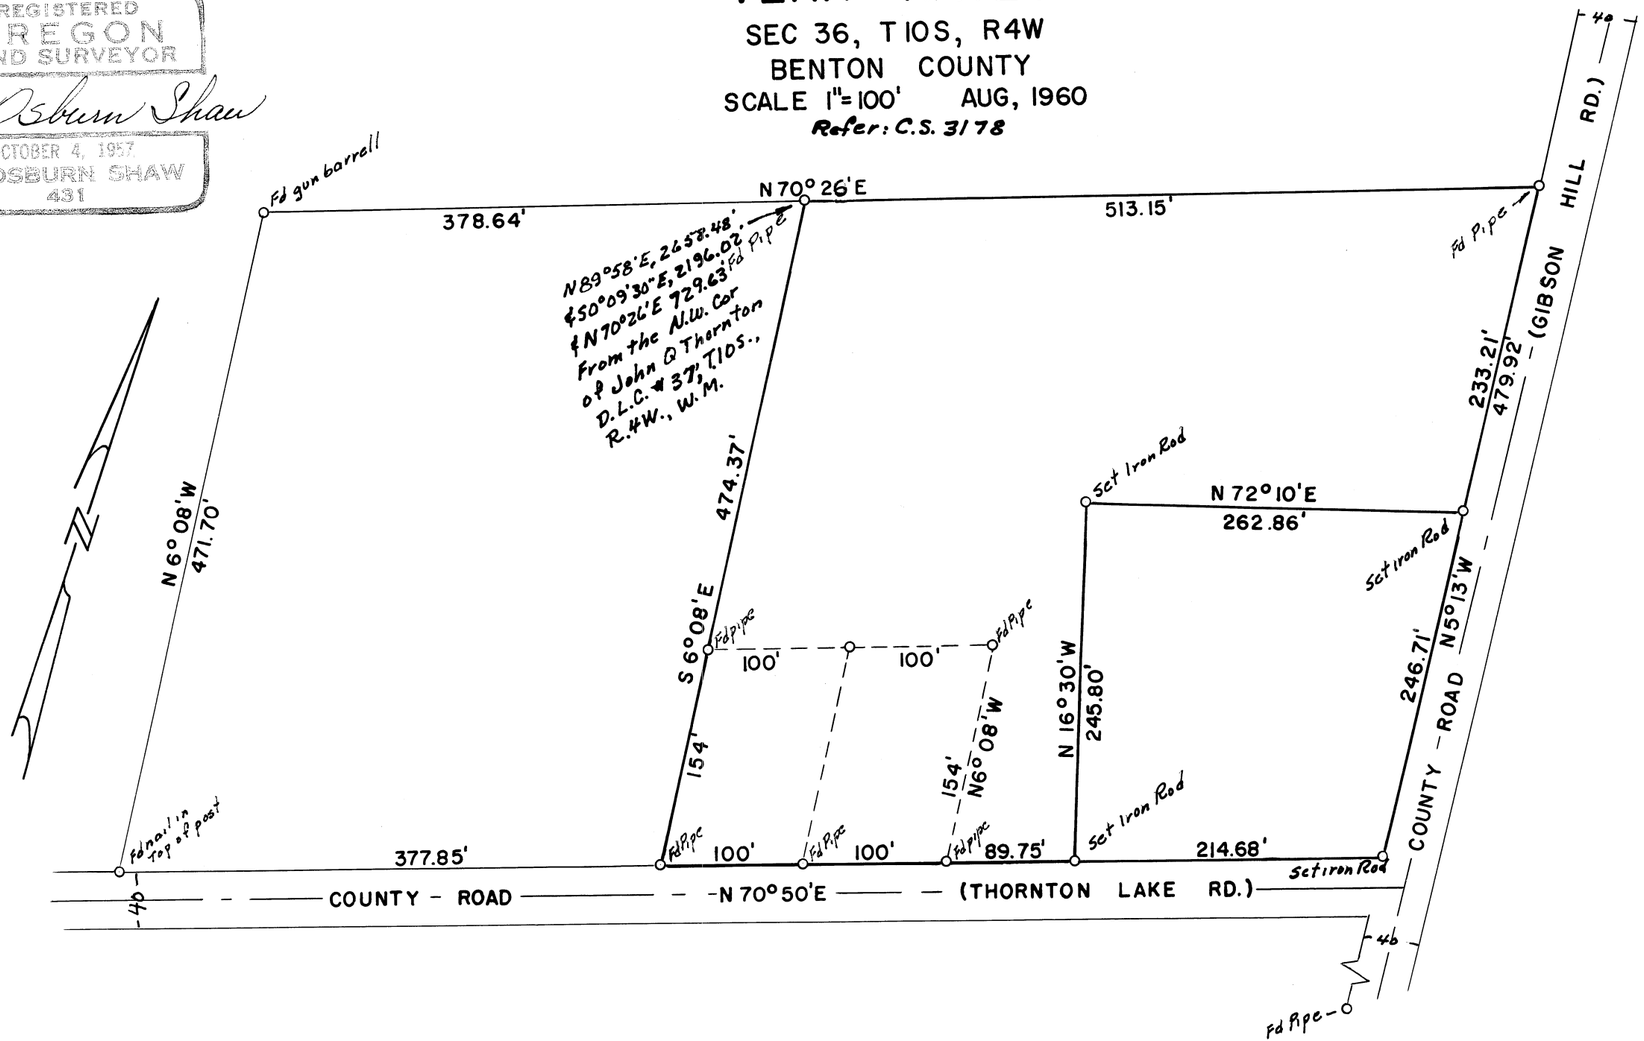
431