C.S. 3415
Lew Murray
J.Q. Thornton D.L.C. N° 37
T 10 S., R 4 W., W.B.M.
Surveyed Sept. 10, 1960
Scale 1" = 50'

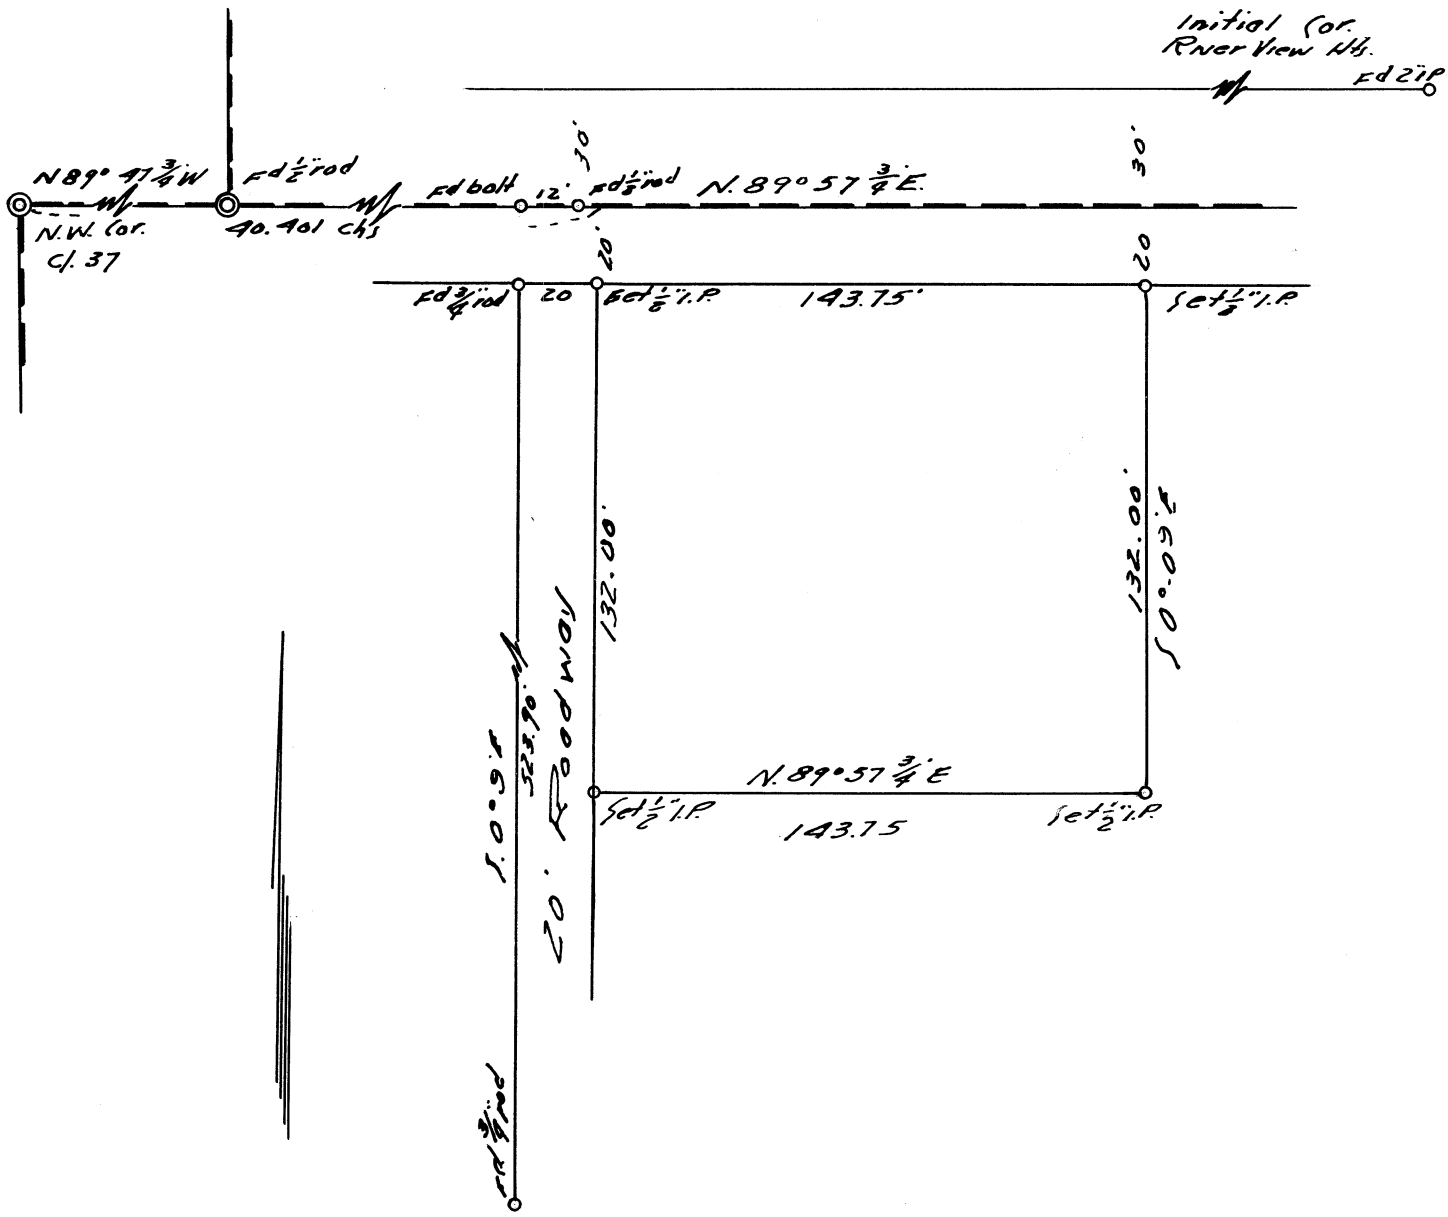

REGISTERED
OREGON
LAND SURVEYOR

Richard W. Fail

NOV. 4, 1958
RICHARD W. FAIL
357