3780

C.S. 3750

SURVEY FOR BRUCE STARKER

BLOCK 4, CEDAR HURST SUBD.
F.A. HORNING DLC T11S, R5W, W.M.
SCALE 1"=50' APRIL 1962

Meridian from west line of subd.
● denotes monuments found
○ " " set (1. rod)

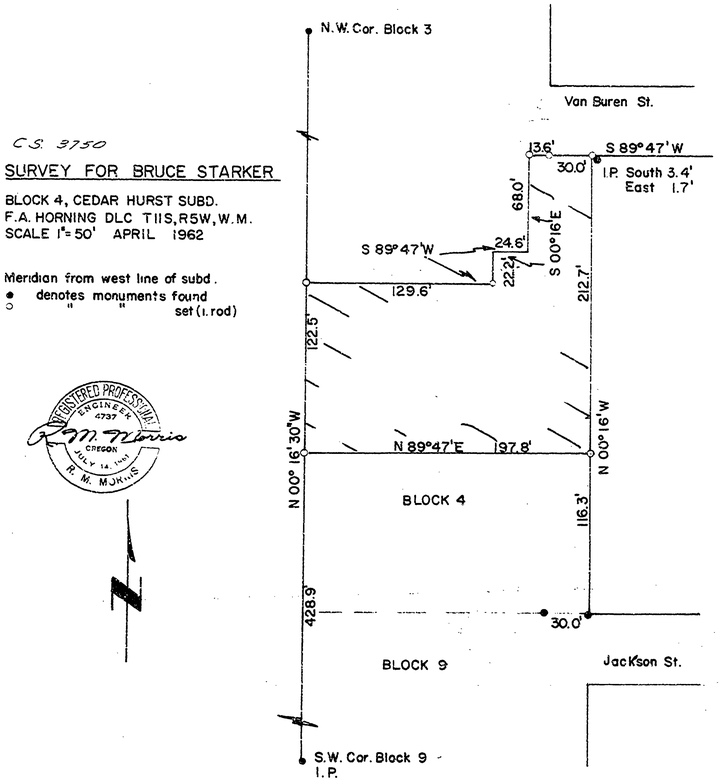


REGISTERED PROFESSIONAL ENGINEER 4737 OREGON JULY 14 1961 R. M. MORRIS

3780

3750