C.S. 3888

SURVEY FOR
DEAN HARDENBURGER
VILLE de JARDINS

Lot 7 & 8 Block 1 in Highland Lawn Acres

BENTON COUNTY, OREGON

SCALE: 1" = 20' Feb. 2, 1964

1

REGISTERED
OREGON
LAND SURVEYOR

Fred I. Lemke
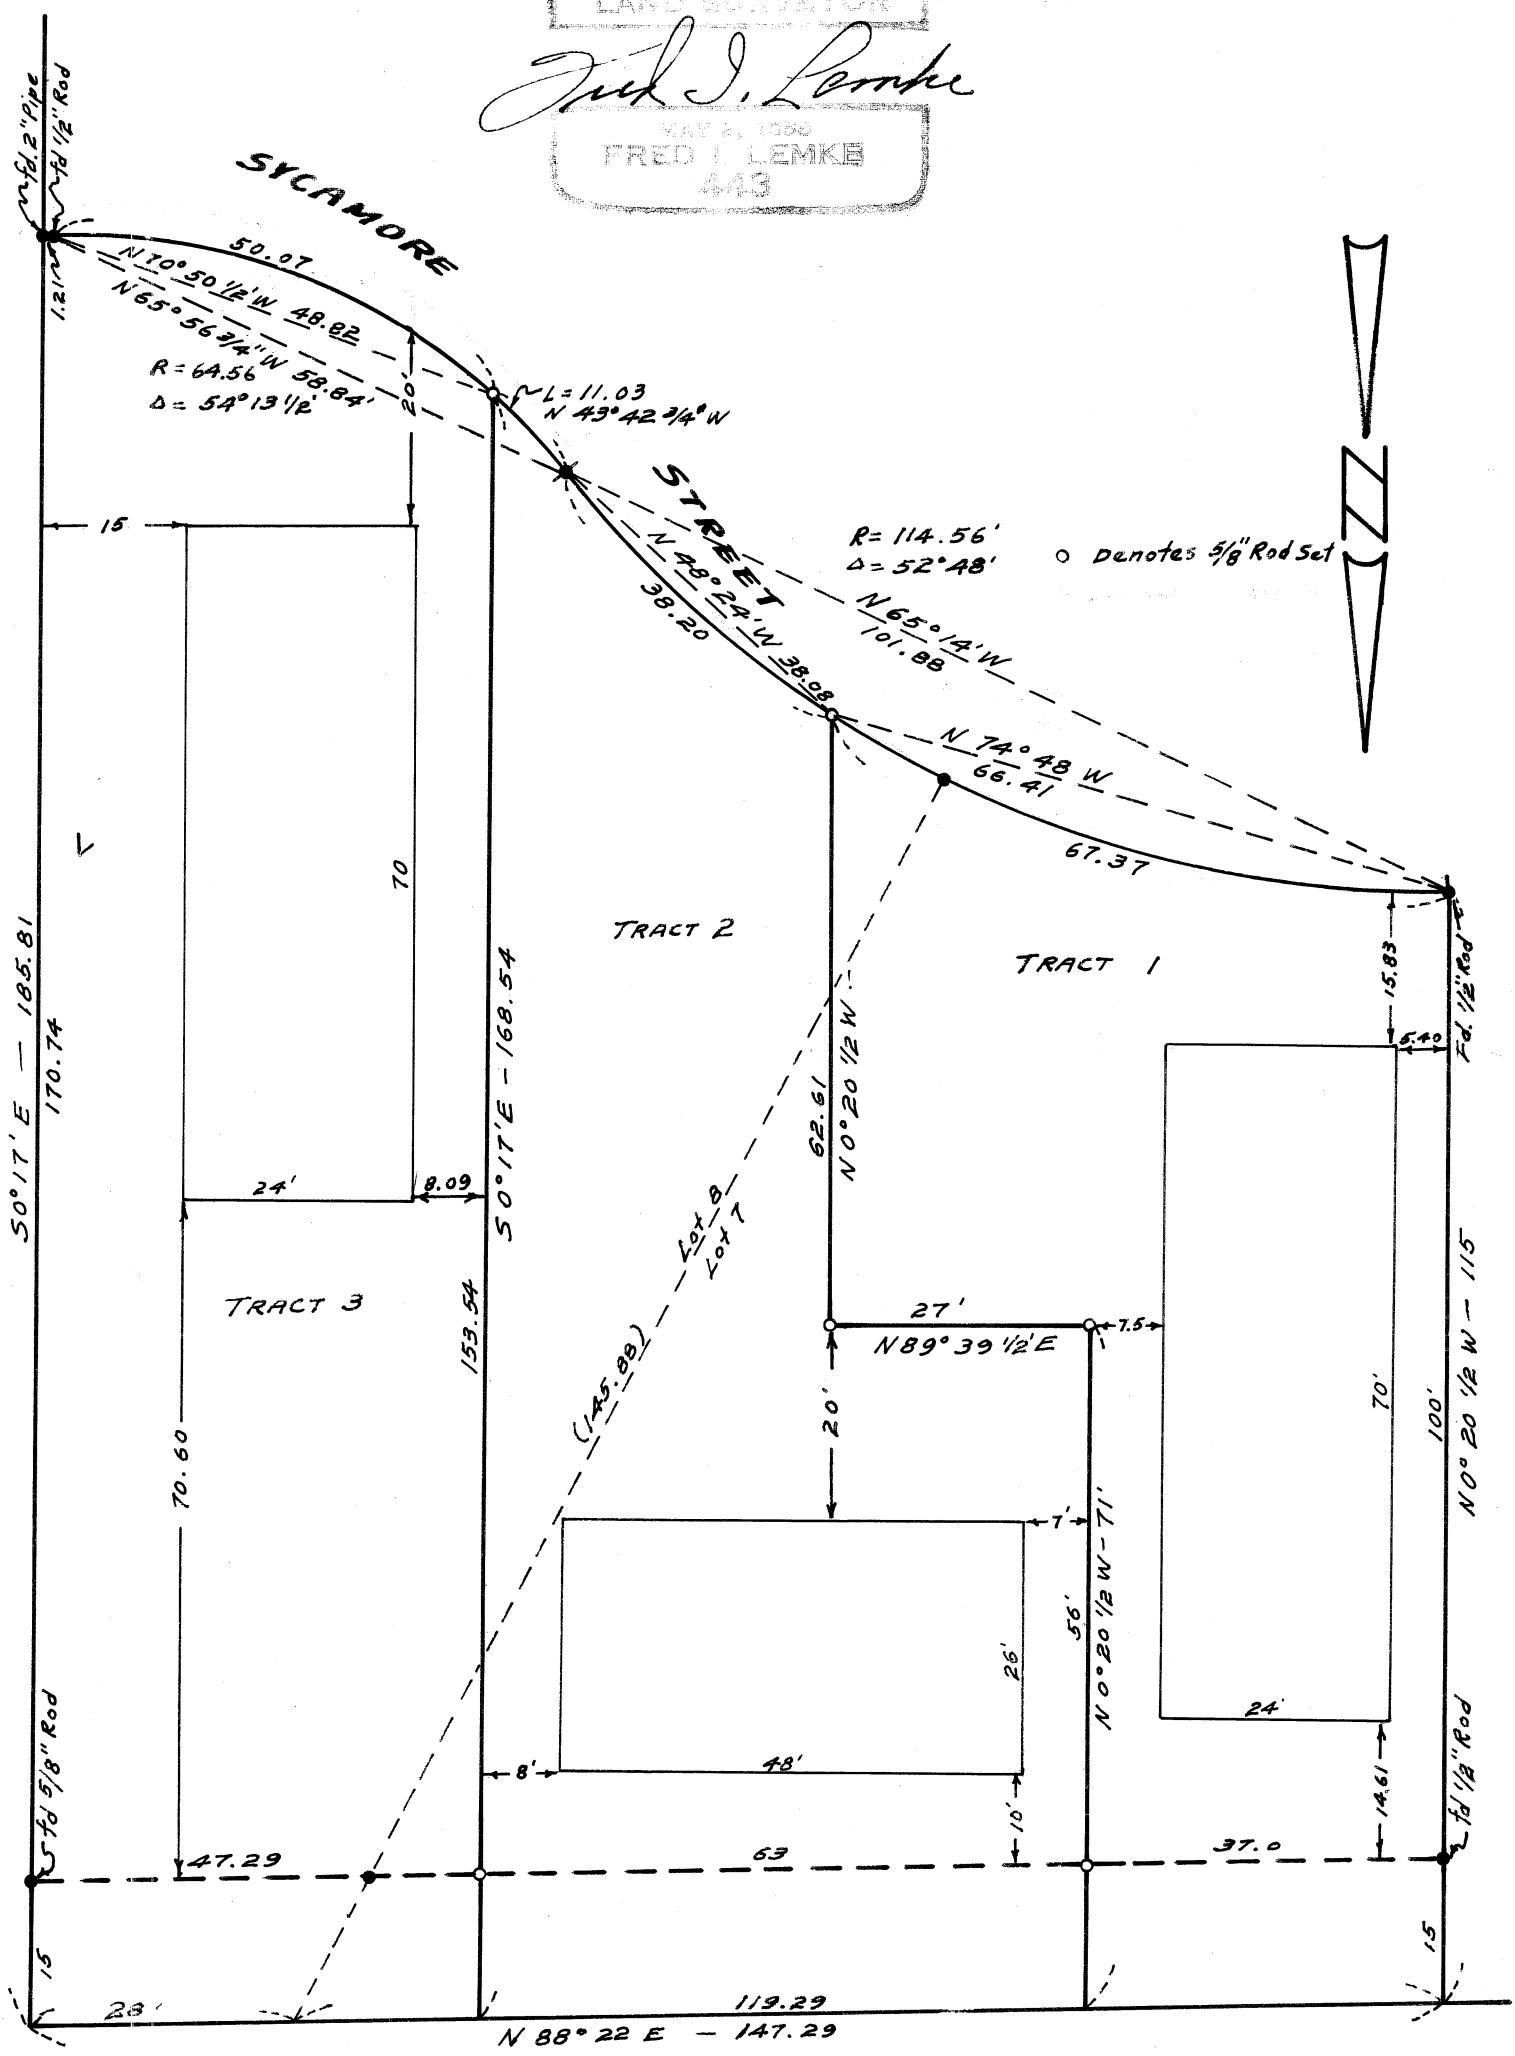
MAY 6, 1966
FRED I. LEMKE
4413